

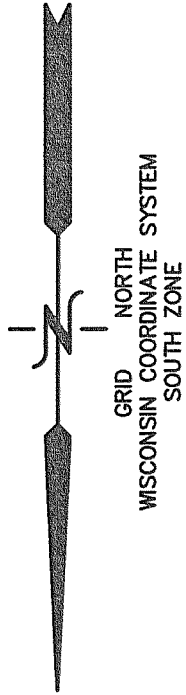


PLAT OF SURVEY




REC. IN VOL. 20 OF CERTIFIED SURVEY MAPS ON PG. 27 AS DOC. NO. 538776
LOT 2 OF CERTIFIED SURVEY MAP NO. 3518
LOCATED IN PART OF THE NE 1/4 OF THE SW 1/4 AND THE SE 1/4 OF THE NE 1/4 OF
SECTION 9, TOWN 1 NORTH, RANGE 17 EAST, TOWN OF LINN, WALWORTH COUNTY, WISCONSIN

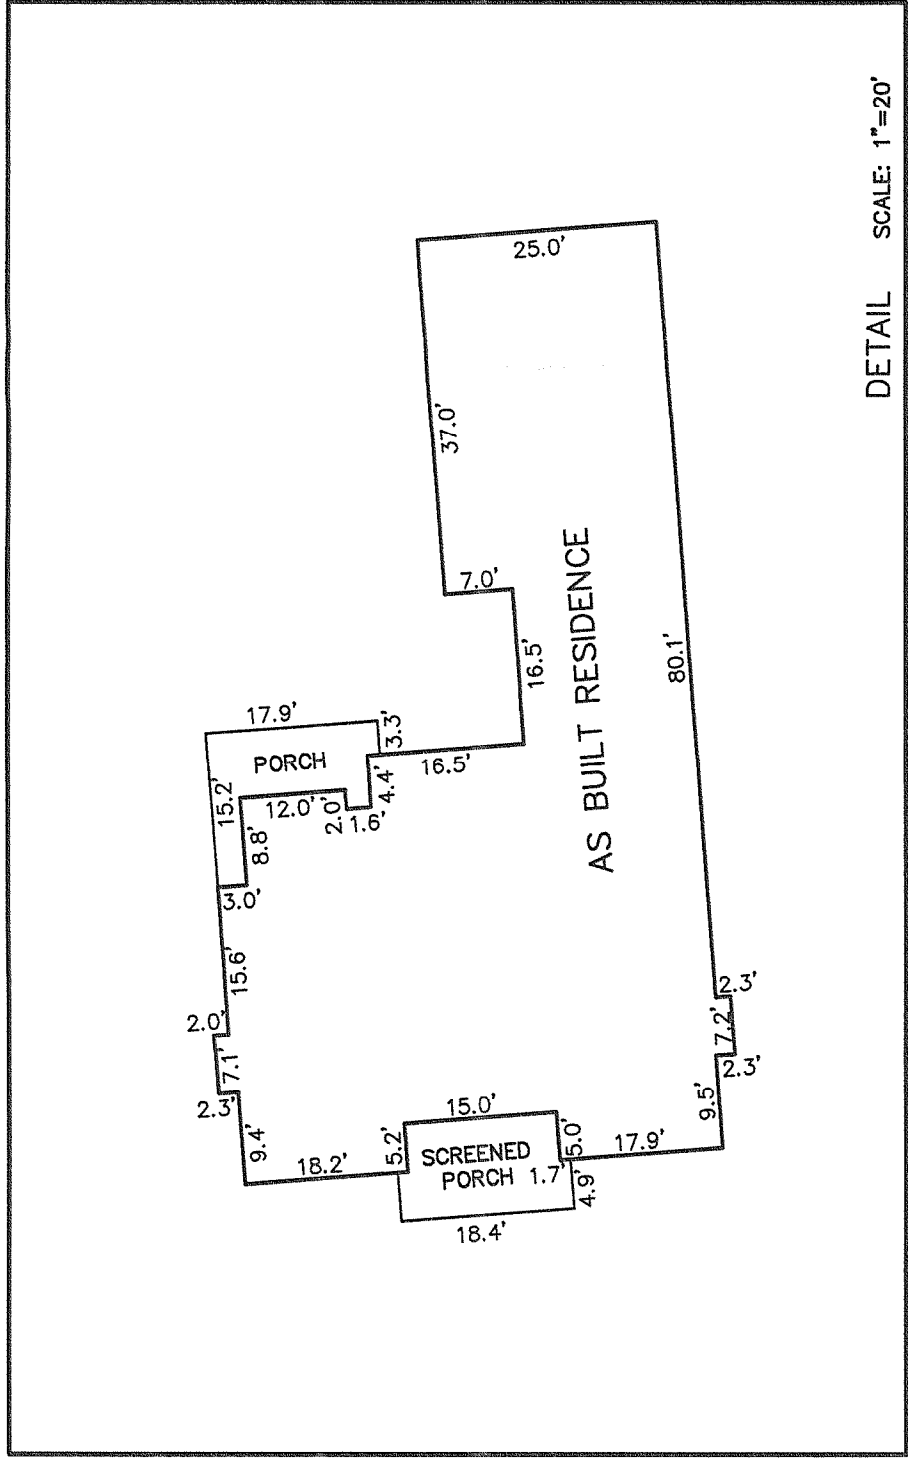

LINE	BEARING	DISTANCE
1	N 87°47'59" W	10.00'

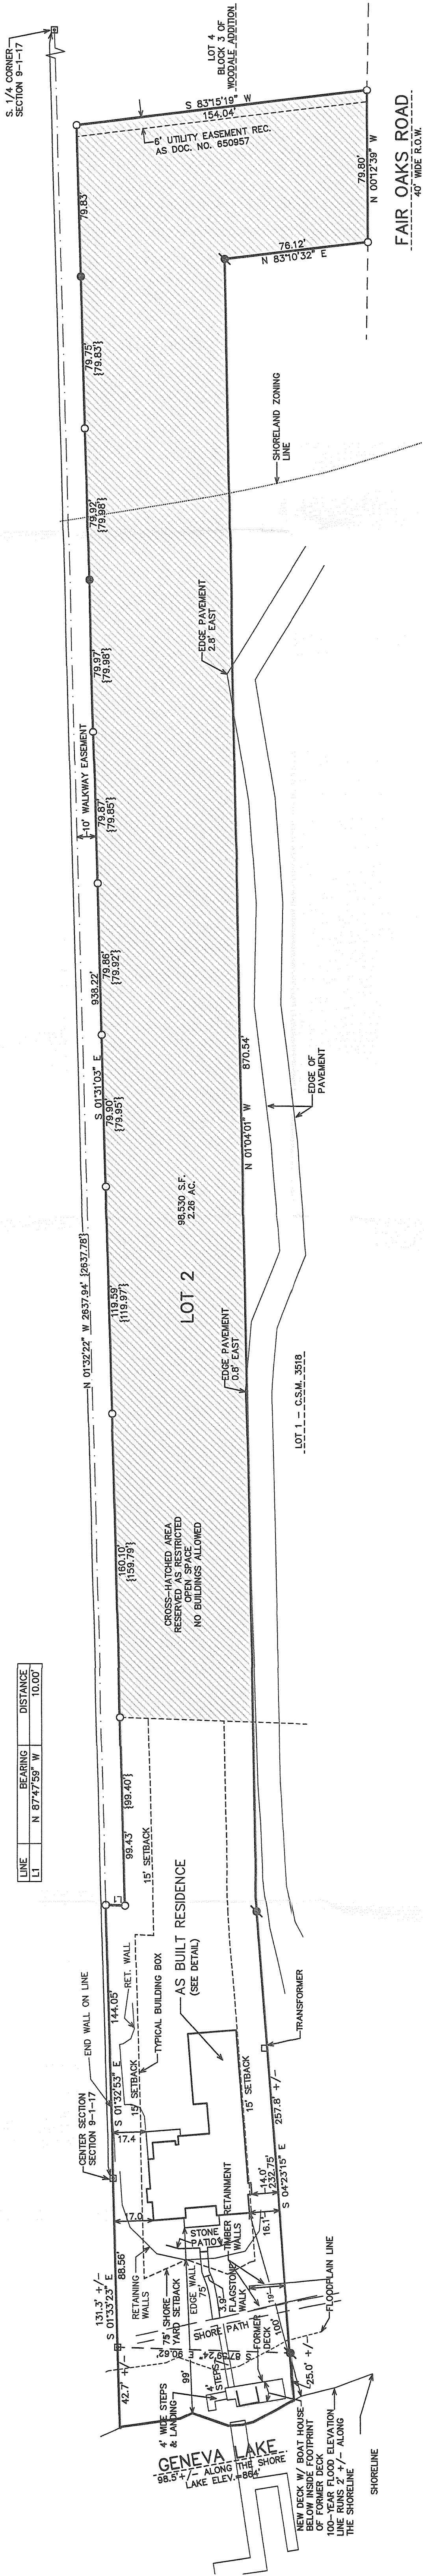

- LEGEND
- = FOUND IRON PIPE STAKE
 - = FOUND IRON REBAR STAKE
 - ⌘ = SET IRON REBAR STAKE
 - BI = FOUND CONCRETE COUNTY MONUMENT
 - (XX) = RECORDED AS

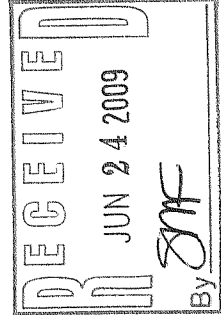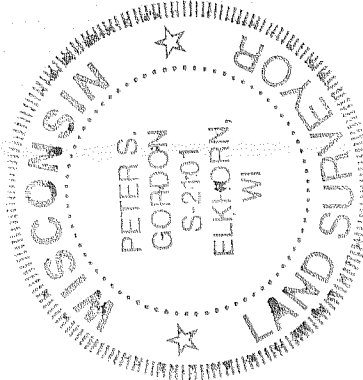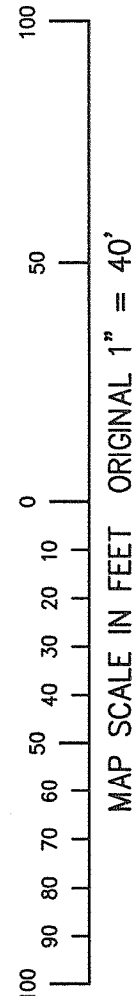

NOTES: COPIES OF THIS MAP TO WHICH THE FOLLOWING CERTIFICATE WILL APPLY, SHOW THE SAME TO BE A TRUE AND CORRECT REPRESENTATION OF THE SURVEYED PROPERTY, AND THAT THE SAME HAS BEEN RECORDED IN THE PUBLIC RECORDS OF THE COUNTY OF WALWORTH, WISCONSIN, AND THAT THE SAME IS A TRUE AND CORRECT REPRESENTATION OF THE SURVEYED PROPERTY, AND THAT THE SAME IS A TRUE AND CORRECT REPRESENTATION OF THE SURVEYED PROPERTY, AND THAT THE SAME IS A TRUE AND CORRECT REPRESENTATION OF THE SURVEYED PROPERTY.

I HEREBY CERTIFY THAT THE ABOVE DESCRIBED PROPERTY HAS BEEN SURVEYED UNDER MY DIRECTION AND THAT THE ABOVE MAP IS A TRUE REPRESENTATION THEREOF, AND THAT THE SAME IS A TRUE REPRESENTATION OF THE SURVEYED PROPERTY, AND THAT THE SAME IS A TRUE REPRESENTATION OF THE SURVEYED PROPERTY, AND THAT THE SAME IS A TRUE REPRESENTATION OF THE SURVEYED PROPERTY.

DATED: FEBRUARY 9, 2007

REVISOR: 07-22-2008
TO SHOW SIZE AND LOCATION OF
AS BUILT STRUCTURES
REVISOR: 11-12-2008
ADD RETAINING WALLS
AS BUILT

PETER S. GORDON

7-25-18-2