


LINN PIER ROAD

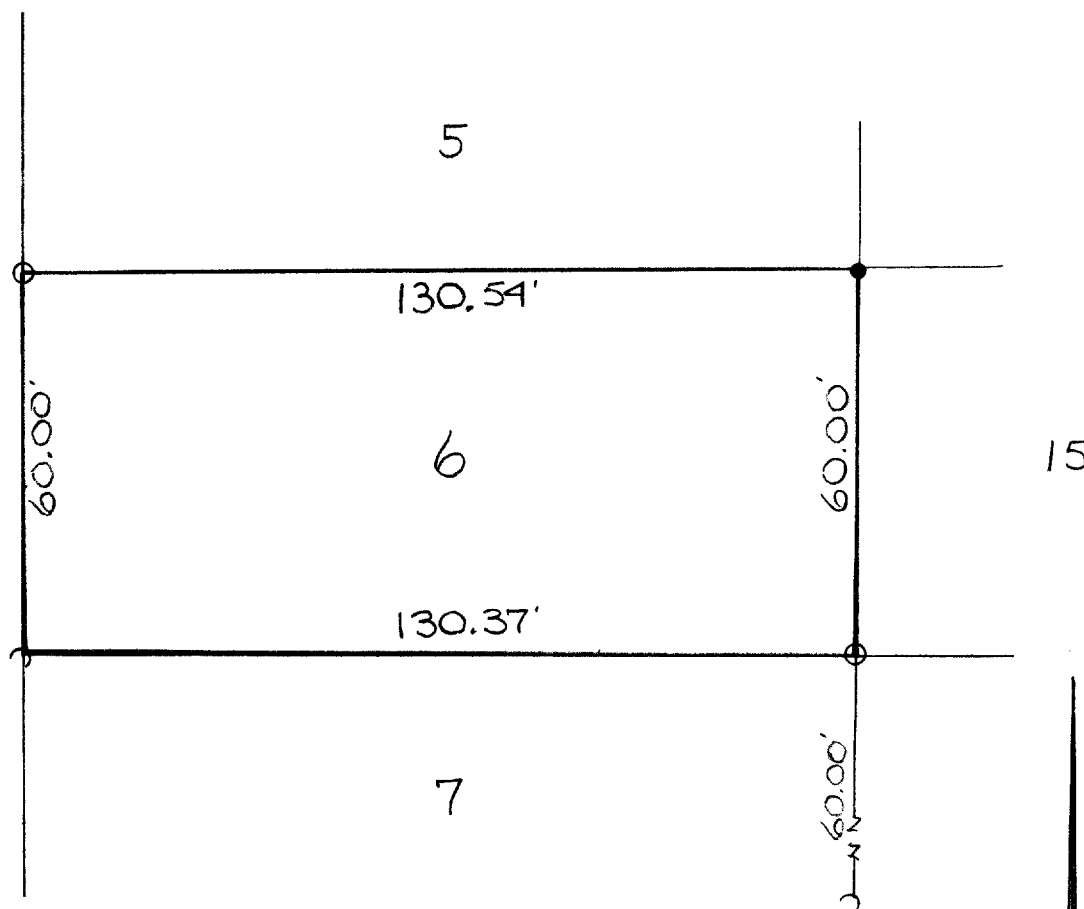

- - INDICATES IRON PIPE FOUND
- - INDICATES IRON TUBULAR SECTION FOUND
- - INDICATES IRON PIPE SET

DESCRIPTION:

A parcel of land described as follows to-wit; All of lot #6 of The Birches 2nd Addition, located in the NW $\frac{1}{4}$ of Section 10, T.1N., R.17E., Walworth County, Wisconsin.

CERTIFICATE:

I, James F. Biagi, surveyor, do hereby certify that I have surveyed the lands hereon described.

DATE:

August 14, 1972

James F. Biagi
James F. Biagi

RLS #272

