

TOWN ROAD

1/4 SEC LN

C.T.R. SEC 4
T. 1 N., R. 17 E

N.W. CORNER OF LOT #7
S.B. CHAPINS SUBD.

1/4 SEC LN
No. LN. PLATTED ROADWAY
4025' RADIUS & 1°25' D

N.W. CORNER OF
LOT #8

89°42' ROADWAY AS PLATTED
25' R.O.W.
S.W. H. HILLS DESCRIPTION
S 74°36' E 124.10'

SOUTH LN. OF PLATTED ROADWAY



No. LN. EXISTING RD.

EXISTING TRAVELED
CHORD OF EXISTING RD.
APPROX 14' WIDE

RESIDENCE
(FOUNDATION hash marked)

DESCRIPTION: Plat of survey showing the location of the house on the North 200 feet of Lot #7 South of roadway (as measured along the West line) and a portion of Lot #8 in S.B. Chapins Subdivision Sec. 4, T. 1 N., R. 17 E. Walworth County, Wisc.

CERTIFICATE: I, James F. Biagi, surveyor, do hereby certify that I have surveyed the property hereon described, and that the location of the improvements are as shown on the plat above.

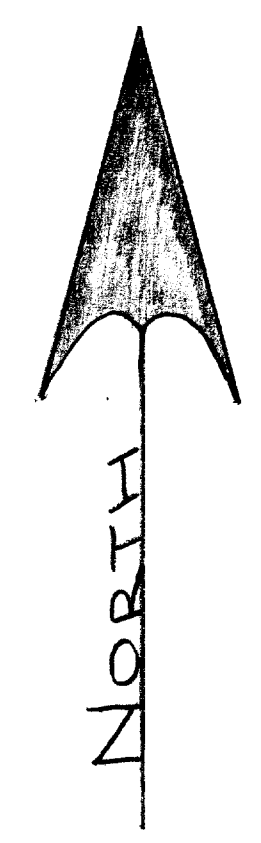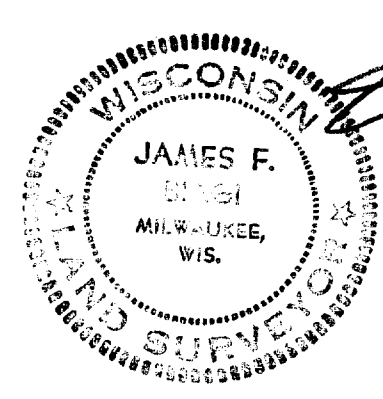

O-INDICATES IRON PIPE
O-INDICATES CONC. MON.
SCALE: 1" = 10'-0"

IC H-2A4, 2B