

**PART OF LOTS 11 AND 12 OF
CHAPINS SUBDIVISION, LOCATED IN
THE SOUTHEAST 1/4 OF SECTION 4,
TOWN 1 NORTH, RANGE 17 EAST,
TOWN OF LINN, WALWORTH COUNTY,
WISCONSIN.**

**NW LOT 10
S.B. CHAPINS SUBD.**

**OWNER: DANIEL J. WALSH TRUST
DANIEL J. WALSH TRUSTEE
91 CHAPIN RD.
LAKE GENEVA, WI. 53147**

1 INCH = 10 FEET
LOCATED JULY 26, 2006

75' SHOREYARD SETBACK FROM O.H.W.

AREA IN SHOREYARD SETBACK - 22 SQ. FT.

NORTH 50.00'

WEST 35.00'

COMPUTATION OF AREA OF STRUCTURES IN THE SHOREYARD SETBACK

GARAGE..... 10.0' SQ. FT.
GAZEBO..... 140.0' SQ. FT.
EXISTING POOL..... 22.0' SQ. FT.


172.0 SQ. FT.

TOTAL LENGTH OF CREEK 982'
NO MOW AREA 37.5' X 687'

LEGEND

- | | |
|---|--|
|  | FOUND IRON PIPE |
|  | FOUND IRON ROD |
|  | FOUND COUNTY MONUMENT |
|  | FOUND CONCRETE MONUMENT |
|  | CHISEL CUT IN CONCRETE |
|  | SET IRON ROD, 24" LONG, WEIGHING
1.5 LBS./LINEAL FT., 3/4" DIA. |
| (x x) | RECORDED AS DIMENSION |
|  | EXISTING FENCE |

SCALE: 1" = 30 FEET

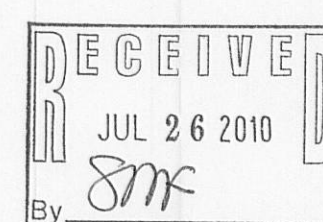

Mark L. Miritz
 MARK L. MIRITZ
 WISCONSIN REGISTERED
 LAND SURVEYOR S-2582
 DATE: MARCH 20, 2006 JOB NO. 04.1102

REVISED AUGUST 24, 2006 TO SHOW POOL, SPA & RESIDENCE ADDITION AS BUILT

ICH-2B2 ICH-2B3

117-3217