PREPARED FOR: JOSEPH LISENBY 400 S. EDWARDS BLVD. NO. 193 LAKE GENEVA, WI

PLAT OF SURVEY

- OF -

KROTT SURVEYING, INC. N3705 WILLOW BEND LANE LAKE GENEVA, WI 53147 (262)- 248-3697


LOTS 30 AND 31 BLOCK 1 OF ROBINSON'S HILLSIDE SUBDIVISION, LOCATED IN SECTION 14, T.1.N., R.17.E., TOWN OF LINN, WALWORTH COUNTY, WISCONSIN.


visible encroachments. if any.

warrant the accuracy of said survey map.

This survey is made for the exclusive use of the present owners of

the property, and also those who puchase, mortgage, or insure the title therto within one (1) year from date hereof; and as to them I

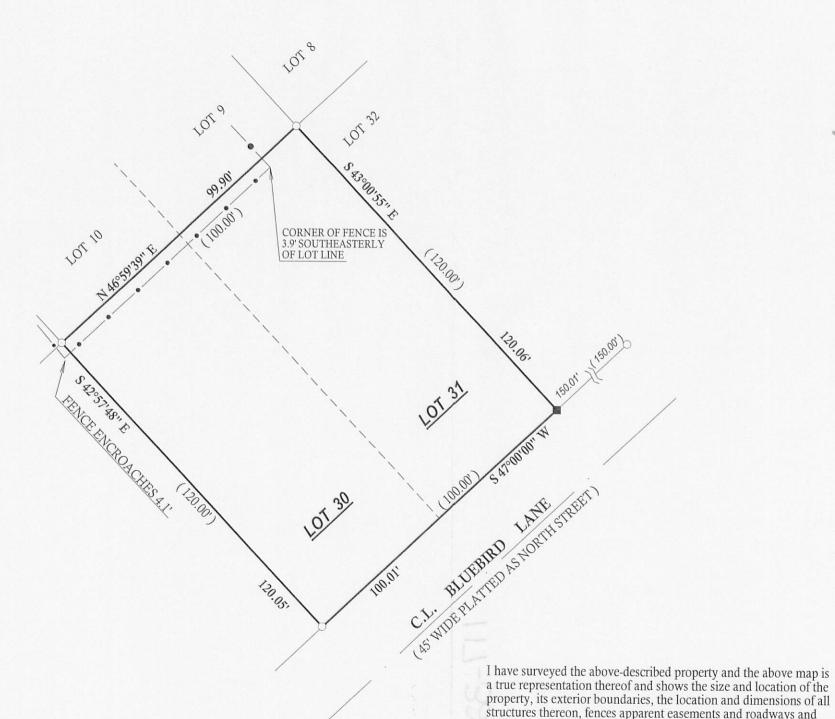

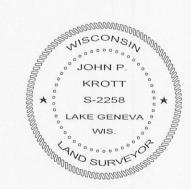

DATED THIS 26th, DAY OF JULY, 2010

JOHN KROTT S - 2258 Wisconsin Registered Land Surveyor (original if signed in red)

()= recorded as

 \Box = found iron bar = found iron pipe

= set iron pipe

= set iron bar

SCALE 1" = 30'

JOB # 07-202UD

TAX ID # IRH00003B1 A