

RECEIVED
APR 25 2011
By *gmf*

$$=OF=$$

KROTT SURVEYING INC.

LOT 17 OF ALTA VISTA ESTATES LOCATED IN GOVERNMENT LOT 1, GOVERNMENT LOT 2 AND IN THE SOUTHEAST 1/4 OF THE NORTHEAST 1/4 OF SECTION 4, TOWN 1 NORTH, RANGE 17 EAST, WALWORTH COUNTY, WISCONSIN.

FENCE IS 0.6' WEST OF LOT CORNER

FENCE IS 0.4' WEST OF LOT CORNER

FENCE IS 0.6' WEST OF LOT CORNER

LOT 16

LOT 17

LOT 18

BRIDGE

CENTERLINE OF DRAINAGE WAY


WOODS

MOWED AREA

ALTA VISTA DRIVE

66' WIDE PLATTED AS BUCANNAN DRIVE

I have surveyed the above-described property and the above map is a true representation thereof and shows the size and location of the property, its exterior boundaries, the location and dimensions of all structures thereon, fences, easements, and other matters shown on the map.

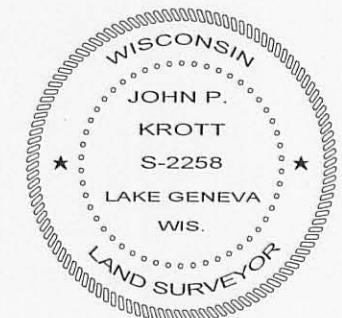

John P. Hoff



JOHN KROTT S-2258
Wisconsin Registered Land Surveyor
(original if signed in red)

S 0°45'29" E 5.64'
(S 0°09' W 5.48')

PLAT OF SURVEY

-OF-

TWO 10 FOOT STRIPS OF LAND DESIGNATED AS
PARCELS 8 AND 9, OF ALTA VISTA ESTATES,
LOCATED IN GOVERNMENT LOT 1, GOVERNMENT
LOT 2 AND IN THE SOUTHEAST 1/4 OF THE
NORTHEAST 1/4 OF SECTION 4, TOWN 1
NORTH, RANGE 17 EAST, WALWORTH COUNTY,
WISCONSIN.

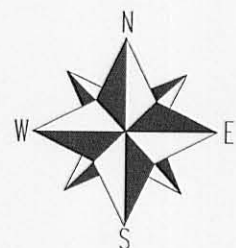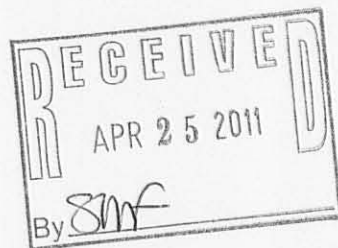

SCALE 1" = 20'




I have surveyed the above-described property and the above map is
a true representation thereof and shows the size and location of the
property, its exterior boundaries, the location and dimensions of all
structures thereon, fences apparent easements and roadways and
visible encroachments, if any.

This survey is made for the exclusive use of the present owners of
the property, and also those who purchase, mortgage, or insure the
title thereto within one (1) year from date hereof, and as to them I
warrant the accuracy of said survey map.

NOTE: BEARINGS ARE REFERENCED TO THE RECORD PLAT.

LEGEND
○ FOUND IRON PIPE
(xx) RECORDED AS
TAX ID # IAV00015
JOB # 11-030A

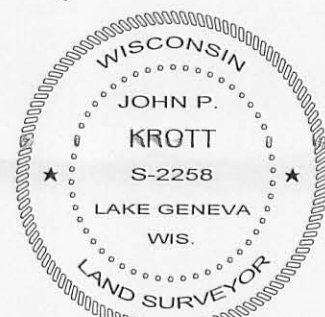

DATED THIS 10th DAY OF MARCH 2011.

JOHN KROTT S - 2258
Wisconsin Registered Land Surveyor
(original if signed in red)

