


PLAT OF SURVEY

-OF-

KROTT SURVEYING INC.

N3705 WILLOW BEND LANE
LAKE GENEVA WI. 53147
PHONE # (262)248-3697
FAX # (262)249-0639

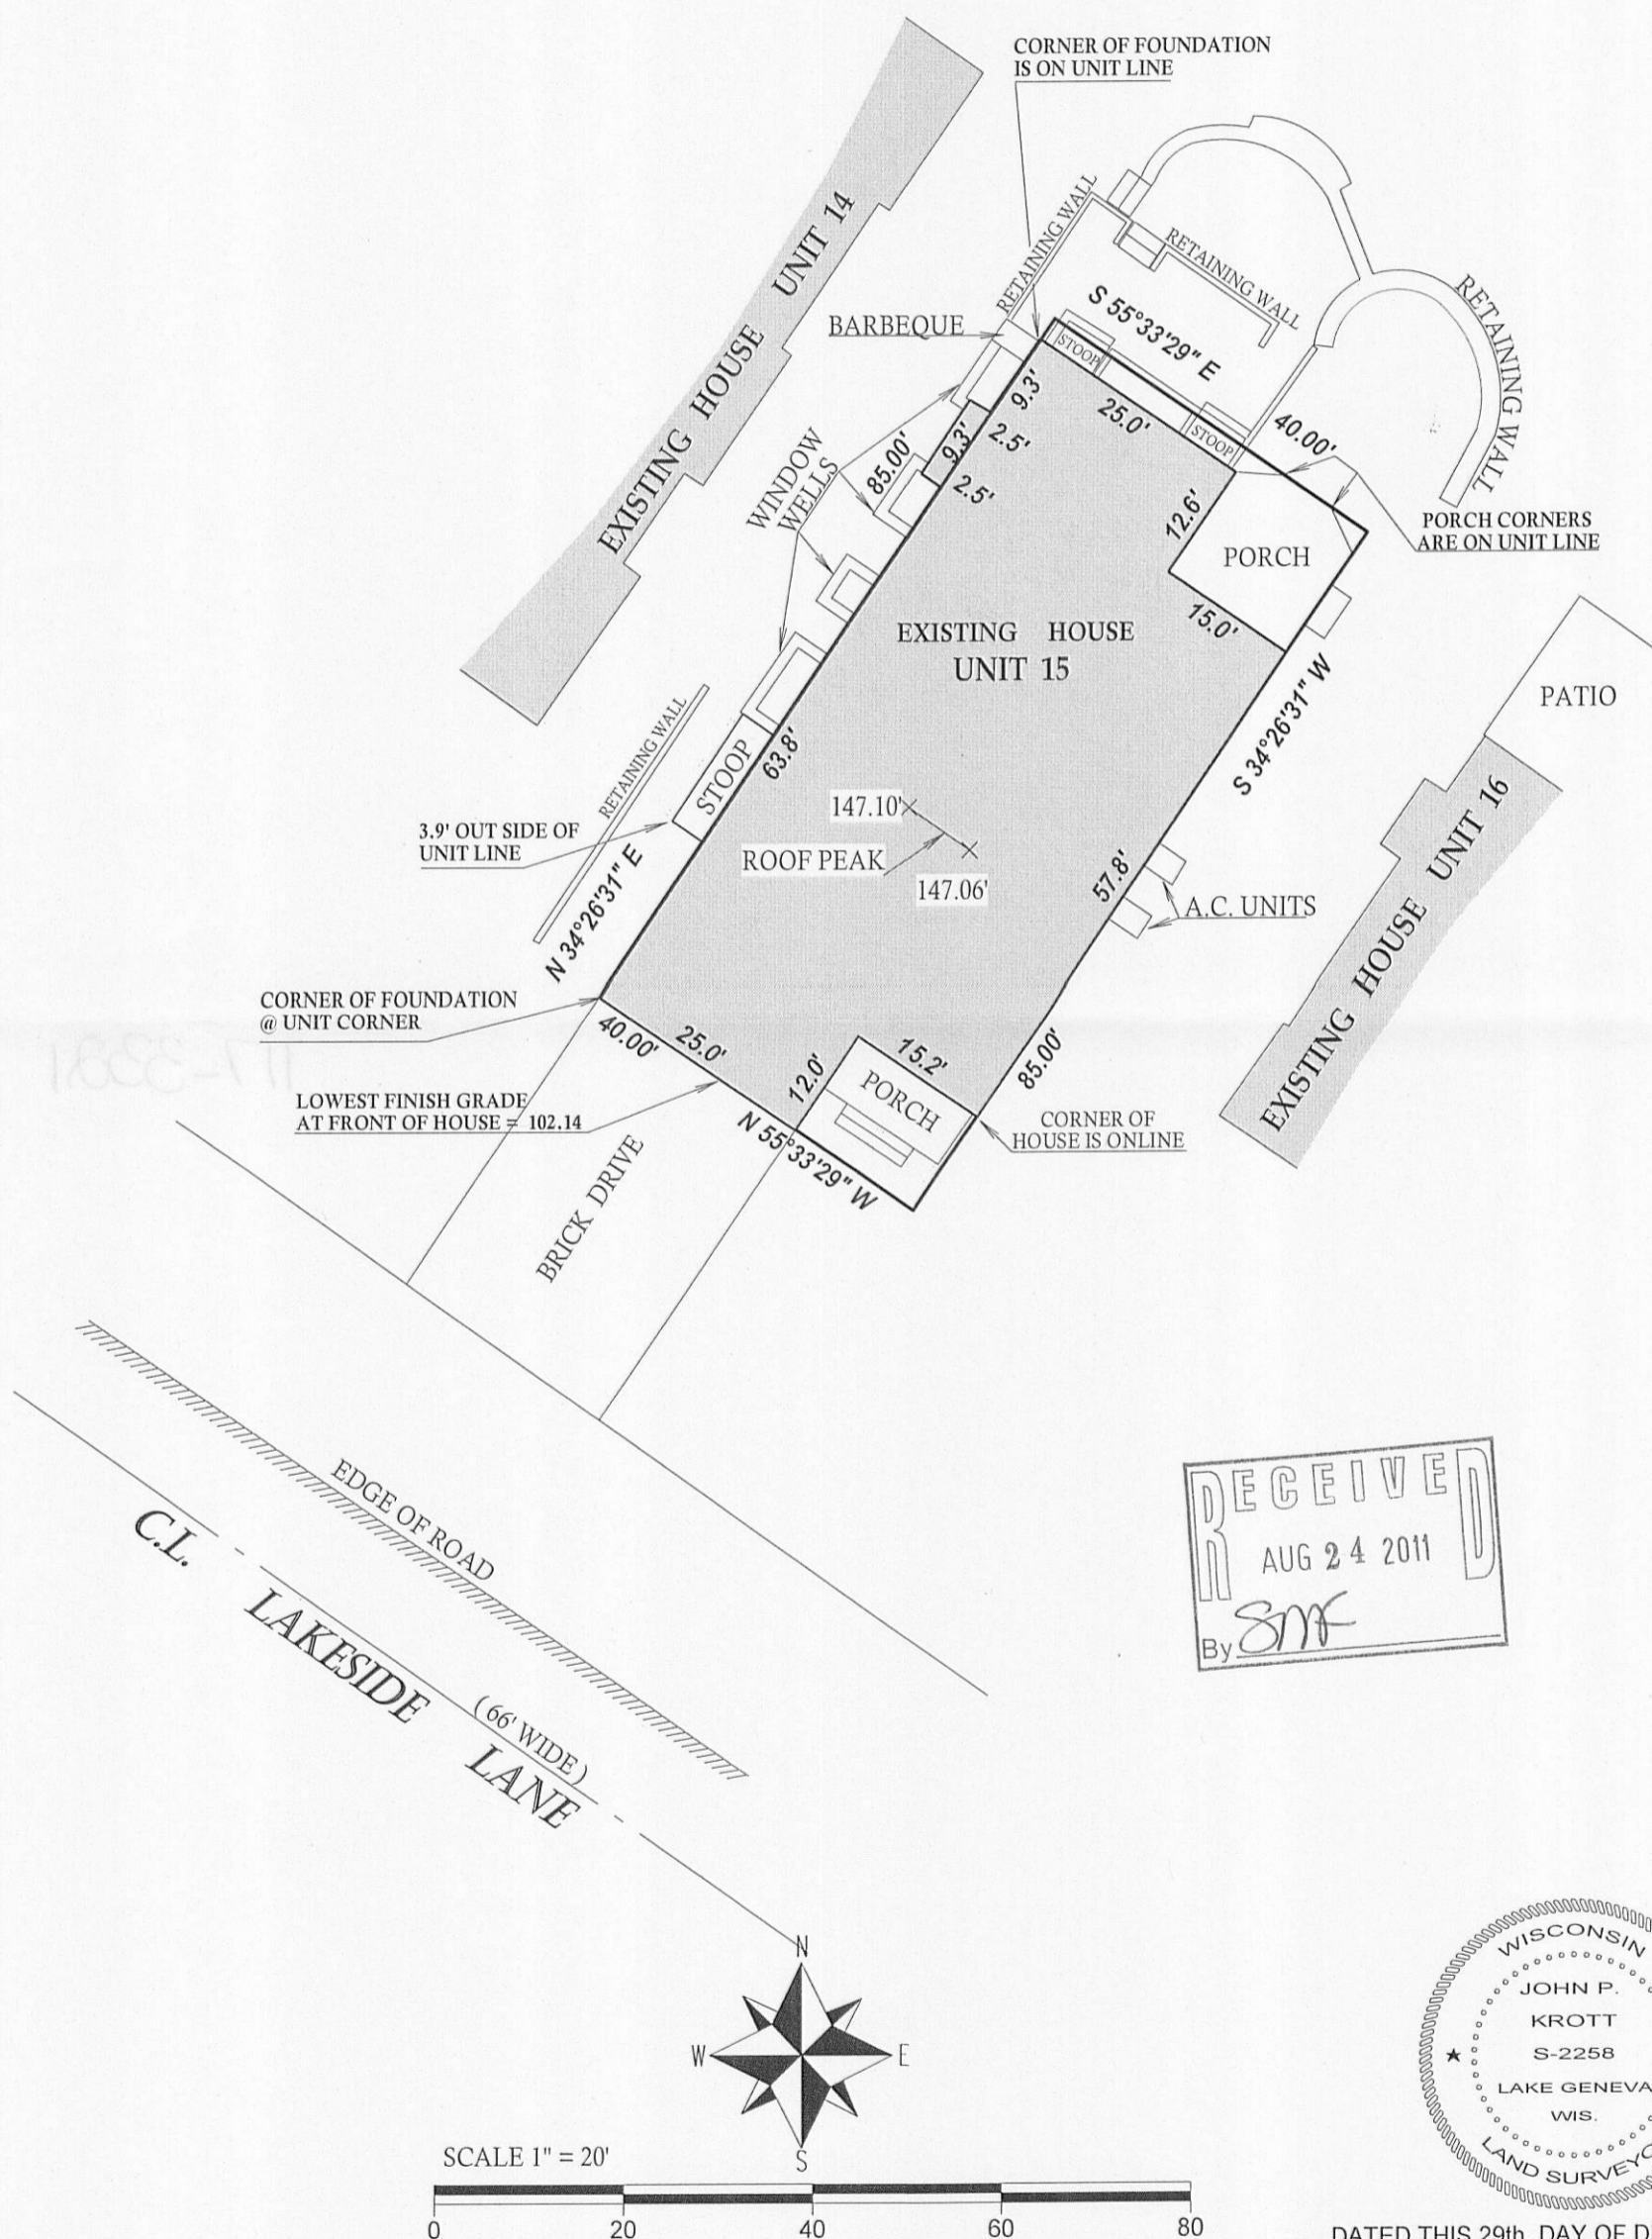

I have surveyed the above-described property and the above map is a true representation thereof and shows the size and location of the property, its exterior boundaries, the location and dimensions of all structures thereon, fences apparent easements and roadways and visible encroachments, if any.

This survey is made for the exclusive use of the present owners of the property, and also those who purchase, mortgage, or insure the title thereto within one (1) year from date hereof; and as to them I warrant the accuracy of said survey map.

TAX ID # ISSC00015AB

JOB # 10-171

DATED THIS 29th, DAY OF DECEMBER, 2010.
DATE OF LAST REVISION: 07 / 12 / 2011
REVISED 6 / 10 / 2011

JOHN KROTT S - 2258
Wisconsin Registered Land Surveyor
(original if signed in red)

155C-15

117-3321