

LAND-MARK SURVEYING
Mark L. Miritz
Wisconsin Registered Land Surveyor S-2582


N9330 Knuteson Drive
Whitewater, WI 53190
Phone: (262) 495-3284
FAX: (262) 495-8421
LAND-MARKSURVEYING.COM

PLAT OF SURVEY

LOT 4, BLOCK 4, OF WOODDALE ADDITION
LOCATED IN TOWN 1 NORTH, RANGE 17 EAST,
LINN TOWNSHIP, WALWORTH COUNTY,
WISCONSIN.

OWNER: DENNIS SPINGLER
834 BEACH
LAGRANGE PARK, IL 60525

BEARINGS ARE ASSUMED
NO BEARINGS ON PLAT

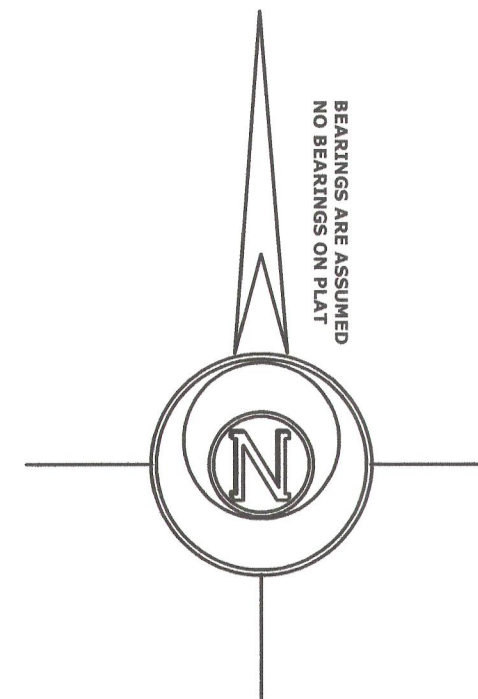

SURVEYOR'S NOTE:

LOT 4 IS AN EXISTING SUBSTANDARD LOT ZONED R-1 UNSEWERED.
THE FRONT AND REAR BUILDING SETBACK IS 25'. THE SIDEYARD
BUILDING SETBACK IS 16% OF THE LOT WIDTH AT A LINE PARALLEL
WITH THE RIGHT-OF-WAY AT THE STREET SIDE OF THE BUILDING.

LEGEND

- FOUND IRON PIPE
- FOUND IRON ROD
- RECORDED AS DIMENSION

SCALE: 1 INCH = 30 FEET

"I hereby certify that the above described property has
been surveyed by me or under my direction and that the
above map is a true representation thereof and shows the
size and location of the property, its exterior boundaries,
the location of all visible structures and dimensions of all
principal buildings thereon, boundary fences, apparent
easements, roadways and visible encroachments, if any."
"This survey is made for the use of the present owners of
the property, and also those who purchase, mortgage, or
guarantee the title thereto within one year from date
hereof."

MARK L. MIRITZ
WISCONSIN REGISTERED
LAND SURVEYOR S-2582


REVISED DECEMBER 7, 2011
TO SHOW RESIDENCE "AS BUILT"
REVISED AUGUST 23, 2011
TO SHOW PROPOSED RESIDENCE

DATE: JUNE 22, 2011 JOB NO. 11.509



FOUND ADDITIONAL PIPE
N 66°27'38" W 0.32'
FROM CORNER

HILLTOP ROAD
(66' WIDE)

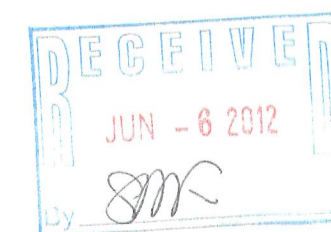

IW-44A

117-3396