


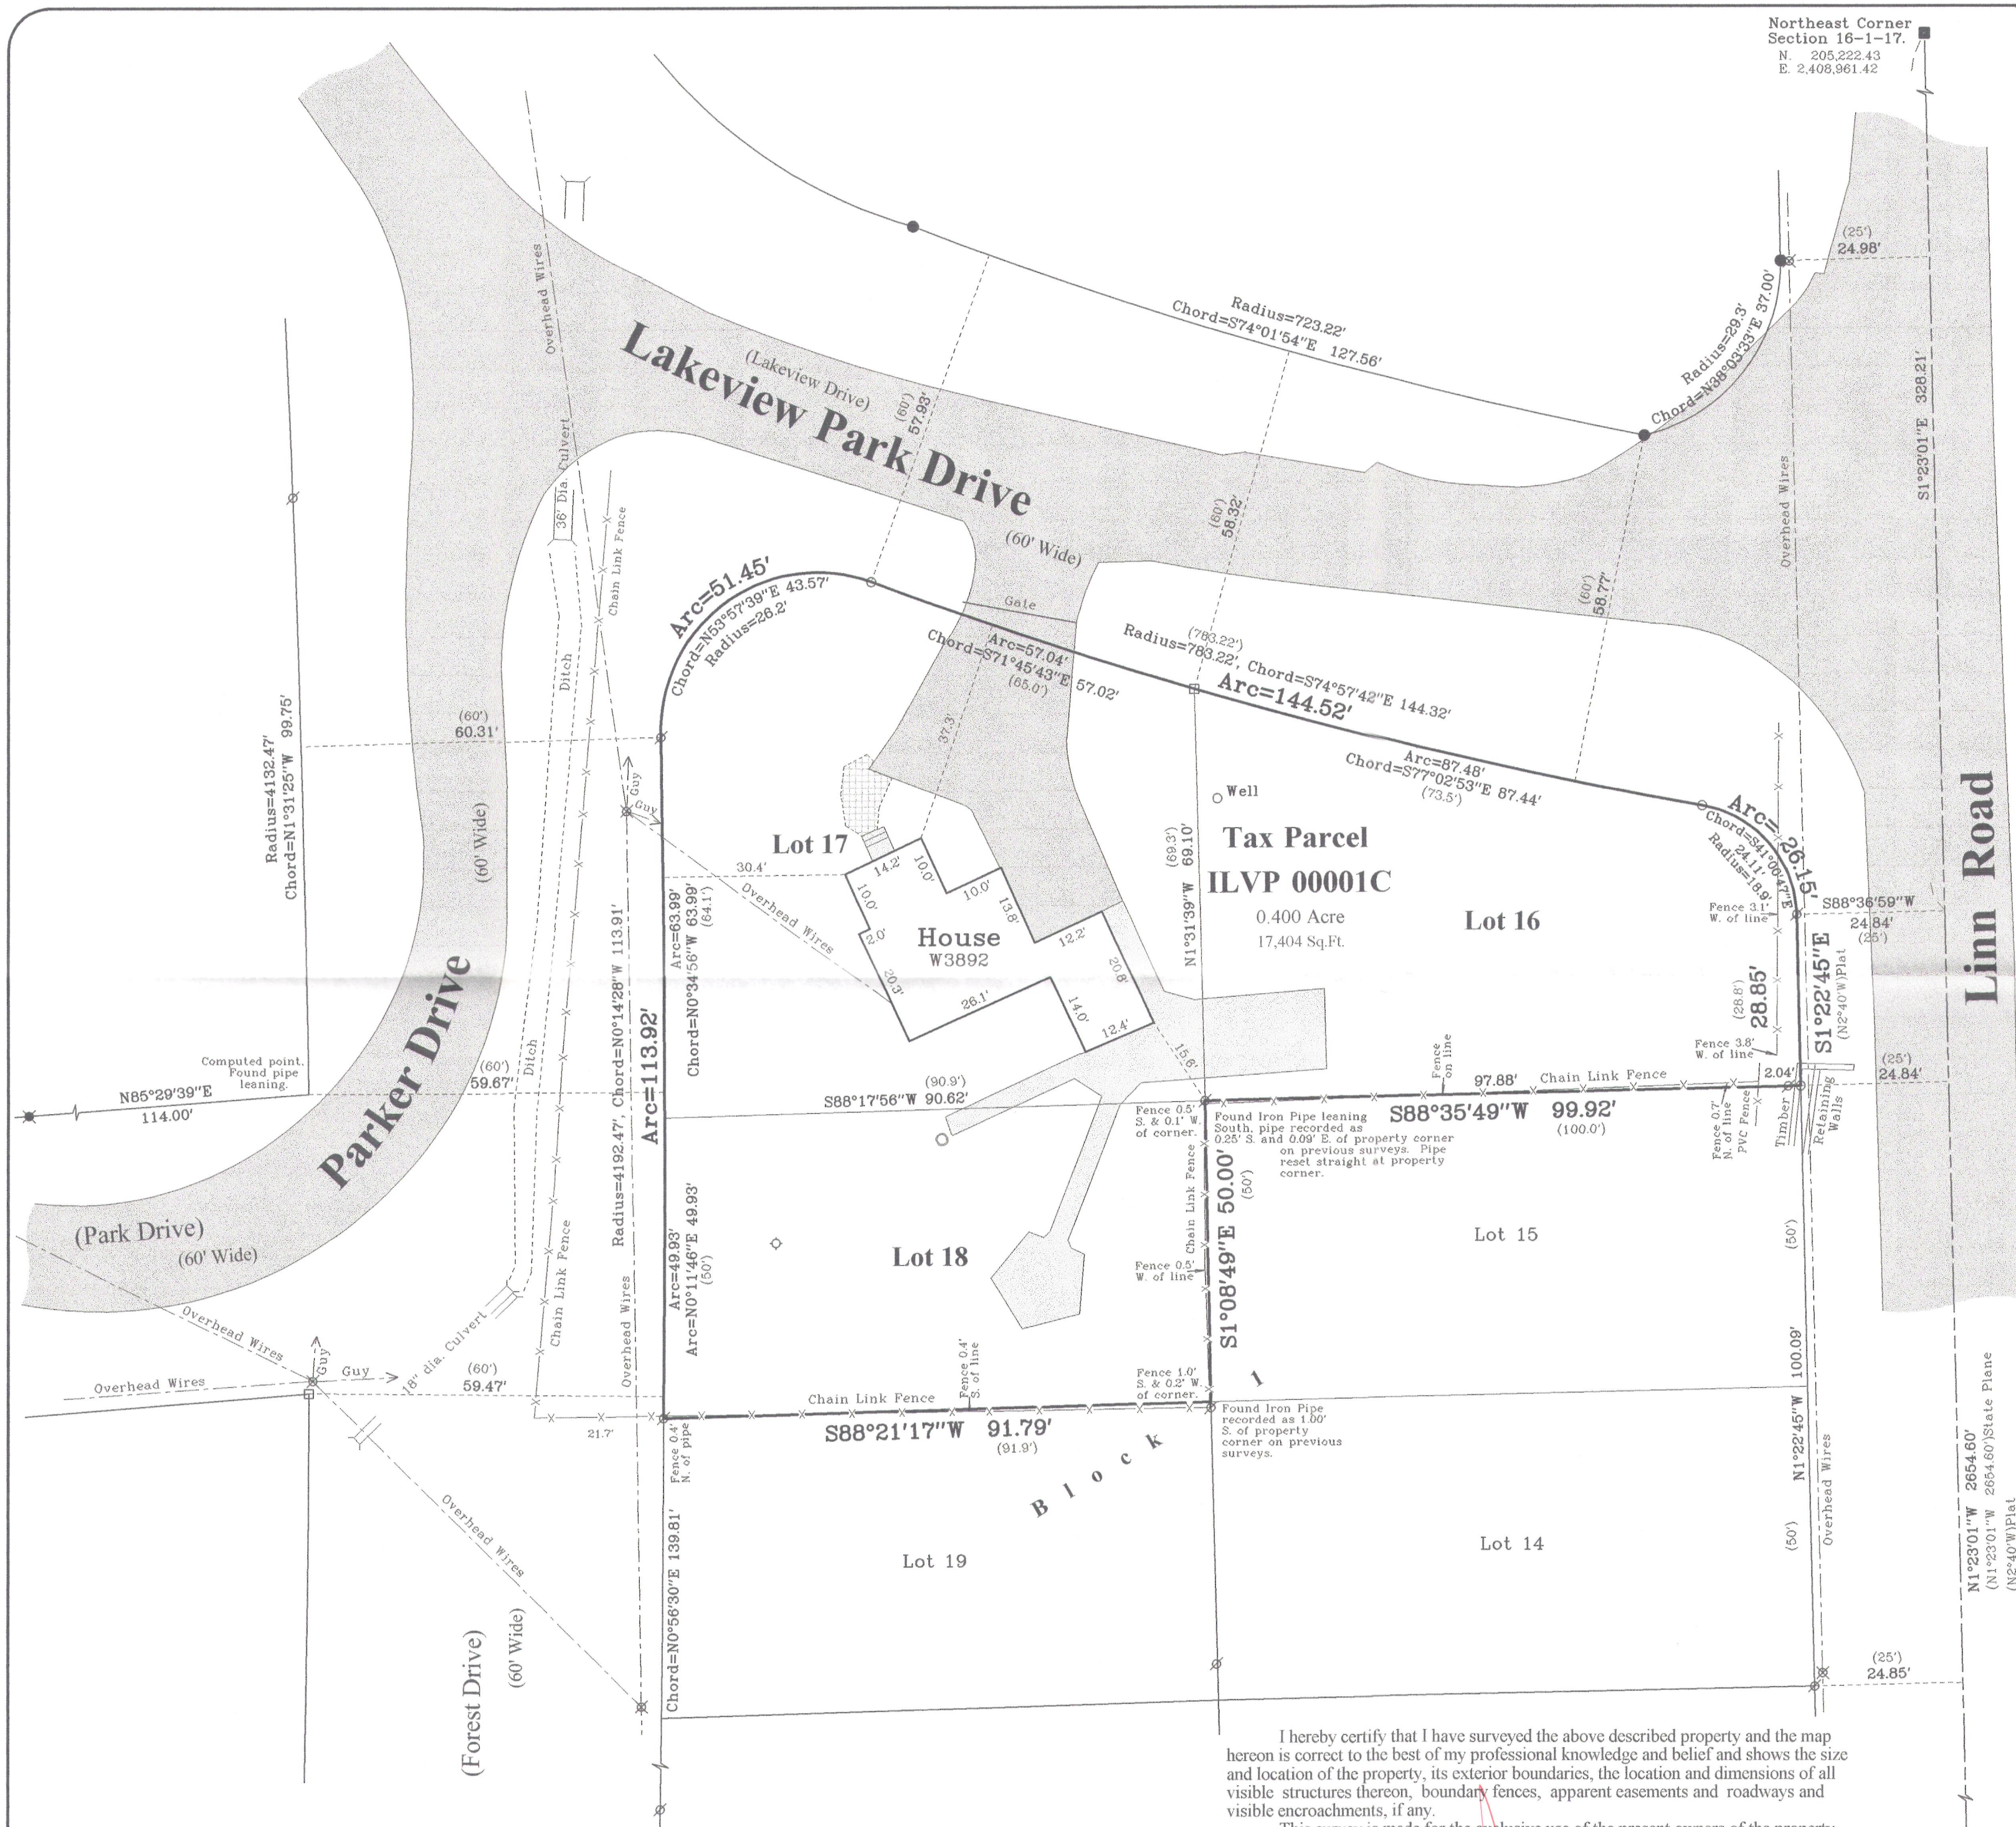


Plat of Survey

of
**Lots 16, 17 & 18 in Block 1
 of Lakeview Park,**
 a subdivision located in the Northeast 1/4 of Section 16,
 Town 1 North, Range 17 East, Town of Linn,
 Walworth County, Wisconsin.


Surveyed for:

RE/MAX Geneva Realty, Ltd.

101 Broad Street, Suite 102
 Lake Geneva, Wisconsin. 53147

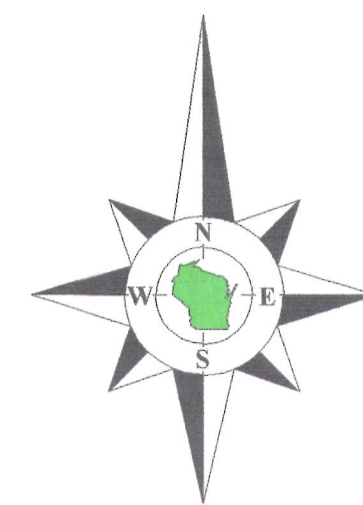

Bearings reference to the Wisconsin State
 Plane Coordinate System, South Zone.

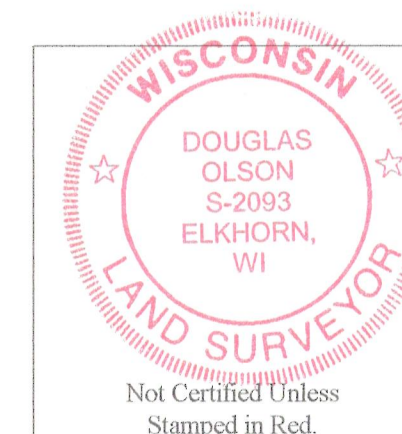

Notes:

- 1) This survey plat is not certified unless signed and sealed in red ink.
- 2) This survey is subject to Wisconsin lien laws. This Plat of Survey is the notice of intent to file lien. Lien waiver required.

Copyright 2012 by Jensen & Olson Land Surveying, LLC.

All rights reserved. No part of this survey plat may be reproduced or transmitted in any form by any means - graphic, electronic, or mechanical, including photocopying, tracing, or information storage and retrieval systems - without permission in writing from Douglas G. Olson, Jensen & Olson Land Surveying, LLC.


I hereby certify that I have surveyed the above described property and the map hereon is correct to the best of my professional knowledge and belief and shows the size and location of the property, its exterior boundaries, the location and dimensions of all visible structures thereon, boundary fences, apparent easements and roadways and visible encroachments, if any.

This survey is made for the exclusive use of the present owners of the property, and also those who purchase, mortgage or guarantee title thereto, within one year from the date hereof.

Douglas G. Olson
 Wisconsin Registered Land Surveyor - 2093

East 1/4 Corner
 Section 16-1-17.
 N. 202,568.61
 E. 2,409,025.52

Survey Date: September 21, 2012.
 Revisions:

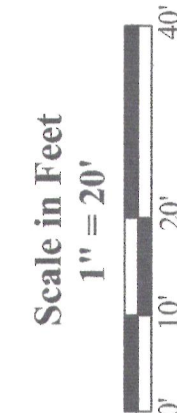

Jensen & Olson Land Surveying, LLC

45 South Wisconsin Street * P.O. Box 322 * Elkhorn, Wisconsin. 53121
 Telephone: (262) 723-3434 * Facsimile: (262) 723-8044
 Email: jensen.olson@elknet.net

Legend
 Found County Section Corner
 Found Iron Pipe
 Found Iron Rod
 Found 1" dia. Pipe
 Found 1" dia. Utility Pole
 Found 1" dia. Septic Vent
 Found 1" dia. Concrete Cover
 Found 1" dia. Flagstone

Sheet 1 of 1 Sheets
 Job Reference Number
2012.105

2012.105

ILVP-1C

117.3453