TOWN 1 NORTH, RANGE 17 EAST, WALWORTH COUNTY, WISCONSIN




PROJECT NO. 8682

DATE: 10/16/2012 SHEET NO. 1 OF 1

LOCATED IN PART OF THE NORTHEAST 1/4 OF SECTION 9,

ASSIGNED THE WESTERLY BOUNDARY OF LOT 21 N 21°57'00" W PER RECORD SUBDIVISION PLAT

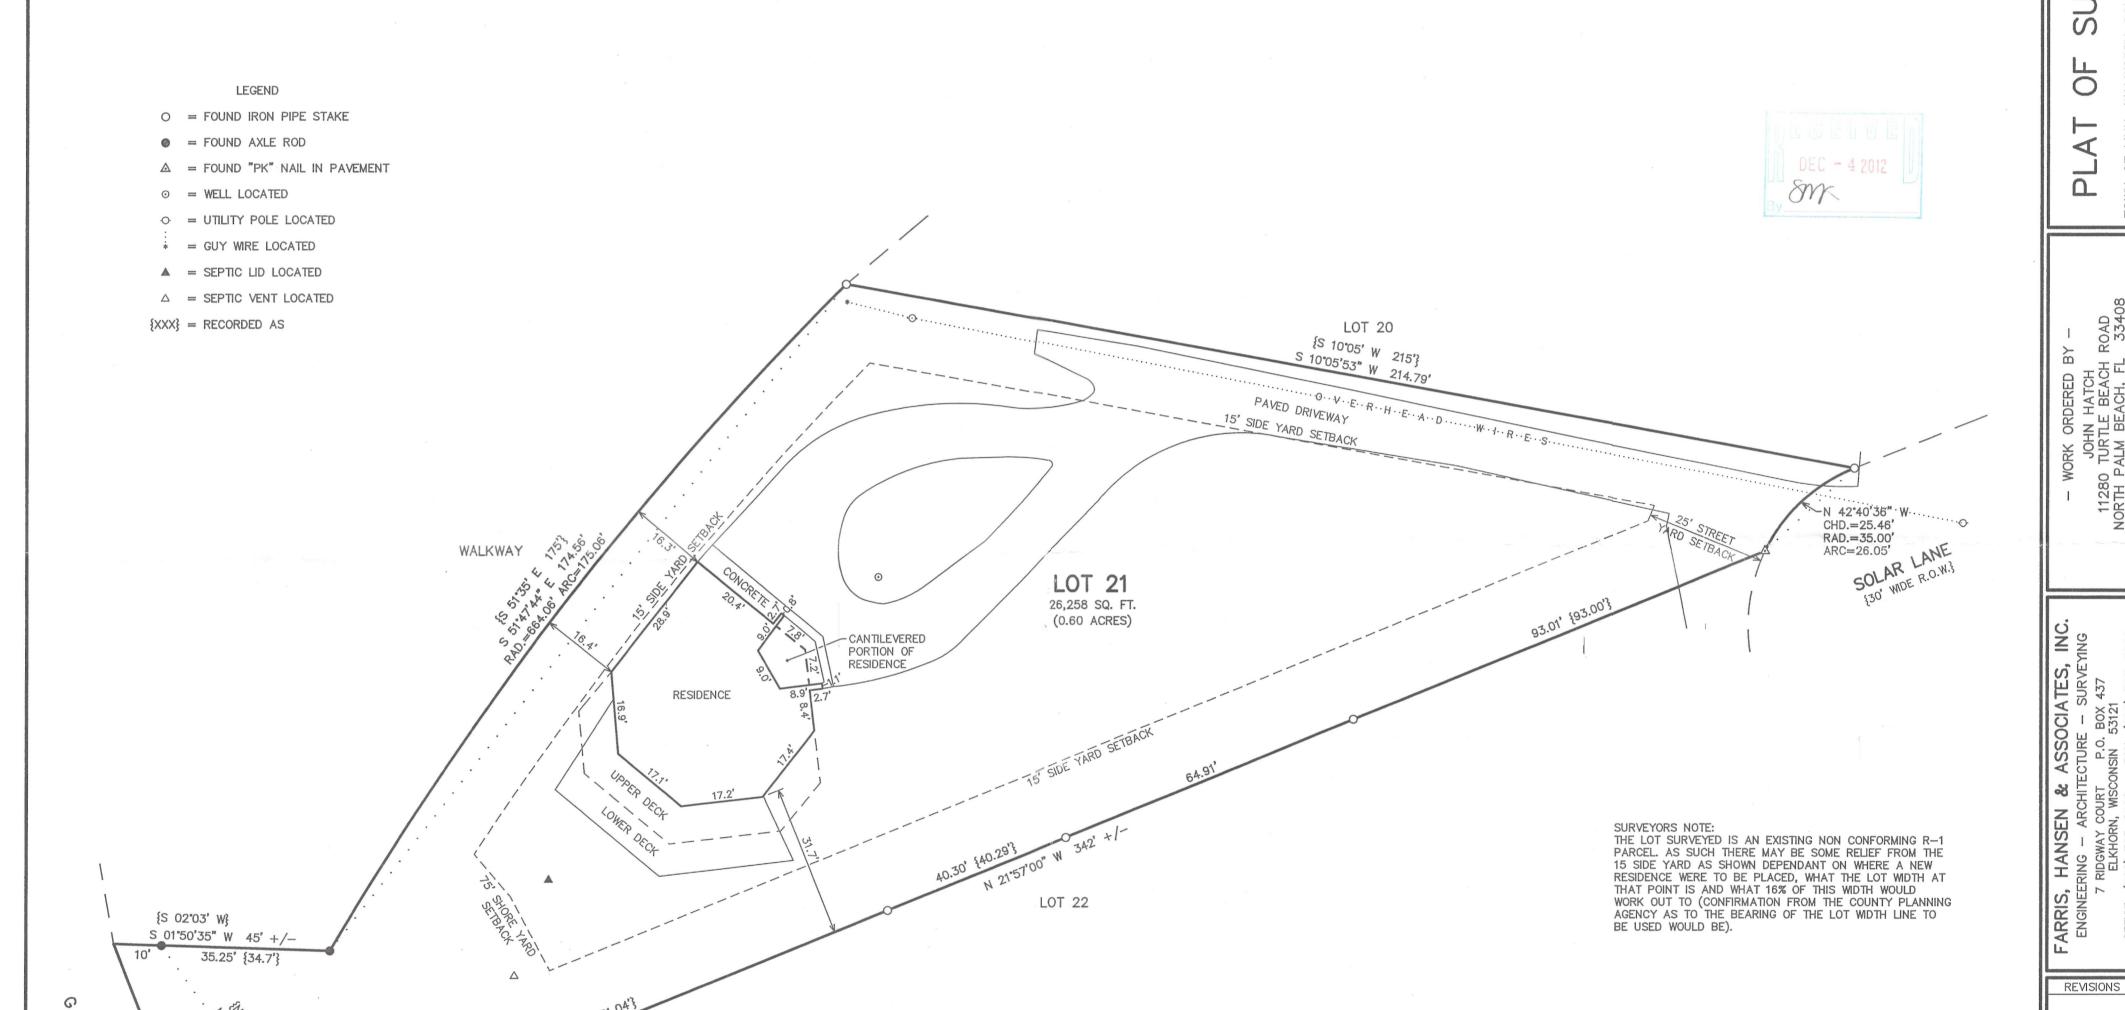

GORDON

10/16/2012

S-2101

ELKHORN,

REVISED 10-23-2012 TO CORRECT ERROR ON SHORE FRONT LABEL

NOTE: COPIES OF THIS MAP TO WHICH THE FOLLOWING CERTIFICATE

WILL APPLY SHOW THE SURVEYOR'S ORIGINAL SEAL AND SIGNATURE IN RED INK. COPIES BY ANY OTHER MEANS MAY HAVE ALTERATIONS

I HEREBY CERTIFY THAT THE ABOVE DESCRIBED PROPERTY HAS BEEN SURVEYED UNDER MY DIRECTION AND THAT THE ABOVE MAP IS A TRUE REPRESENTATION THEREOF AND SHOWS THE SIZE AND LOCATION OF THE PROPERTY AND ITS EXTERIOR BOUNDARIES. THIS SURVEY IS MADE FOR THE USE OF THE PRESENT OWNERS OF THE PROPERTY, AND ALSO THOSE WHO PURCHASE, MORTGAGE, OR GUARANTEE THE TITLE THERETO WITHIN ONE YEAR FROM THE DATE HEREOF.

WHICH DO NOT REPRESENT THE SURVEYOR'S WORK PRODUCT.

PETER S. GORDON R.L.S. 2101

IBA1 - 12A

1

1

1

-WOOD STEPS

60

MAP SCALE IN FEET ORIGINAL 1" = 20'

70

80