

Plat of Survey

of

Lot 3 of The Lindens,


a subdivision located in the Southeast 1/4 of Section 8, Town 1 North,
Range 17 East, Town of Linn, Walworth County, Wisconsin.

Surveyed for:


Rick Gulliver

9046 Willow Ridge Drive
Willow Springs, Illinois. 60480

Lot 2
C.S.M. 1617


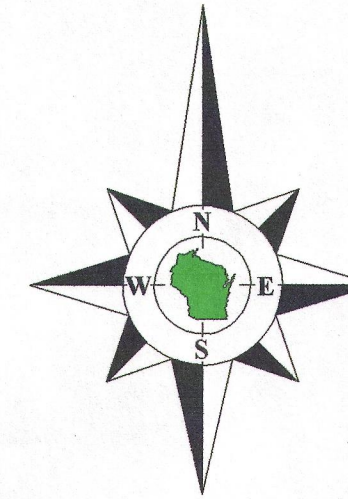


Bearings reference to the
plat of The Lindens.

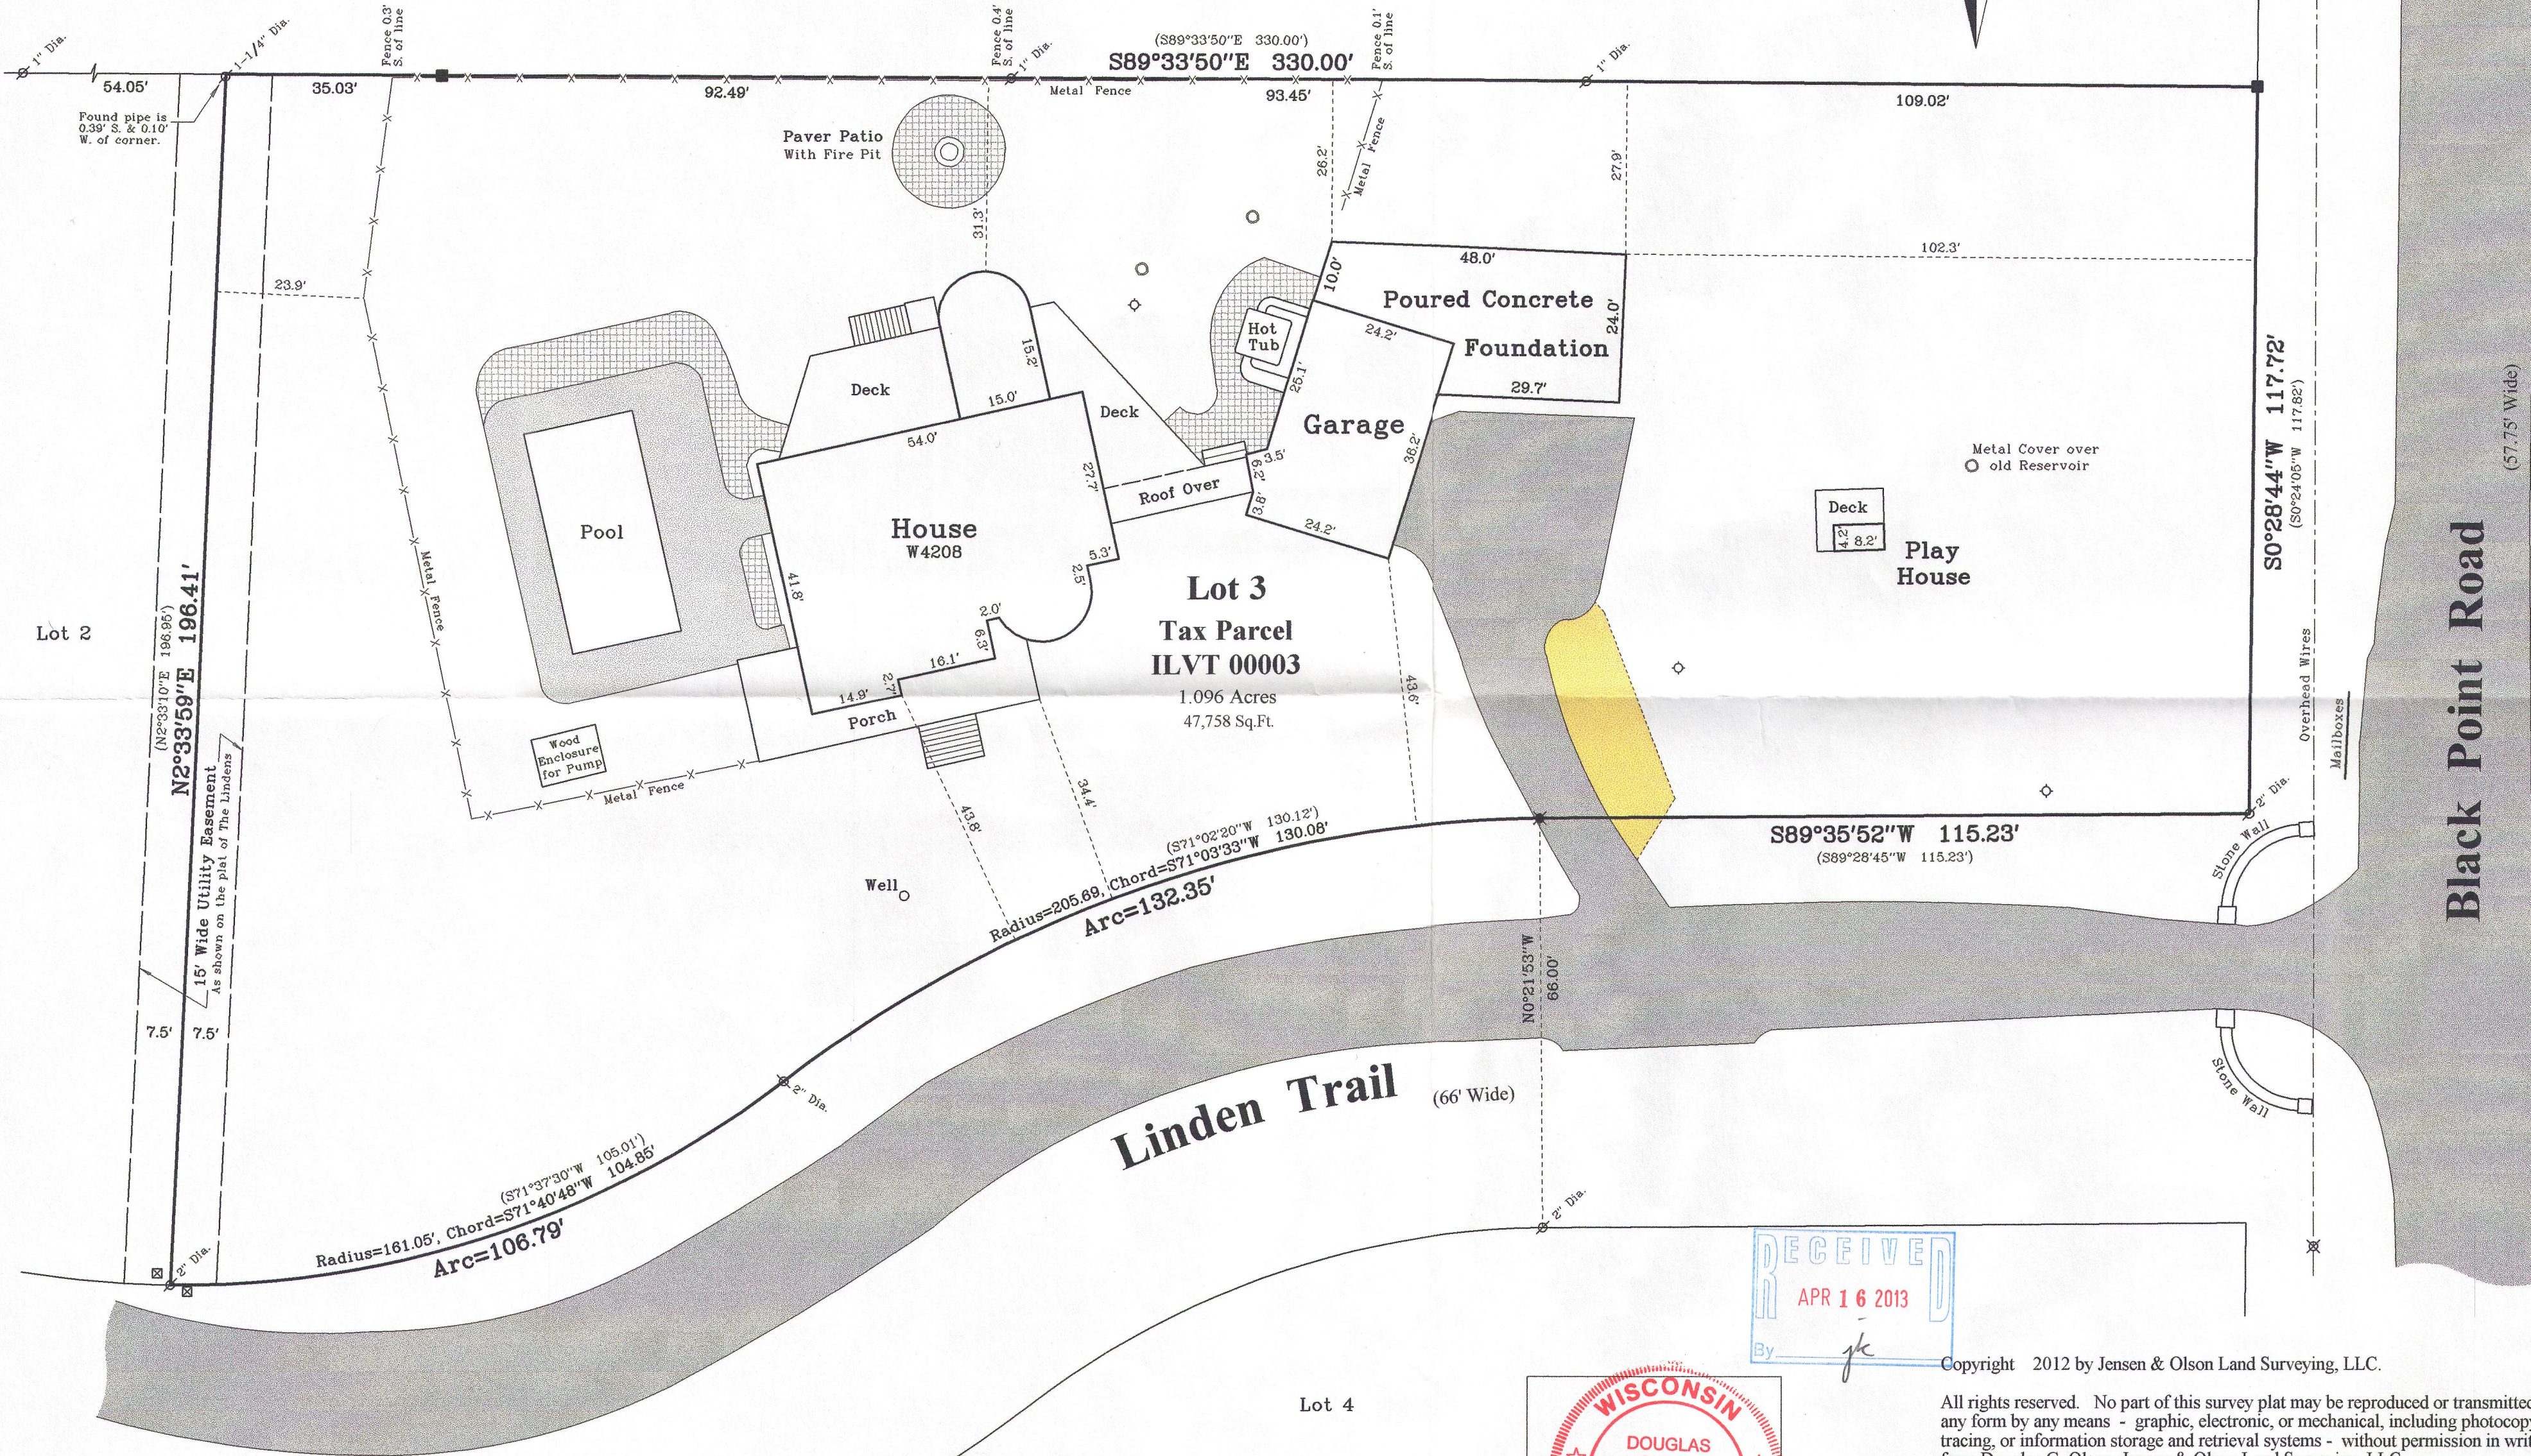

Notes:

- 1) This survey plat is not certified unless signed and sealed in red ink.
- 2) This survey is subject to Wisconsin lien laws. This Plat of Survey is the notice of intent to file lien. Lien waiver required.

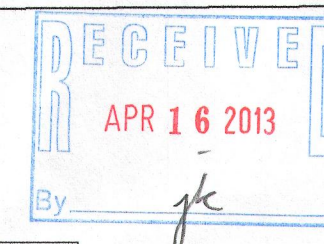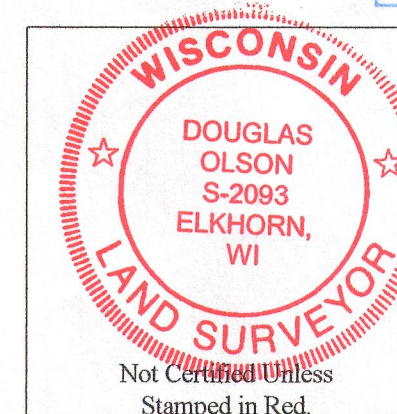

Copyright 2012 by Jensen & Olson Land Surveying, LLC.

All rights reserved. No part of this survey plat may be reproduced or transmitted in any form by any means - graphic, electronic, or mechanical, including photocopying, tracing, or information storage and retrieval systems - without permission in writing from Douglas G. Olson, Jensen & Olson Land Surveying, LLC.


I, Douglas G. Olson, Wisconsin Registered Land Surveyor, do hereby certify that this survey was performed by me, or under my direction in full compliance with the owner's/agent's instructions and Chapter A-E 7 of the Wisconsin Administrative Code "Minimum Standards for Property Surveys"; and that this map is an accurate representation thereof to the best of my knowledge and belief.

Douglas G. Olson
Wisconsin Registered Land Surveyor - 2093

Survey Date: Sept. 8, 2012.

Revisions: No. 1 - Proposed Addition
No. 2 - Proposed Addition
No. 3 - Proposed Addition
No. 4 - Foundation

Scale in Feet
1" = 20'

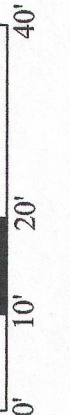

Jensen & Olson Land Surveying, LLC

45 South Wisconsin Street * P.O. Box 322 * Elkhorn, Wisconsin. 53121
Telephone: (262) 723-3434 * Facsimile: (262) 723-8044
Email: jensen.olson@elknet.net

Legend
Found Concrete Monument
Found Iron Pipe
Set Mag Nail
Recorded Information
Utility Pole
Concrete Cover
Septic Tank
Asphalt Surface
Concrete

Sheet 1 of 1 Sheets
Drawing Name: ILVT 00003-2012-098-Plat.sld
Job Reference Number
2012.098

2012.098

ILVT 00003

117-3517