


KROTT SURVEYING INC.

N3705 WILLOW BEND LANE
LAKE GENEVA WI. 53147
PHONE # (262)248-3697
FAX # (262)249-0639


-OF-
LOT 4 IN BLOCK "F" IN CISCO BEACH, A SUBDIVISION IN SECTION 5,
TOWN 1 NORTH, RANGE 17 EAST, TOWN OF LINN, WALWORTH
COUNTY, WISCONSIN.

C.L. CRESCENT ROAD
(50' WIDE)

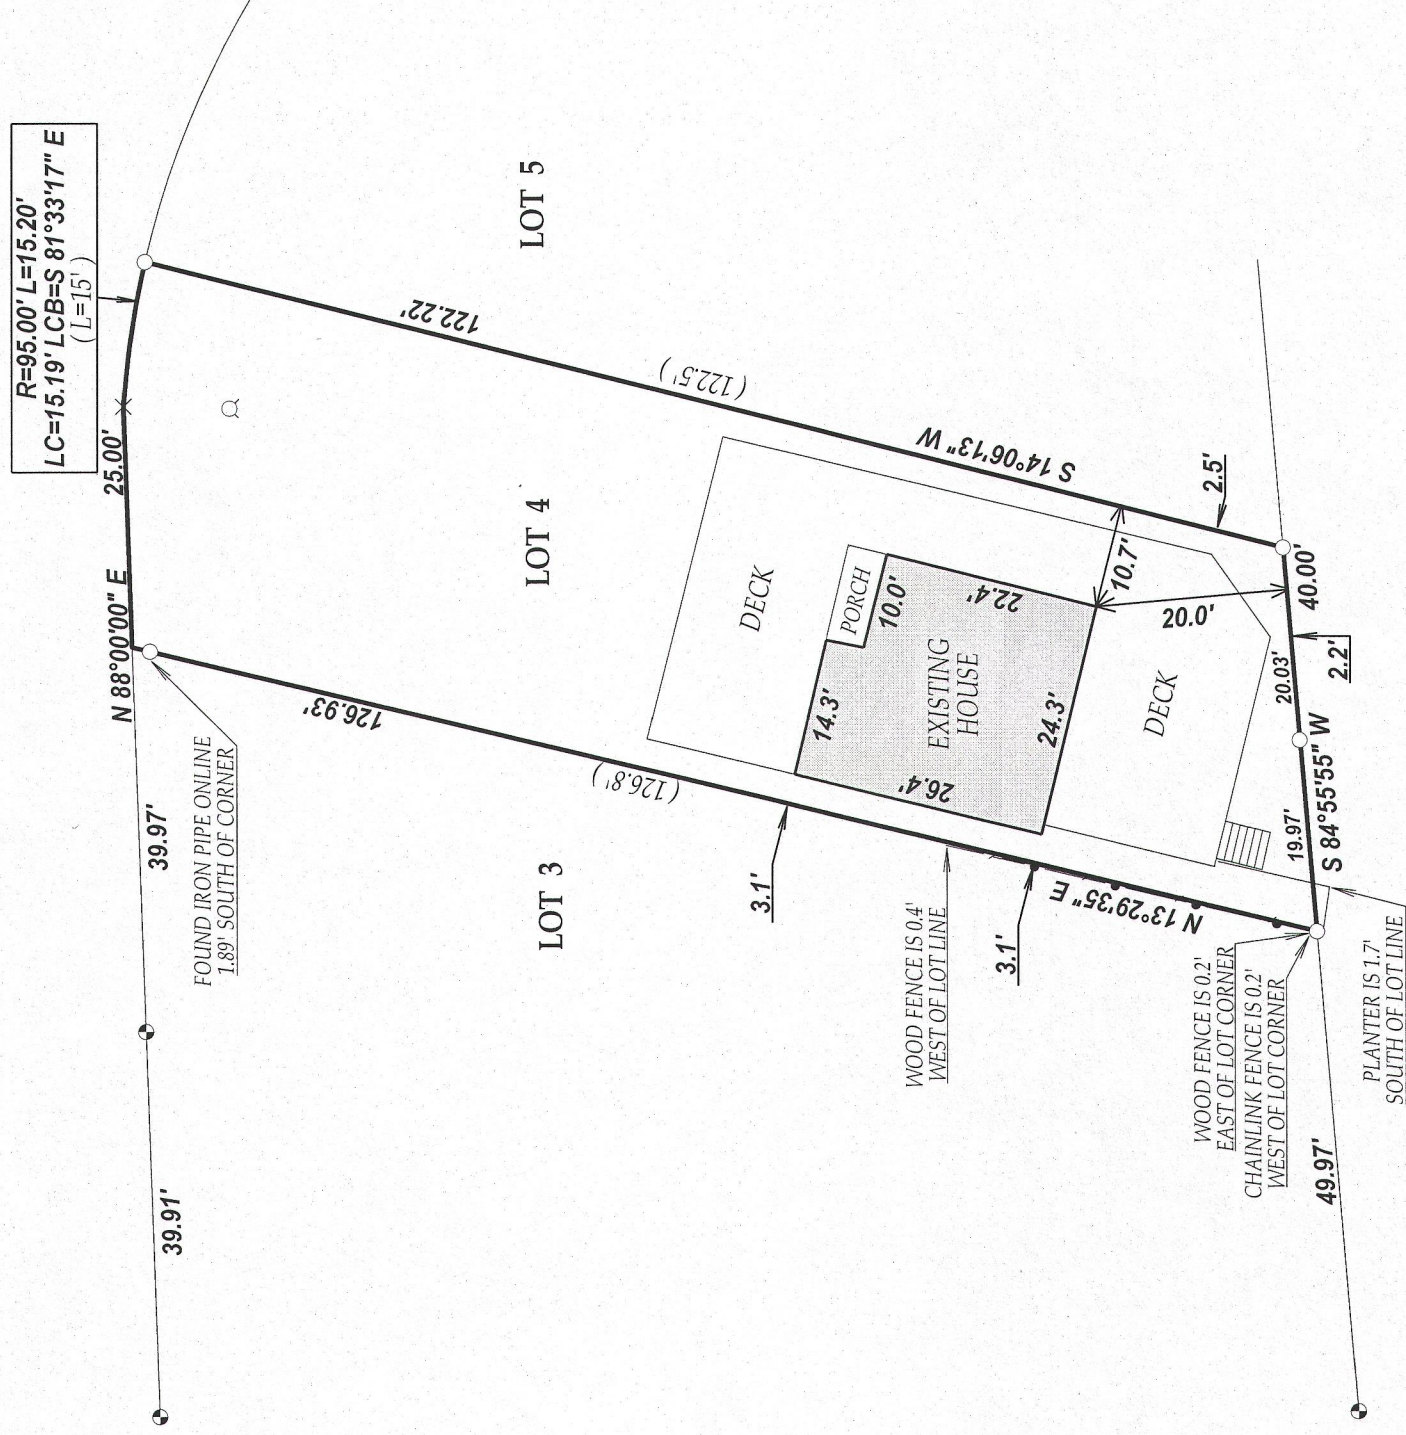

LEGEND

- FOUND IRON PIPE
- FOUND IRON BAR
- FOUND CONCRETE MONUMENT
- × CUT CROSS IN CONCRETE

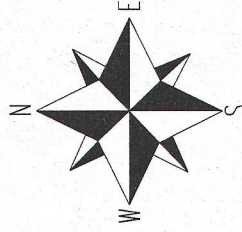

SCALE 1" = 20'



I have surveyed the above-described property and the above map is a true representation thereof and shows the size and location of the property, its exterior boundaries, the location and dimensions of all structures thereon, fences apparent easements and roadways and visible encroachments, if any.

(XX) RECORDED AS

TAX ID# ICI00108

JOB # 13-021

DATED THIS 13th DAY OF FEBRUARY 2013

JOHN KROTT S - 2258
Wisconsin Registered Land Surveyor
(original if signed in red)

117-3539