




PREPARED FOR  
AKEMANN FAMILY TRUST  
410 HOXIE CR.  
ELGIN, IL. 60123-3220

# PLAT OF SURVEY

- OF -

PATHFINDER SURVEYING INC.  
(formerly)  
J.K. SURVEYING INC.  
P.O BOX 322  
LAKE GENEVA, WI. 53147  
WWW.PATHFINDERSURVEYING.NET  
262-248-8303

LOT 4 AND LOT 5, EXCEPT THE SOUTHERLY 3 FEET LOF LOT 5,  
CAMP SYBIL A SUBDIVISION LOCATED IN SECTION 18, TOWN 1  
NORTH, RANGE 17 EAST, TOWN OF LINN, WALWORTH COUNTY,  
WISCONSIN.

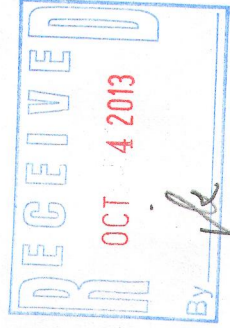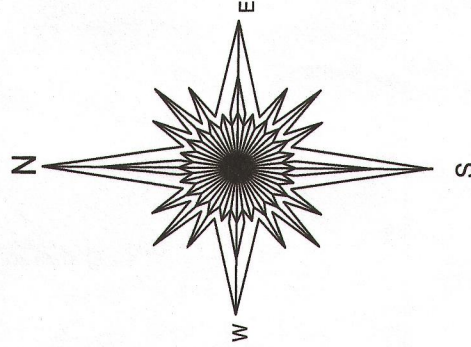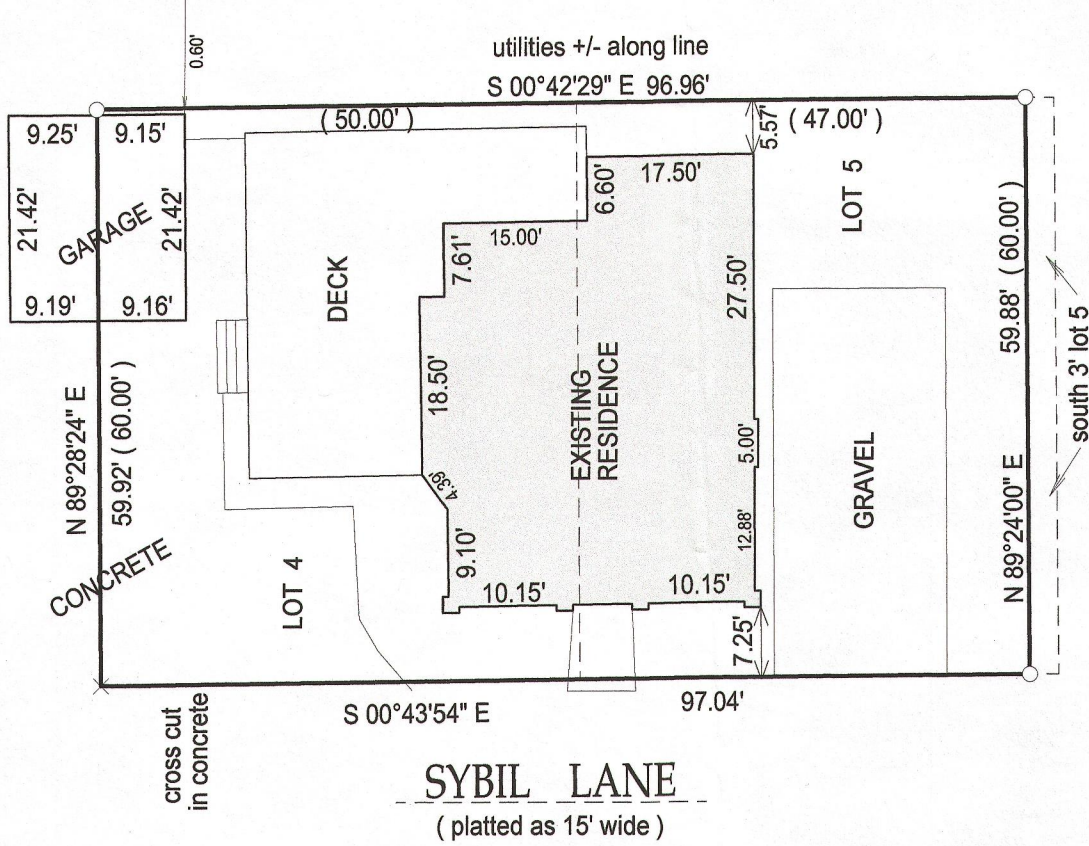


- ( ) = recorded as
- = found iron bar
  - = found iron pipe
  - = set iron pipe
  - = set iron bar

SCALE 1" = 20'

JOB # 13-141

TAX ID # ICA00004

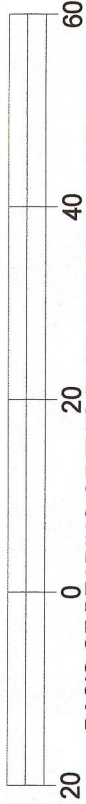

BASIS OF BEARING OF THIS PLAT: THE SOUTH LINE  
OF THE PARCEL SURVEYED WAS ASSUMED TO BEAR  
N 89°24' E.

I hereby certify that I have surveyed the above- described property and the  
above map is a true representation thereof and shows the size and  
location of the property, its exterior boundaries, the location and  
dimensions of all structures thereon, fences, apparrant easements and  
roadways and visible encroachments if any.

This survey is made for the present owners of the property, and those who  
purchase, mortgage, or guarantee the title thereto, within one year from  
the date hereof.

DATED THIS 20th day of August, 2013.



JEFFREY L KIMPS S - 2436  
Wisconsin Registered Land Surveyor  
(original if signed in red)

117-3568