

ORDERED BY
DAVID AKEMANN


PLAT OF SURVEY

- OF -

PATHFINDER SURVEYING INC.
(formerly)
J.K. SURVEYING INC.
P.O. BOX 322
LAKE GENEVA, WI. 53147
WWW.PATHFINDERSURVEYING.NET
262-248-3303

LOT 1 OF WALWORTH COUNTY CERTIFIED SURVEY MAP No. 4208, RECORDED AS DOCUMENT No. 751805 IN VOLUME 26, PAGE 314 OF CERTIFIED SURVEYS AT THE WALWORTH COUNTY REGISTER OF DEEDS, BEING THE PARCEL KNOWN AS "SYBIL PARK" IN CAMP SYBIL SUBDIVISION, ACCORDING TO THE RECORDED PLAT ON FILE AND OF RECORD IN THE OFFICE OF THE REGISTER OF DEEDS IN AND FOR WALWORTH COUNTY, WISCONSIN, AND ALSO PART OF LANDS IN THE NW 1/4 OF THE NE 1/4 OF SECTION 18, TOWNSHIP 1 NORTH, RANGE 17 EAST OF THE FOURTH PRINCIPAL MERIDIAN, IN THE TOWN OF LINN, WALWORTH COUNTY, WISCONSIN.

AND
THE NORTH 24 FEET OF LOT 1, CAMP SYBIL, A SUBDIVISION LOCATED IN SECTION 18, TOWN 1 NORTH, RANGE 17 EAST OF THE FOURTH PRINCIPAL MERIDIAN, TOWN OF LINN, WALWORTH COUNTY, WISCONSIN.

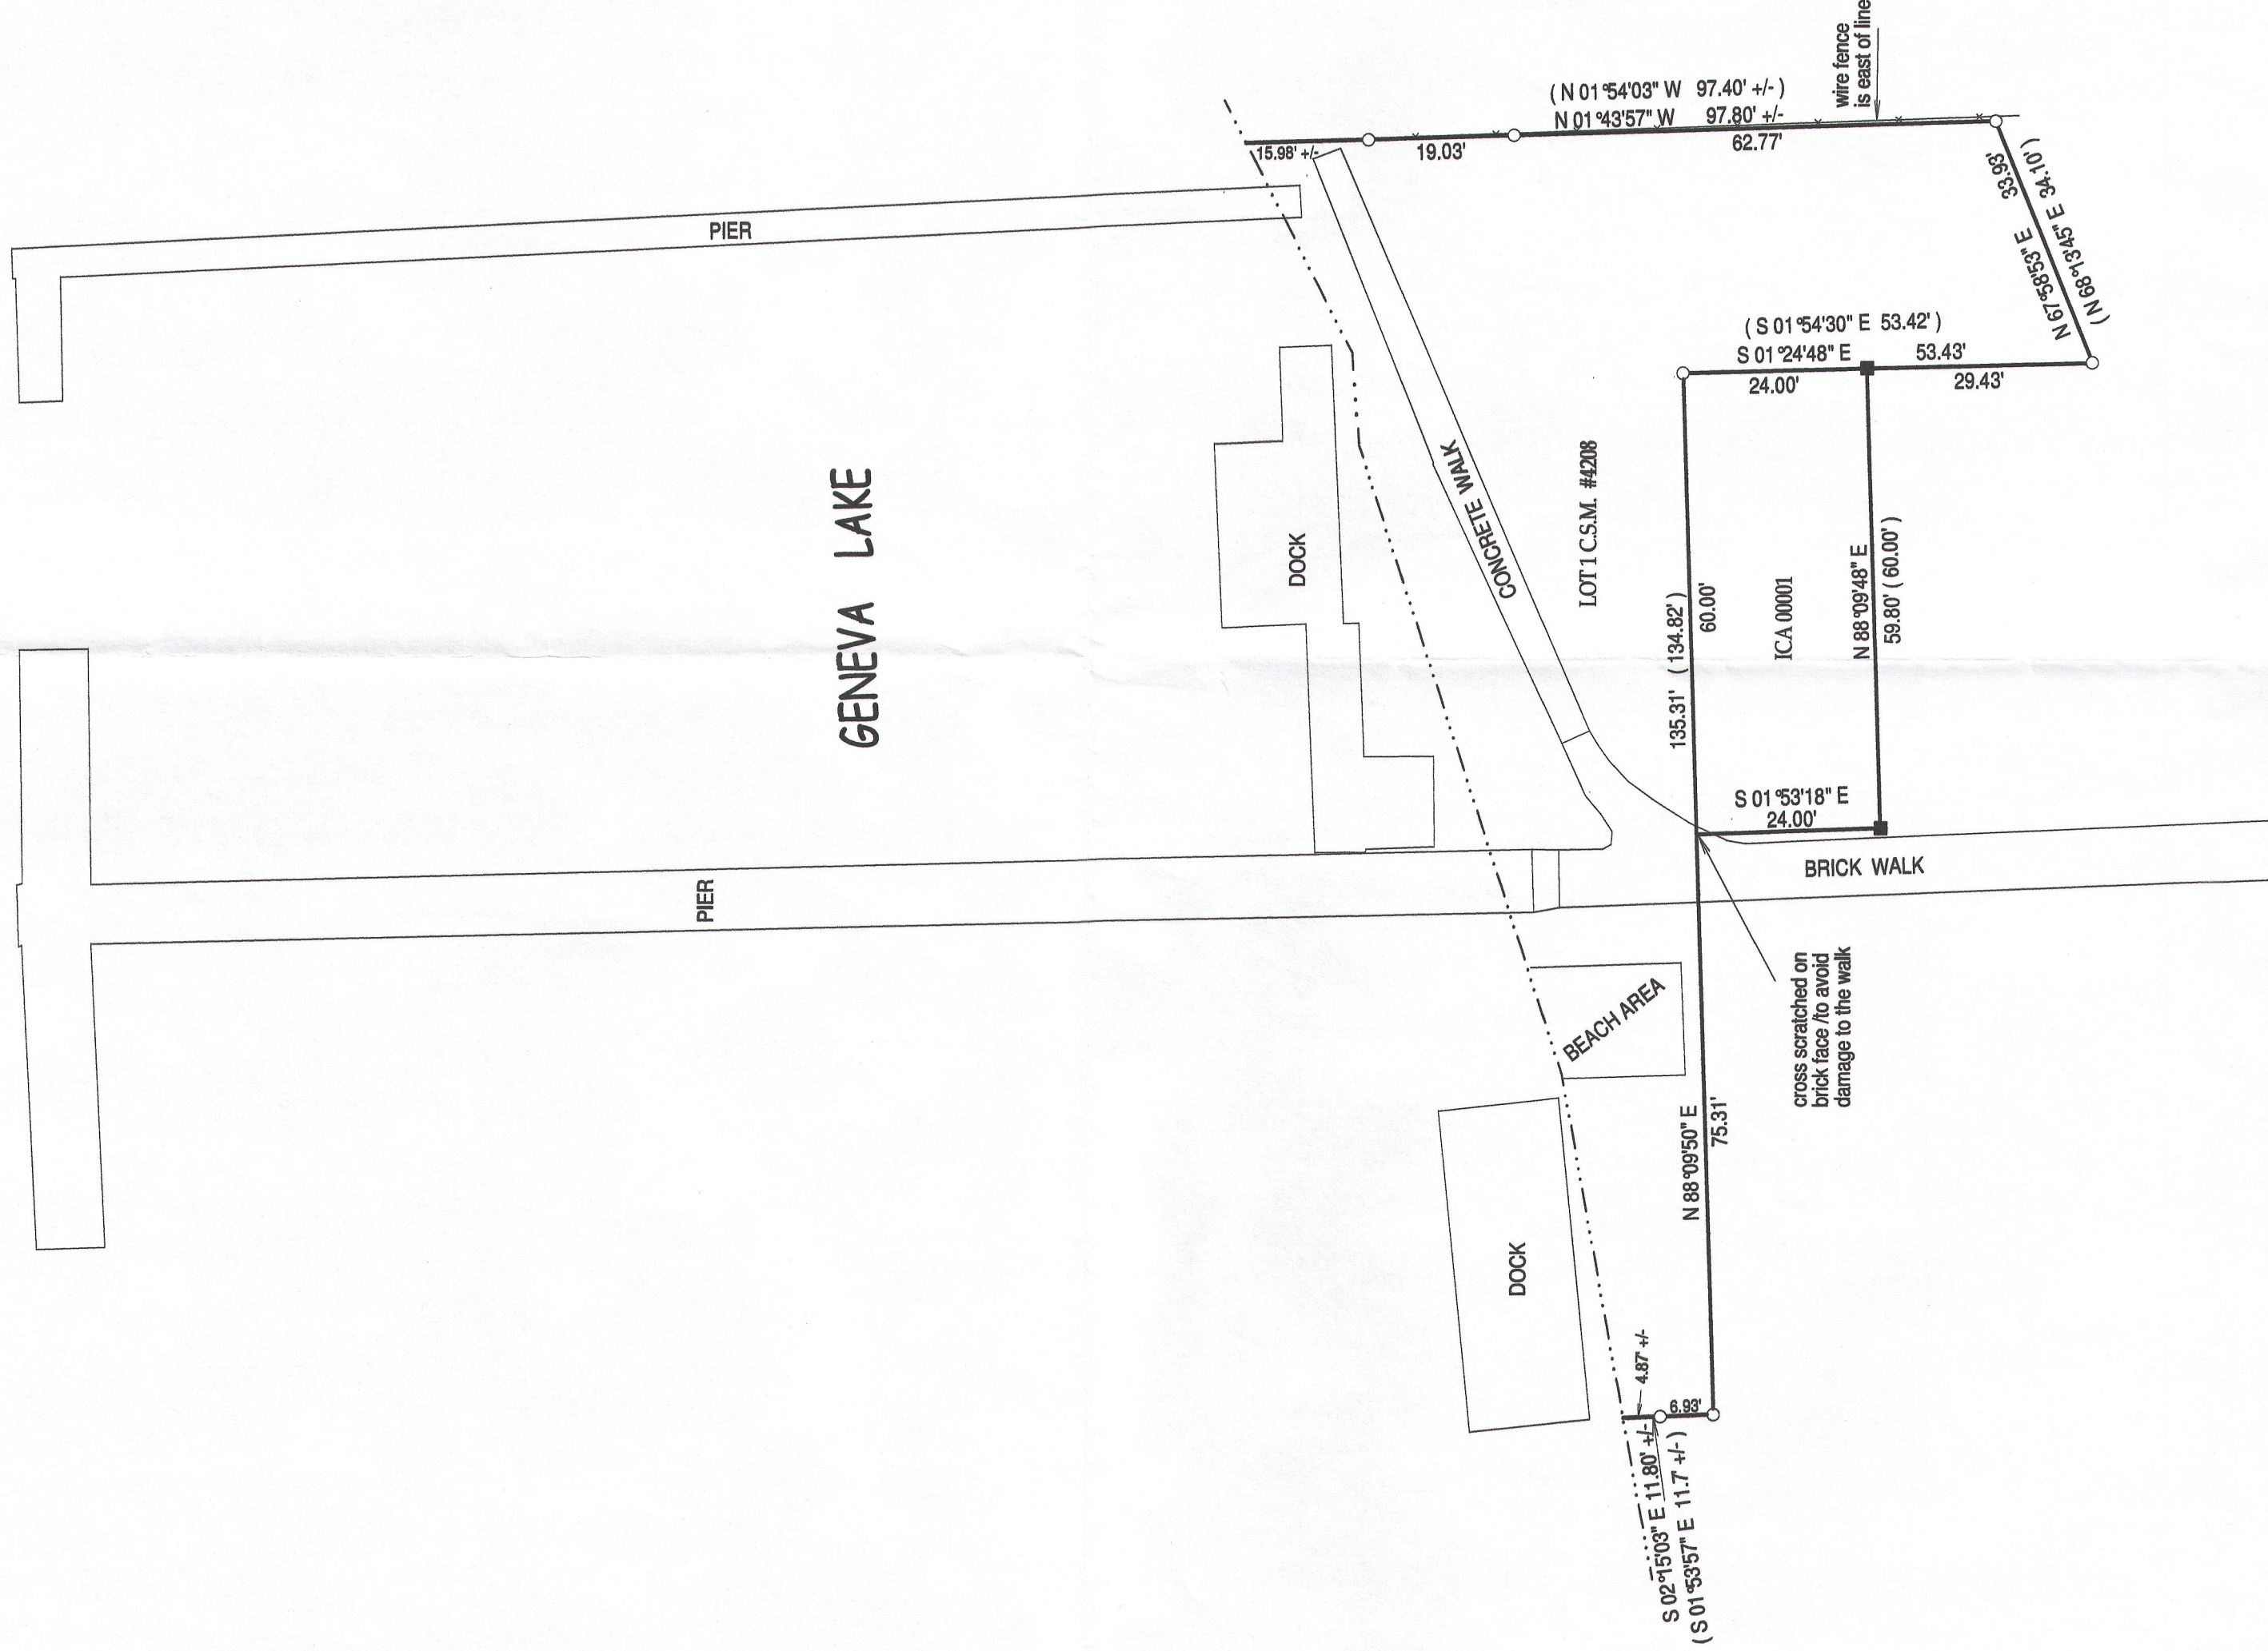


- () = recorded as
- = found iron bar
- = found iron pipe
- = set iron pipe
- = set iron bar

SCALE 1" = 20'

JOB # 13-116

TAX ID # 1A420800001 & ICA 00001

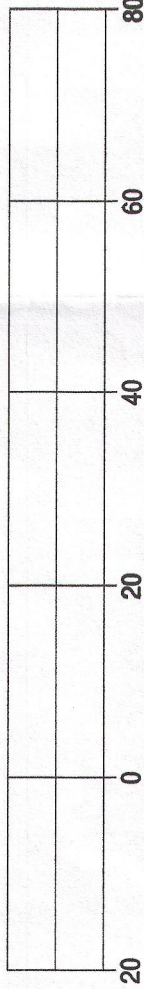

BASIS OF BEARING OF THIS PLAT: THE SOUTH LINE OF SYBIL PARK WAS ASSUMED TO BEAR N 88°09'50" E AS SHOWN ON C.S.M. 4208.


"I hereby certify that I have surveyed the above described property and that the above map is a true representation of its exterior boundary and shows the size and location of all visible structures, apparent easements and encroachments if any."

This survey is made for the present owners of the property, and those who purchase, mortgage, or guarantee the title thereto, within one year from the date hereof.

DATED THIS 18TH DAY OF JULY, 2013.



JEFFREY L. KIMPS S-2436
Wisconsin Registered Land Surveyor
(original if signed in red)

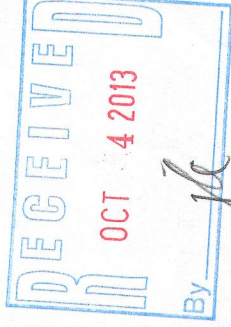

117-3570

IA4208-1
ICA -1