


PLAT OF SURVEY

LOT 1 AND 2, BLOCK 11, WOODDALE ADDITION, A SUBDIVISION LOCATED IN SECTIONS 9 AND 16, TOWN 1 NORTH, RANGE 17 EAST, TOWN OF LINN, WALWORTH COUNTY, WISCONSIN.



BASIS OF BEARING OF THIS PLAT: THE NORTH LINE OF LOT 2, BLOCK 11, WOODDALE ADDITION WAS ASSUMED TO BEAR EAST - WEST.

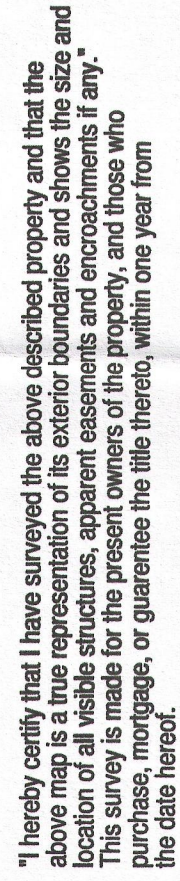