


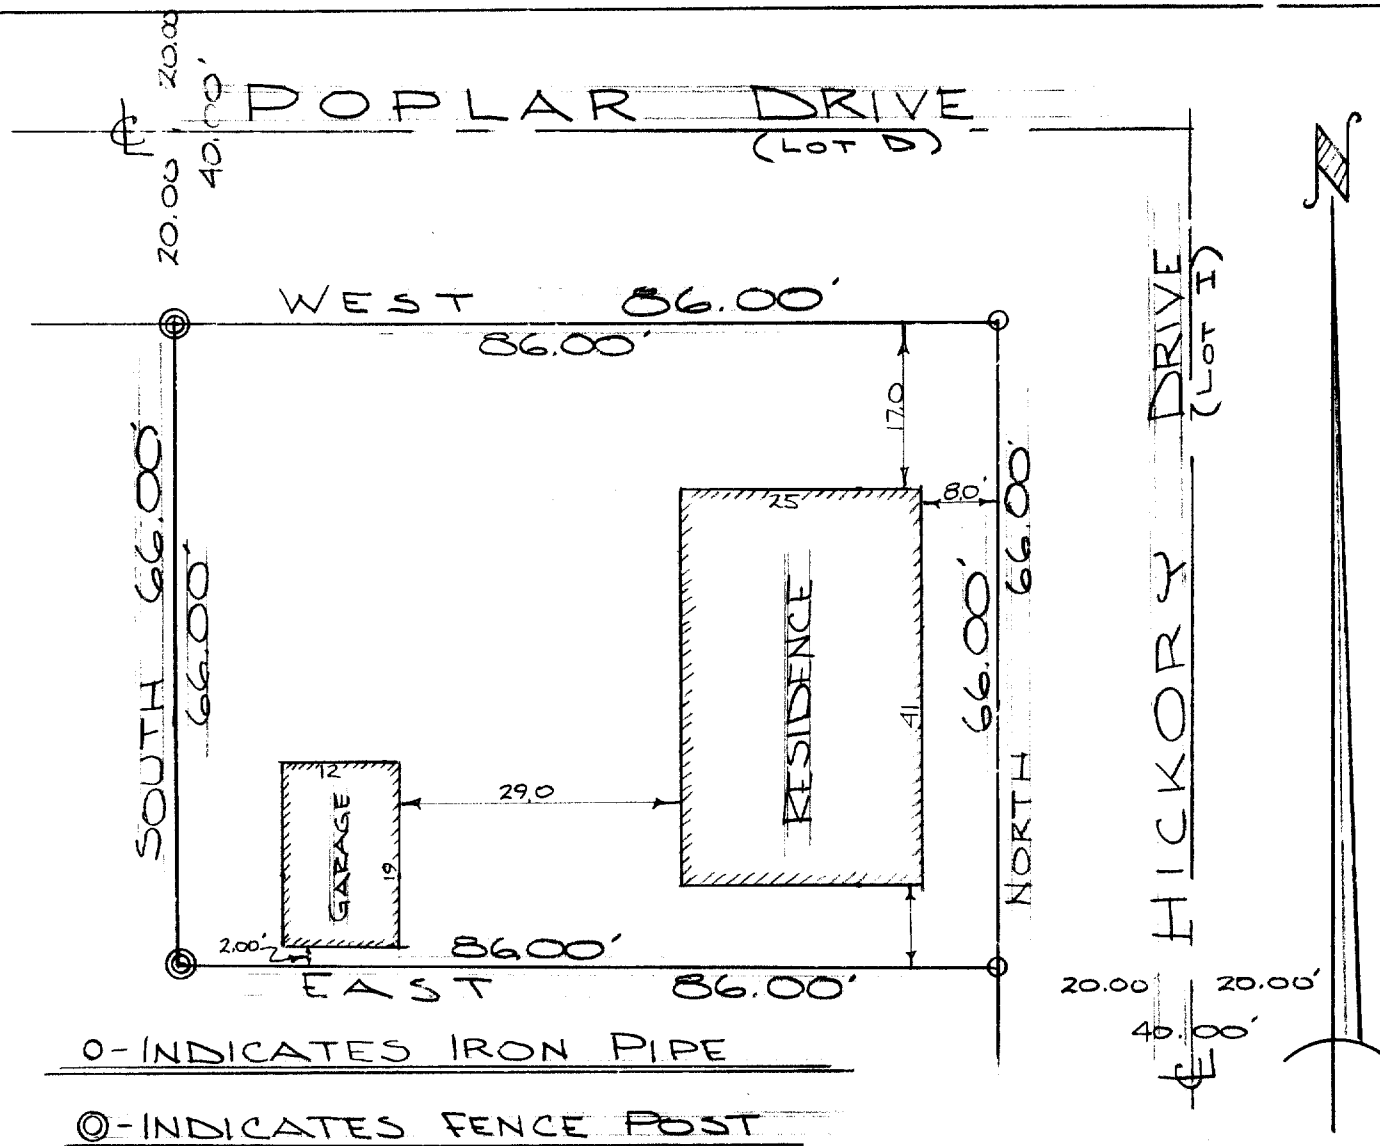

DESCRIPTION: Lot 69 of Robinson's 2nd. Subdivision located in Sections 11 and 14 of T. 1 N., R. 17 E., Walworth County, Wisconsin.

CERTIFICATE: I, James F. Biagi, surveyor, do hereby certify that I have surveyed the property hereon described, and that the location of the improvements are as shown.

September 29, 1968.

~~James F. Biagi, PLS 272~~