


11/20/2013 X:\Projects\6696\6696.dwg

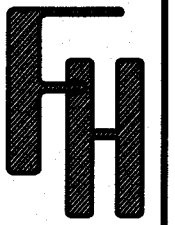


WORK ORDERED BY:
ROBERT DAVIS
W1561 LINN ROAD
LAKE GENEVA, WI. 53147

FARRIS, HANSEN & ASSOCIATES, INC.
ENGINEERING - ARCHITECTURE - SURVEYING
7 RIDGWAY COURT P.O. BOX 437
ELKHORN, WISCONSIN 53121
OFFICE: (262) 723-2098 FAX: (262) 723-5886

REVISIONS




PROJECT NO.
8696
DATE:
10-25-2012
SHEET NO.
1 OF 1

PLAT OF SURVEY
LOTS 11 THRU 15 OF BLOCK 5
TOGETHER WITH PART OF THE VACATED LAKEVIEW AVENUE
LAWRENCE ADDITION TO GENEVISTA SUBDIVISION
LOCATED IN THE SW 1/4 OF THE SW 1/4 SECTION 10
TOWN 1 NORTH, RANGE 17 EAST
WALWORTH COUNTY, WISCONSIN

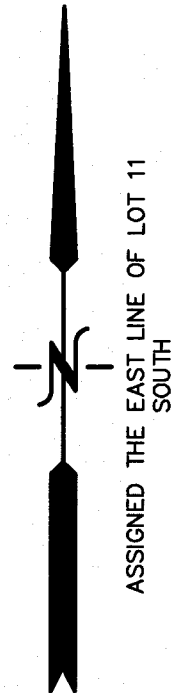

LEGEND

■ SET IRON REBAR STAKE
○ FOUND IRON PIPE STAKE
(XXX) - RECORDED AS

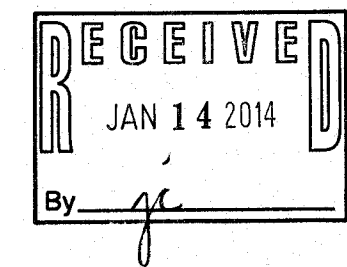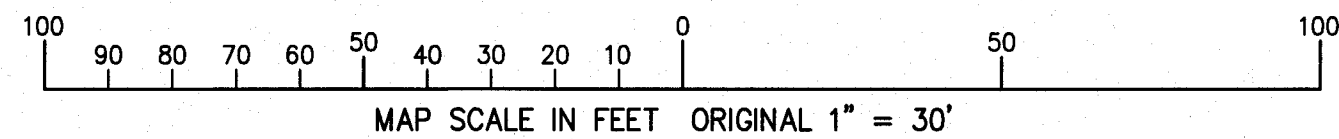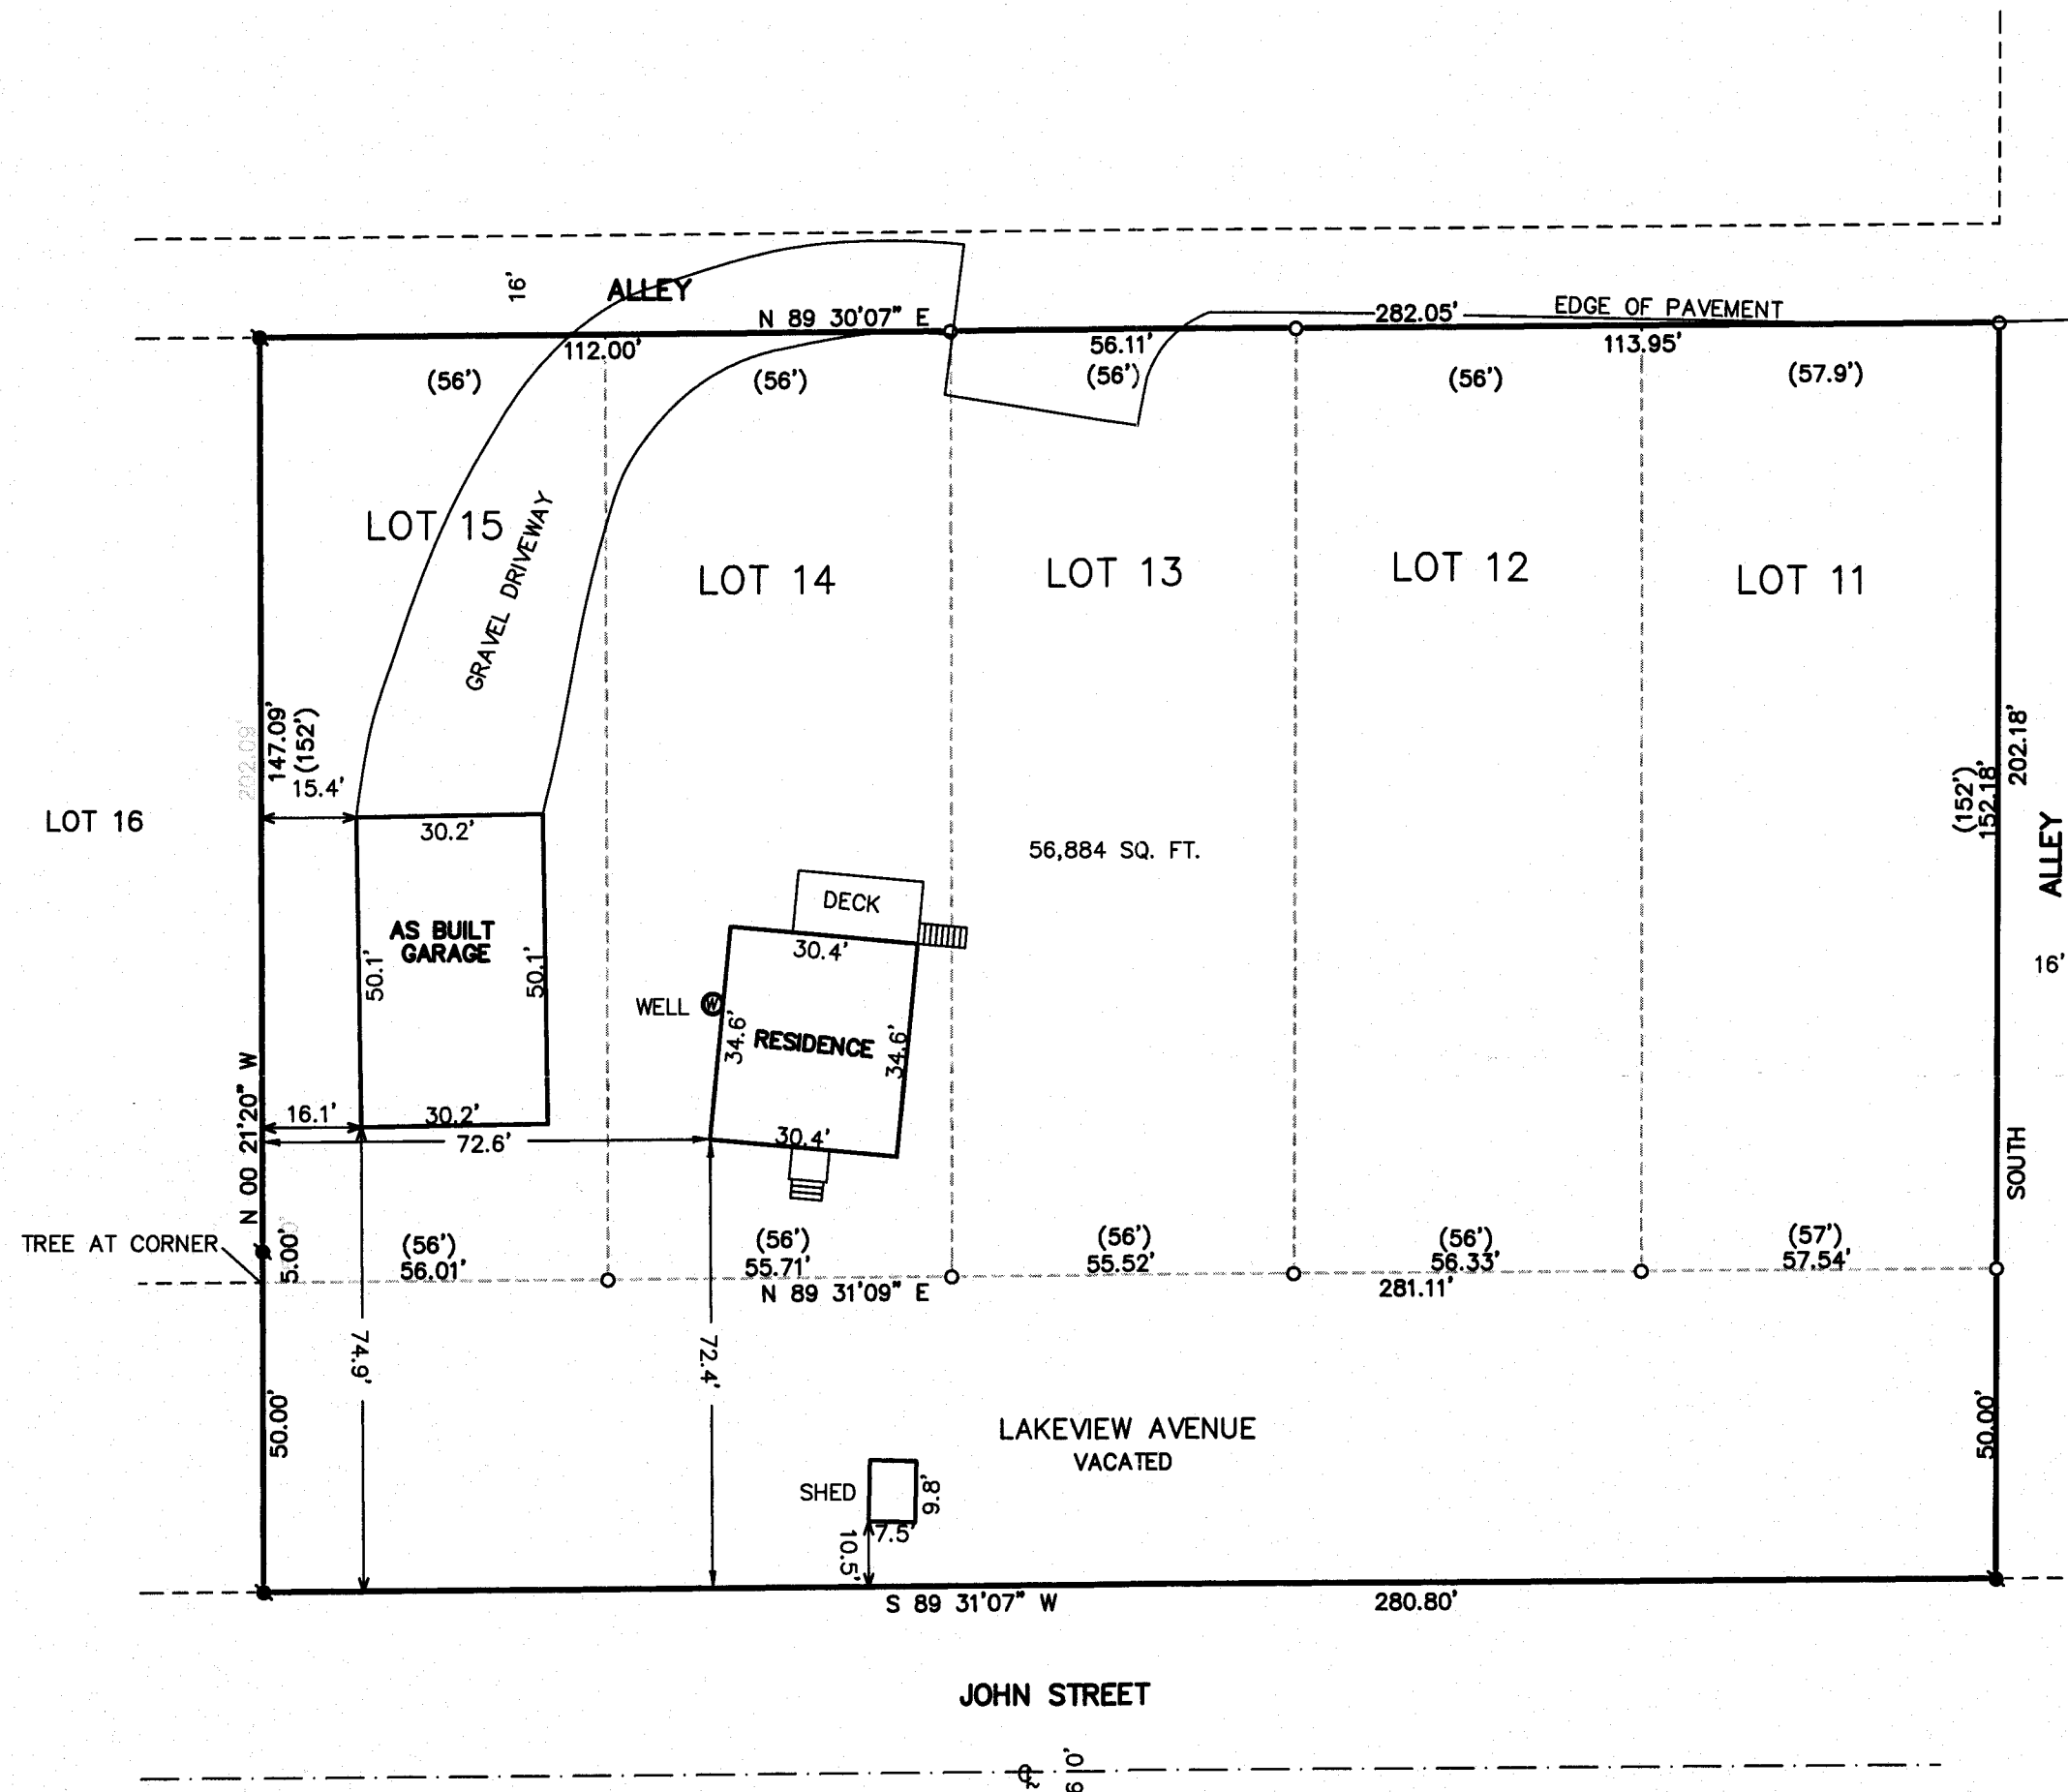

NOTE: COPIES OF THIS MAP TO WHICH THE FOLLOWING CERTIFICATE WILL APPLY SHOW THE SURVEYOR'S ORIGINAL SEAL AND SIGNATURE IN RED INK. COPIES BY ANY OTHER MEANS MAY HAVE ALTERATIONS WHICH DO NOT REPRESENT THE SURVEYOR'S WORK PRODUCT.

I HEREBY CERTIFY THAT THE ABOVE DESCRIBED PROPERTY HAS BEEN SURVEYED UNDER MY DIRECTION AND THAT THE ABOVE MAP IS A TRUE REPRESENTATION THEREOF AND SHOWS THE SIZE AND LOCATION OF THE PROPERTY AND ITS EXTERIOR BOUNDARIES. THIS SURVEY IS MADE FOR THE USE OF THE PRESENT OWNERS OF THE PROPERTY, AND ALSO THOSE WHO PURCHASE, MORTGAGE, OR GUARANTEE THE TITLE THERETO WITHIN ONE YEAR FROM THE DATE HEREOF.

DATED: 01-10-2013

REVISED 01-28-2013
ADJ. PRO. GARAGE LOCATION

REVISED 11-20-2013
TO SHOW SIZE & LOCATION OF
AS BUILT GARAGE

Peter S. Gordon
PETER S. GORDON R.L.S. 2101

IGVL -25A

117-3616