


PREPARED FOR
DAWN KOENIGSEDER
PRUENTIAL VISIONS REALTY
2020 US. 12
SPRING GROVE IL 60081

PLAT OF SURVEY OF



LOTS 1 AND 2 BLOCK 1, LAKE VIEW PARK SUBDIVISION, ACCORDING TO
THE RECORDED PLAT THEREOF, SAID LAND BEING IN THE TOWN OF LINN,
COUNTY OF WALWORTH AND STATE OF WISCONSIN.

KROTT SURVEYING INC.
(262) 248-3697
N 3705 WILLOW BEND LANE
LAKE GENEVA WI. 53147

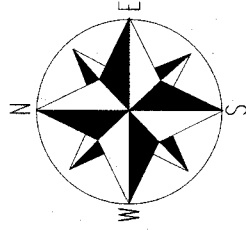

SCALE 1" = 20'

NOTE: BEARINGS ARE REFERENCED TO THE RECORD PLAT.

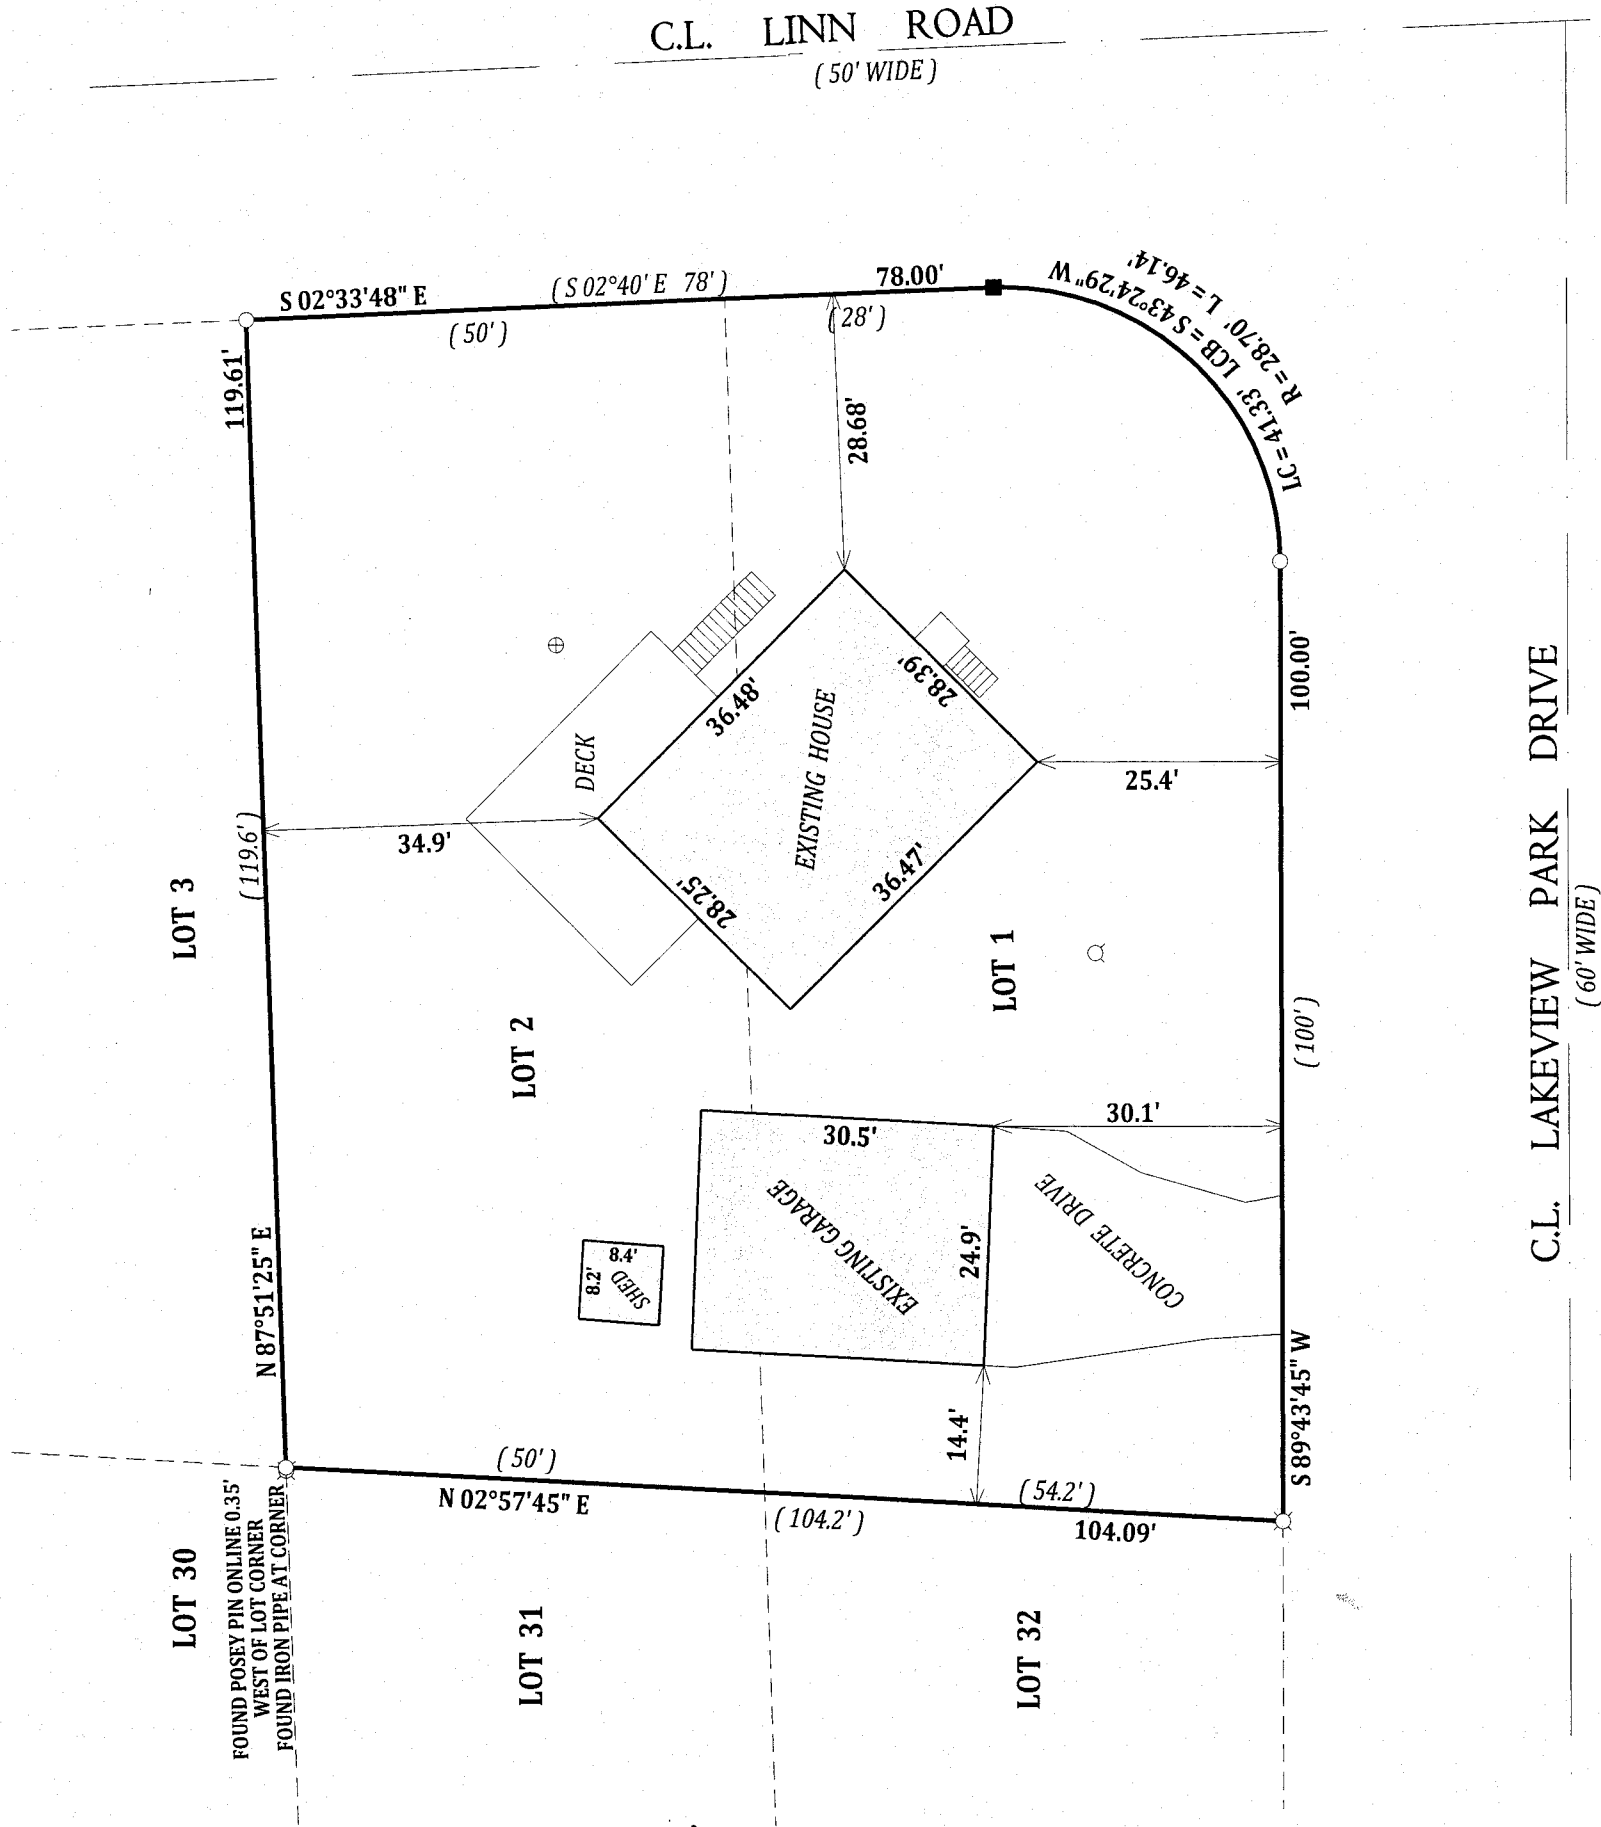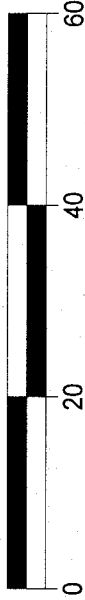



LEGEND

- FOUND IRON PIPE
- ⊗ FOUND POSEY PIN
- SET IRON BAR
- WELL
- ⊕ CONCRETE ACCESS COVER

(XX) RECORDED AS

TAX ID # ILVP0001

JOB # 13-188A

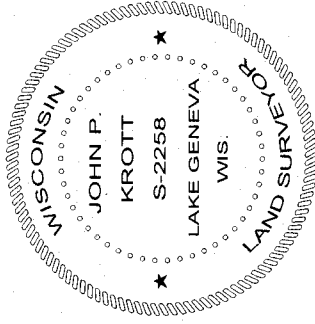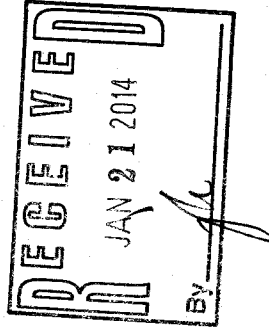

I have surveyed the above-described property and the above map is
a true representation thereof and shows the size and location of the
property, its exterior boundaries, the location and dimensions of all
structures thereon, fences apparent easements and roadways and
visible encroachments, if any.

This survey is made for the exclusive use of the present owners of
the property and also those who purchase, mortgage, or insure the
title thereto within one (1) year from date hereof; and as to them I
warrant the accuracy of said survey map.

DATED THIS 12th DAY OF DECEMBER 2013

John P. Krott

JOHN P. KROTT S-2258
WISCONSIN REGISTERED LAND SURVEYOR
(NOTE: THIS IS NOT A CERTIFIED COPY
UNLESS SIGNED IN RED INK)

ILVP -1 117-3623