



# PLAT OF SURVEY

Lot 6, Block 3, and the South Half of Lot 3, Block 3, of Lake Geneva Terrace, Being a subdivision of the West Half of the Northwest Quarter of Section 15, Township 1 North, Range 17 East of the Fourth Principal Meridian, Town of Linn, Walworth County, Wisconsin.

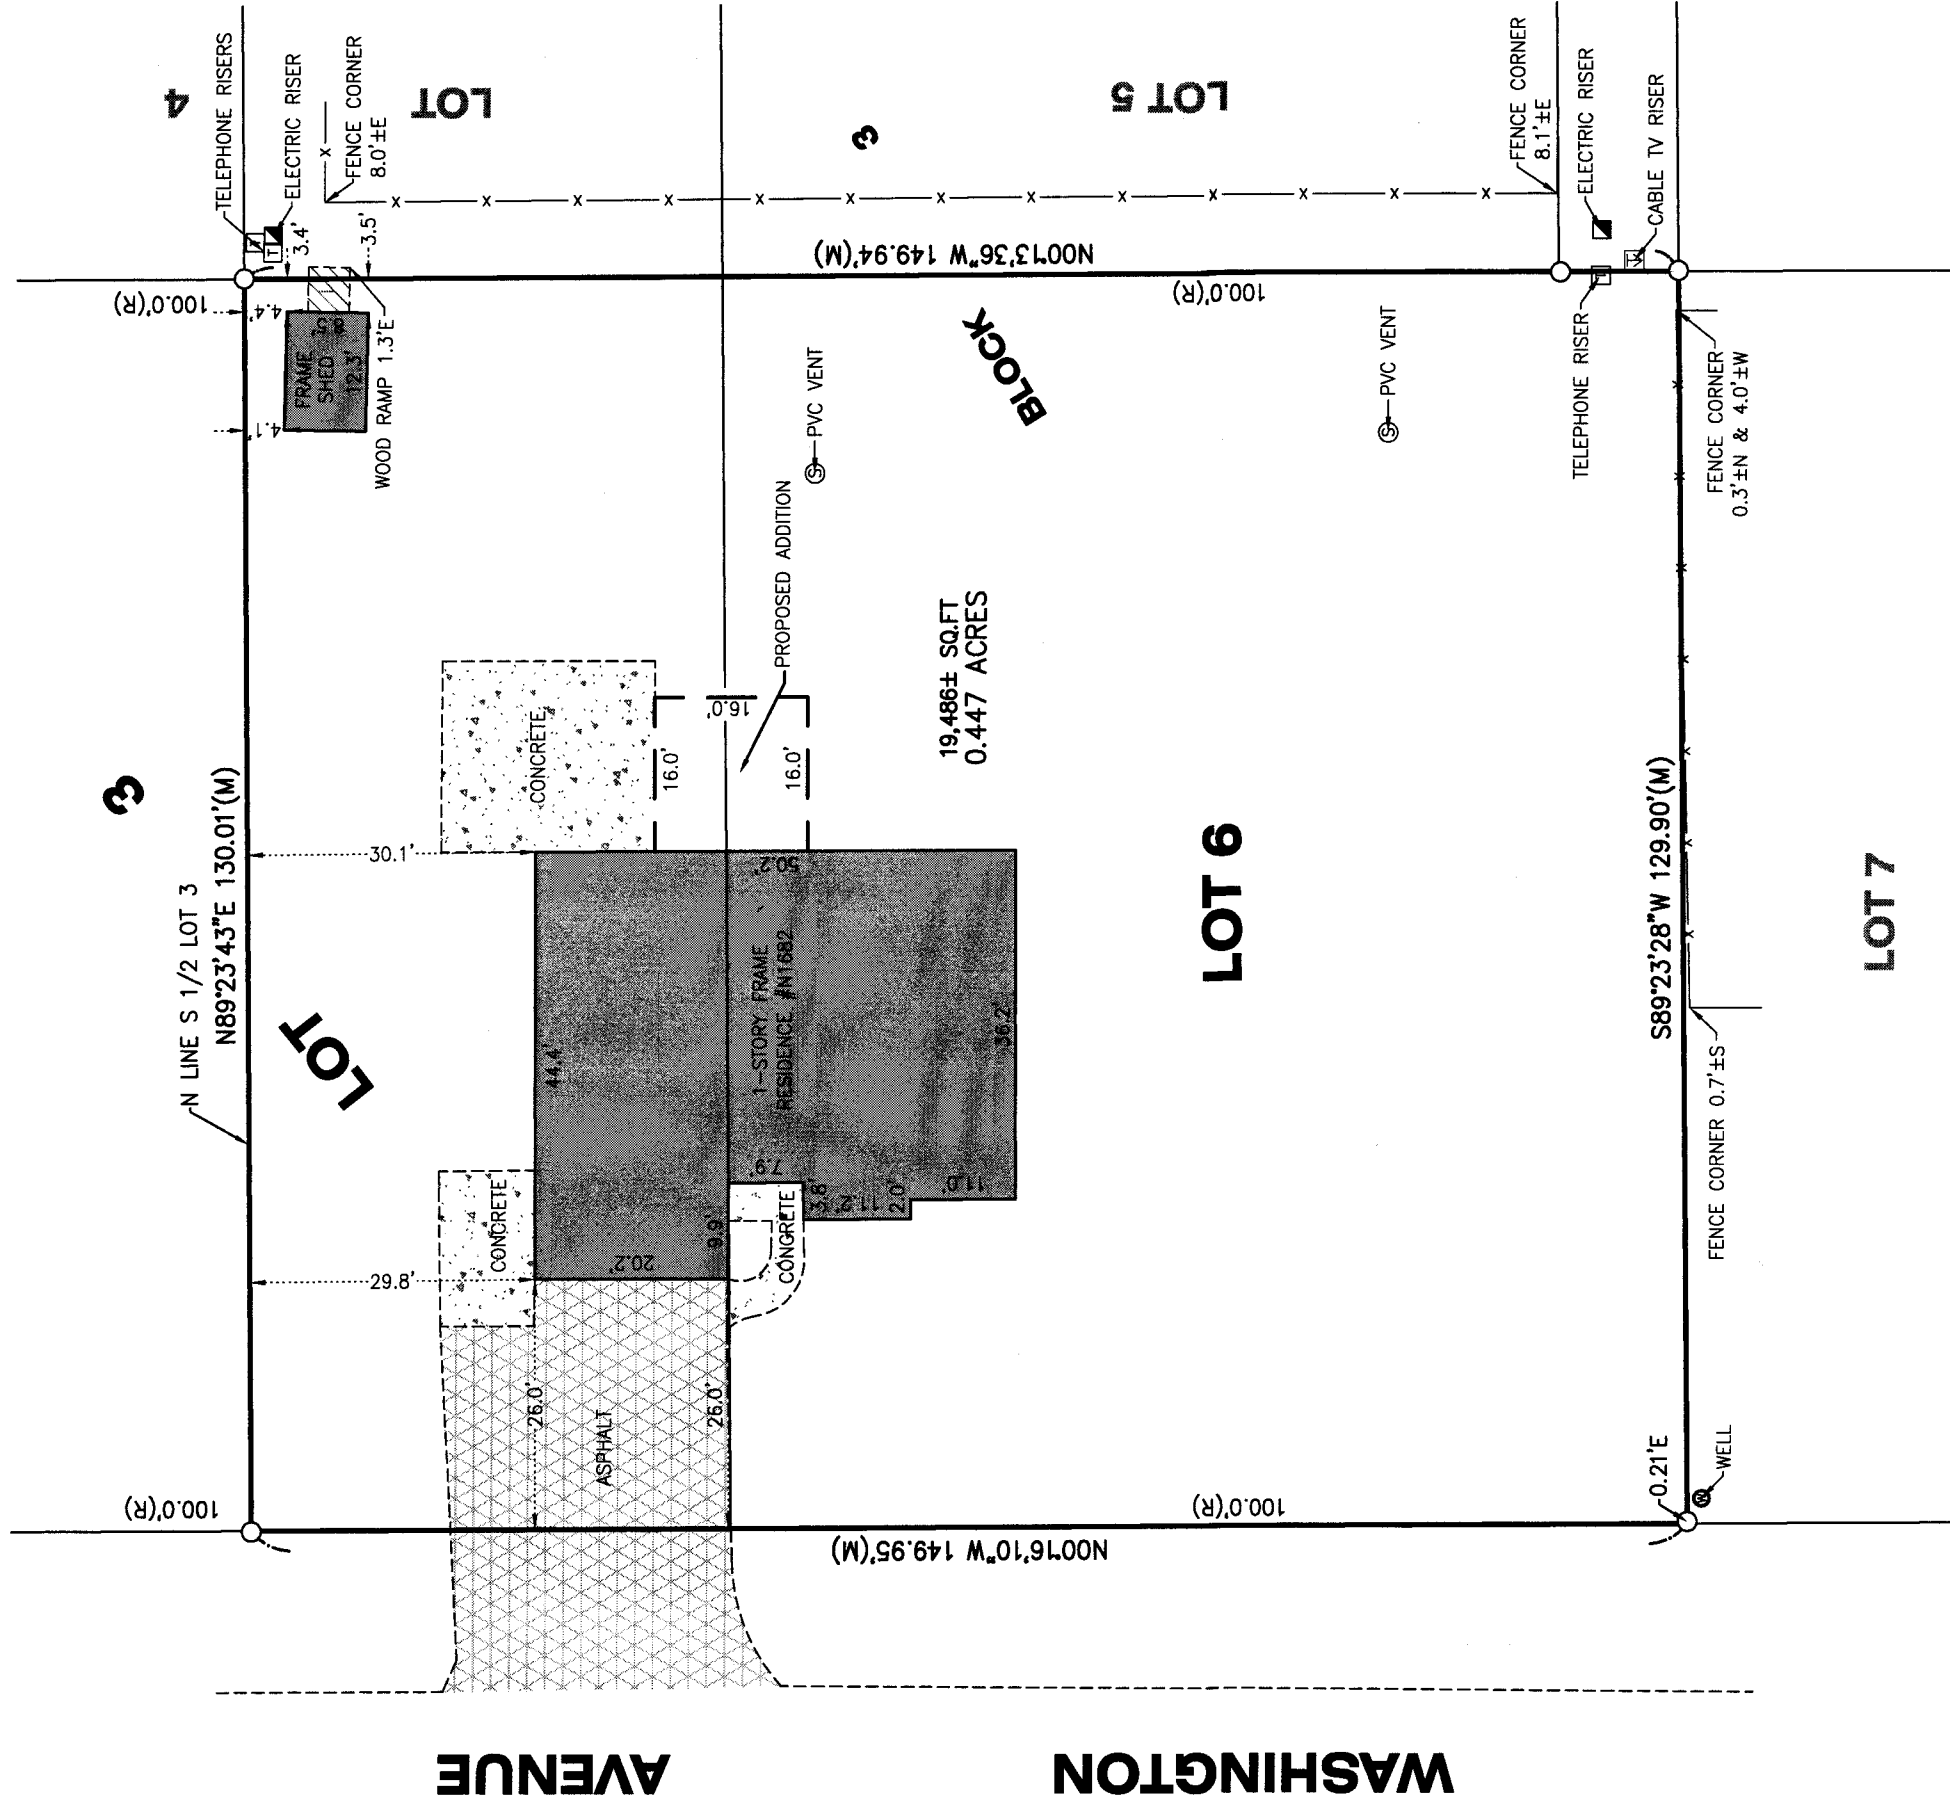

| LEGEND            |                     |
|-------------------|---------------------|
| ● FOUND IRON BAR  | ⊙ SET IRON BAR      |
| ⊗ FOUND NAIL      | ⊗ SET NAIL          |
| ⊙ FOUND SPIKE     | ⊙ SET SPIKE         |
| * FOUND CROSS     | ⊗ SET CROSS         |
| ○ FOUND IRON PIPE | ⊗ FOUND MONUMENT    |
| (M) MEASURED      | (D) DEED (R) RECORD |

CLIENT: JOHN VANDERSTAPPEN  
DRAWN BY: APG CHECKED BY: WJV  
SCALE: 1"=30' SEC. 15 T. 1 R. 17 E.  
BASIS OF BEARING: ASSUMED  
P.I.N.: ILGT 00009A1  
JOB NO.: 130190 I.D. LSS  
FIELDWORK COMP.: 4/18/13 BK. 96 PG. 45  
ALL DISTANCES SHOWN IN FEET AND DECIMAL REF.  
PARTS THEREOF CORRECTED TO 85° F.

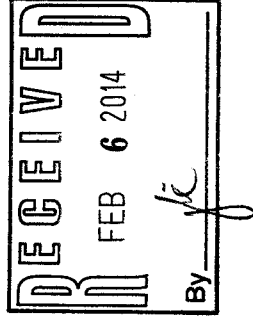

5/07/2013 REVISED PLAN PER OWNER WJV  
STATE OF ILLINOIS )  
COUNTY OF McHENRY ) S.S.

In my professional opinion and based on my observations, I hereby certify that the above described property has been surveyed under my direction and that the above map is a true representation thereof and shows the size and location of all visible structures, and dimensions of all principle buildings thereon, boundary fences, apparent easements, roadways, and visible encroachments, if any. This survey is made for the use of the present owners of the property, and also those who purchase, mortgage, or guarantee the title thereto within one year from the date hereof.

Dated at Woodstock,  
McHenry County, Illinois 4/26 A.D., 20 13.  
Vanderstappen Surveying & Engineering, Inc.  
Design Firm No. 184-002792

By: Wisconsin Registered Land Surveyor No. S1777