

Plat of Survey

of

Lots 1 & 2 in Block 8 of Genevista,


a subdivision located in the Southwest 1/4 of the Southwest 1/4 of Section 10,
Town 1 North, Range 17 East, Town of Linn, Walworth County, Wisconsin.

ALSO, a parcel of land described in an Abridgment of Judgment recorded in Vol. 593
on Page 271 as Document No. 243647, as shown below:
Beginning at the Northwest corner of Lot 1, Block 8, Genevista Subdivision; thence East
25 feet to the centerline of the vacated roadway; thence South 158 feet along the center-
line of said roadway; thence East 25 feet; thence North 158 feet along the West line of
said lot to the point of beginning.

ALSO, the North 1/2 of a portion of Alley vacated by Doc. No. 874961, in Block 8 of
Genevista, a subdivision located in the Southwest 1/4 of the Southwest 1/4 of Section
10, Town 1 North, Range 17 East, Town of Linn, Walworth County, Wisconsin.

Surveyed for: **Jean M. Barry Trust**


2729 North Dayton Street
Chicago, Illinois. 60614

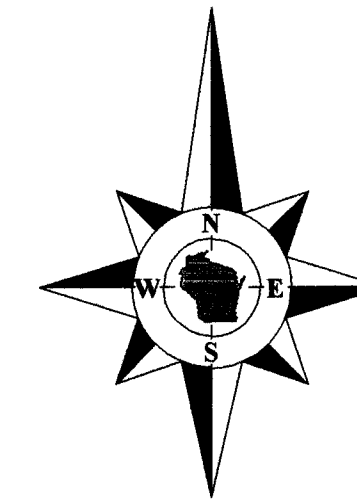

Bearings reference to previous
surveys of record.


Note:

Elevations and contours shown are based upon site measurements
taken prior to excavation for the new house and are no longer
accurate in areas where grading has taken place.

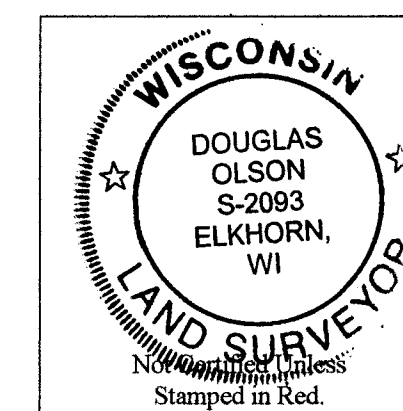

Notes:

- 1) This survey plat is not
certified unless signed
and sealed in red ink.
- 2) This survey is subject to Wisconsin lien laws.
This Plat of Survey is the notice of intent
to file lien. Lien waiver required.

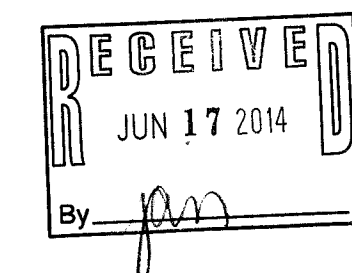

Copyright 2012 by Jensen & Olson Land Surveying, LLC.

All rights reserved. No part of this survey plat may be reproduced or transmitted in
any form by any means - graphic, electronic, or mechanical, including photocopying,
tracing, or information storage and retrieval systems - without permission in writing
from Douglas G. Olson, Jensen & Olson Land Surveying, LLC.

I, Douglas G. Olson, Wisconsin Registered Land Surveyor, do hereby certify
that this survey was performed by me, or under my direction in full compliance with
the owner's/agent's instructions and Chapter A-E 7 of the Wisconsin Administrative
Code "Minimum Standards for Property Surveys"; and that this map is an accurate
representation thereof to the best of my knowledge and belief.

Douglas G. Olson
Wisconsin Registered Land Surveyor - 2093

No. 6 - Alley Vacations
& Revised Garage
Location
No. 7 - Garage As-Built

Survey Date: July 27, 2012.
Revisions: No. 1 - Set Lath House
No. 2 - Pack & Garage
No. 3 - House Staking
& Benchmark
No. 4 - Foundation
No. 5 - Prop. Garage

Scale in Feet
1" = 20'
0 10' 20' 40'

Jensen & Olson Land Surveying, LLC
45 South Wisconsin Street * P.O. Box 322 * Elkhorn, Wisconsin. 53121
Telephone: (262) 723-3434 * Facsimile: (262) 723-8044
Email: jensen.olson@elknet.net

Legend
Location of
buried gas
line as
flagged by
Diggers
Found from
Record
Set Iron Pipe, 1" dia.
Set Wood Stake
Recorded Information
Utility Pole
Concrete Cover
Asphalt Surface
Concrete Surface
Gravel Surface

Sheet 1 of 1 Sheets
Drawing Name: Unit 7-2012058-2012058Plus.dwg
Job Reference Number
2012.058

2012.058

IGV -40A

117-3659