

# Plat of Survey

of

## Lots 1 & 2 in Block 8 of Genevista,


a subdivision located in the Southwest 1/4 of the Southwest 1/4 of Section 10,  
Town 1 North, Range 17 East, Town of Linn, Walworth County, Wisconsin.

ALSO, a parcel of land described in an Abridgment of Judgment recorded in Vol. 593  
on Page 271 as Document No. 243647, as shown below:  
Beginning at the Northwest corner of Lot 1, Block 8, Genevista Subdivision; thence East  
25 feet to the centerline of the vacated roadway; thence South 158 feet along the center-  
line of said roadway; thence East 25 feet; thence North 158 feet along the West line of  
said lot to the point of beginning.

ALSO, the North 1/2 of a portion of Alley vacated by Doc. No. 874961, in Block 8 of  
Genevista, a subdivision located in the Southwest 1/4 of the Southwest 1/4 of Section  
10, Town 1 North, Range 17 East, Town of Linn, Walworth County, Wisconsin.

Surveyed for: **Jean M. Barry Trust**


2729 North Dayton Street  
Chicago, Illinois. 60614

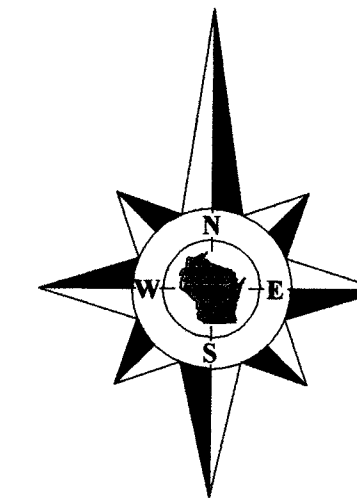

Bearings reference to previous  
surveys of record.


### Note:

Elevations and contours shown are based upon site measurements  
taken prior to excavation for the new house and are no longer  
accurate in areas where grading has taken place.

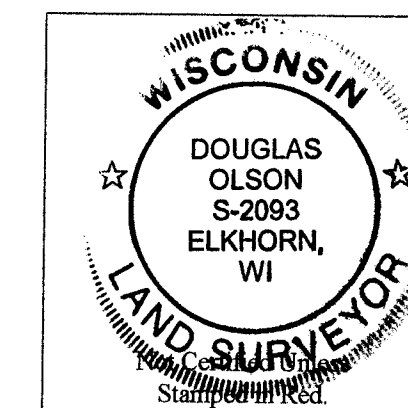

### Notes:

- 1) This survey plat is not  
certified unless signed  
and sealed in red ink.
- 2) This survey is subject to Wisconsin lien laws.  
This Plat of Survey is the notice of intent  
to file lien. Lien waiver required.

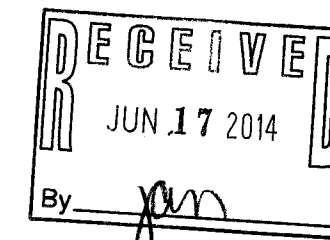


Copyright 2012 by Jensen & Olson Land Surveying, LLC.

All rights reserved. No part of this survey plat may be reproduced or transmitted in  
any form by any means - graphic, electronic, or mechanical, including photocopying,  
tracing, or information storage and retrieval systems - without permission in writing  
from Douglas G. Olson, Jensen & Olson Land Surveying, LLC.

I, Douglas G. Olson, Wisconsin Registered Land Surveyor, do hereby certify  
that this survey was performed by me, or under my direction in full compliance with  
the owner's/agent's instructions and Chapter A-E 7 of the Wisconsin Administrative  
Code "Minimum Standards for Property Surveys"; and that this map is an accurate  
representation thereof to the best of my knowledge and belief.

Douglas G. Olson  
Wisconsin Registered Land Surveyor - 2093

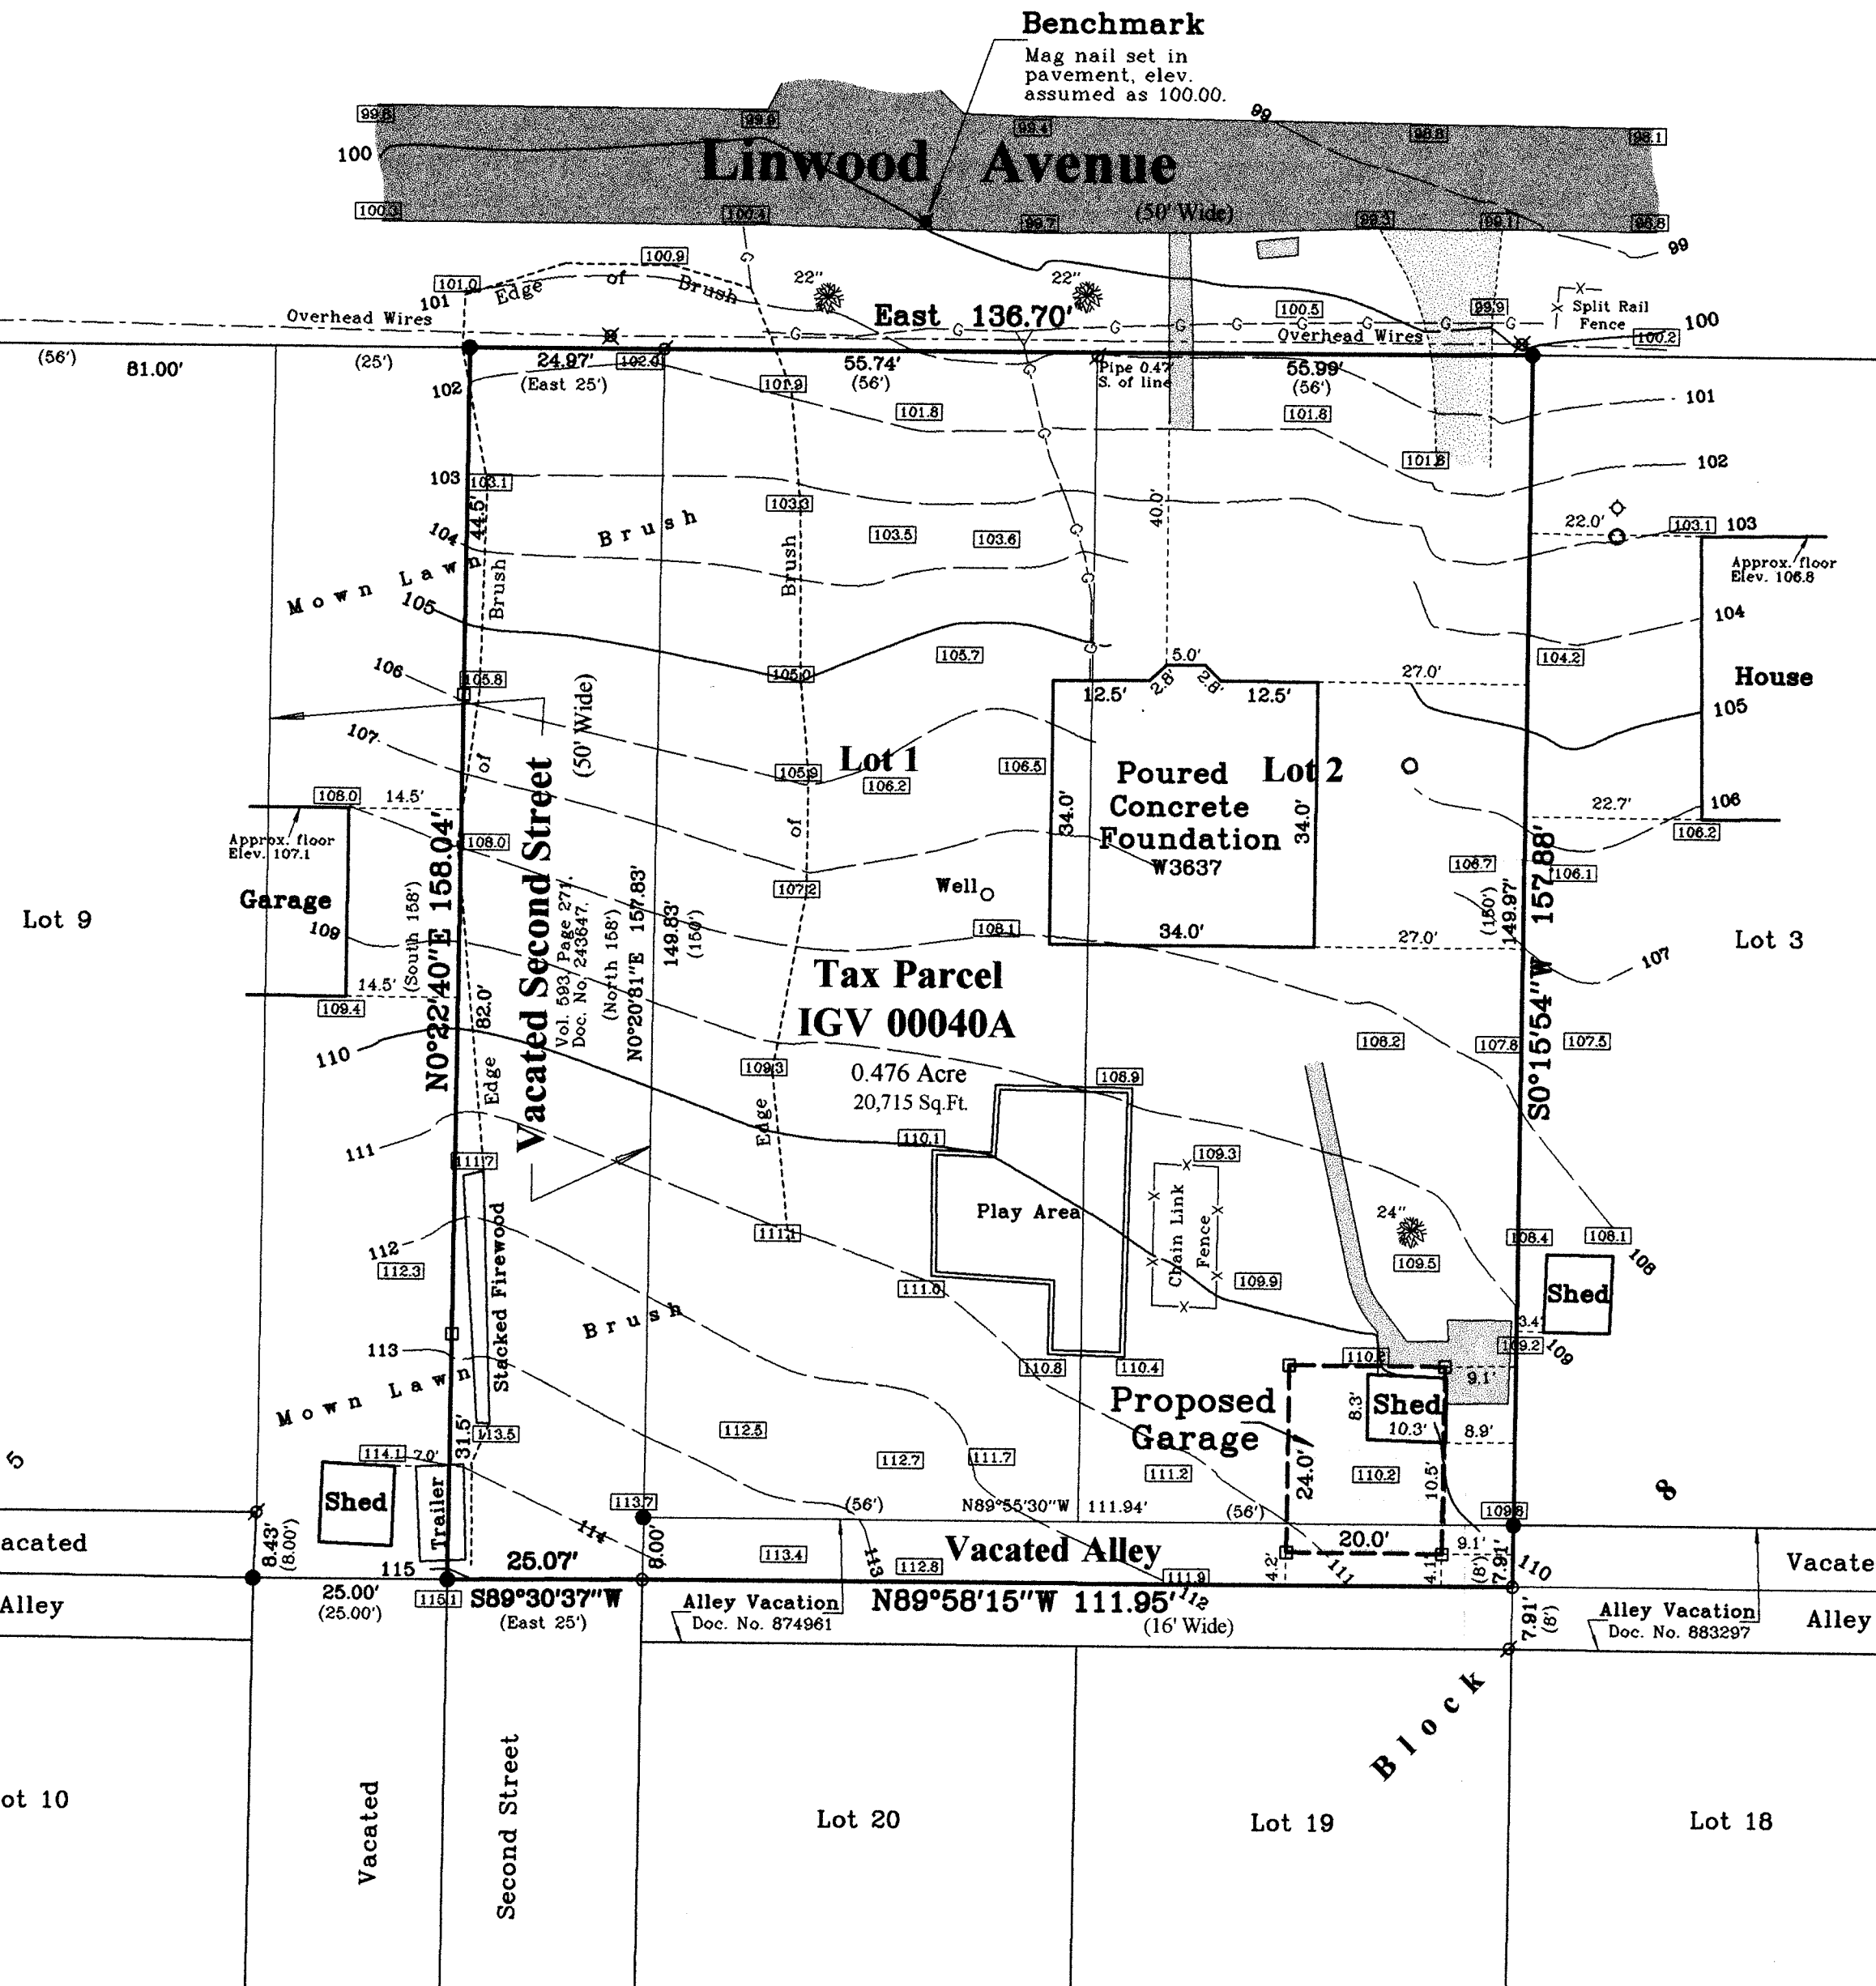

No. 6 - Alley Vacations  
& Revised Garage  
Location

Survey Date: July 27, 2012.  
Revisions: No. 1 - Set Lath House  
No. 2 - Proposed Garage  
No. 3 - House Slab  
& Benchmark  
No. 4 - Foundation  
No. 5 - Prop. Garage

Scale in Feet  
1" = 20'  
0 10' 20' 40'

**Jensen & Olson Land Surveying, LLC**

45 South Wisconsin Street \* P.O. Box 322 \* Elkhorn, Wisconsin. 53121  
Telephone: (262) 723-3434 \* Facsimile: (262) 723-8044  
Email: jensen.olson@elknet.net

Legend  
Location of  
buried gas  
line as  
flagged by  
diggers  
Found Iron Pipe  
Set Iron Pipe  
Set Wood Stake  
Recorded Information  
Utility Pole  
Concrete Cover  
Septic Tank  
Concrete Surface  
Gravel Surface

Sheet 1 of 1 Sheets  
Drawing Name: 117-2012058-2012058Plat.s  
Job Reference Number  
**2012.058**

**2012.058**

IGV - 40A

117-3664