
EGISTERED PROFESSIONAL LAND SURVEYOR



## PLAT OF SURVEY OF

Lot 7, Sunset Hills Shores Subdivision,
located in the Northwest & of Section 4,
T 1 N, R 17 E, Walworth County, Wisconsin.

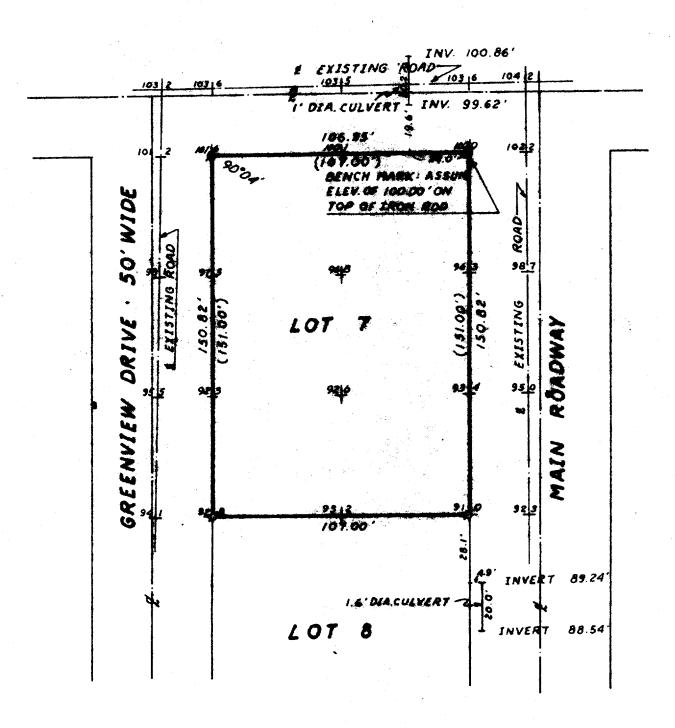

## LEGEND

S - IRON PIPE FOUND

o - mon PIPE PLACED

≠ Iron Rod Pound

I - SPORE

() - As Plarted



I, HAROLD H. KOLB, SO HEREBY GERTIFY THAT I HAVE SURVEYED THE PROPERTY HEREON DESCRISED ACCORDING TO THE OFFICIAL RECORDS, AND THAT THE PLAT HEREON IS A CORRECT REPRESENTATION OF THE LOT LIMES.

MANOLD H. KOLB

WISCONSIN REGISTERED LAND SURVEYOR, 8-167 DATE March 15, 1973