

Center 1/4 Corner
Section 18-1-17.
N. 202.327.01
E. 2,395,820.88

Sybil Lane
(15' Wide)

N1°54'39"W 49.92'

N89°23'02"E 803.62'

Lot 17
Tax Parcel
ICA 00016
0.069 Acre
2,991 Sq.Ft.

N87°55'38"E 59.97'

S87°50'28"W 59.97'

House

Poured
Concrete
Foundation

Proposed
Deck
With Roof

(50')
49.84'

Rod 0.17'
W. of line

S1°54'23"E 49.83'

Rod 0.30'
W. of line

(50')
49.74'

N1°54'23"W 982.01'

Rod 0.39'
W. of line

Tax Parcel
IL 1800007

Grassy Drive

N89°23'02"E 1316.33'

N89°30'42"E 2636.77'
(N89°30'42"E 2636.77') State Plane


Plat of Survey

of



Lot 17 of Camp Sybil,

a subdivision located in the Northeast 1/4 of Section 18, Town 1 North,
Range 17 East, Town of Linn, Walworth County, Wisconsin.

Surveyed for: **Fred & Cheri Moloznik**
9 Sun Valley Court
Lake in the Hills, Illinois. 60102

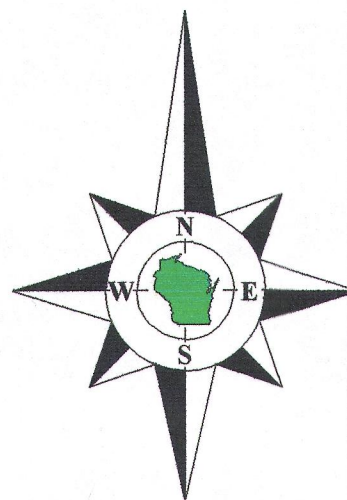

Bearings reference to the Wisconsin State
Plane Coordinate System, South Zone.

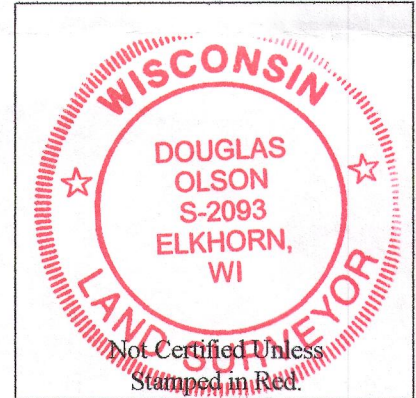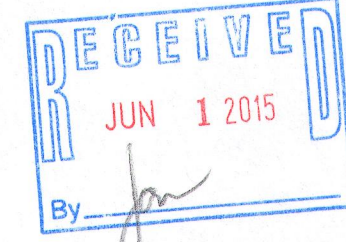

Notes:

- 1) This survey plat is not certified unless signed and sealed in red ink.
- 2) This survey is subject to Wisconsin lien laws. This Plat of Survey is the notice of intent to file lien. Lien waiver required.

Copyright 2012 by Jensen & Olson Land Surveying, LLC.

All rights reserved. No part of this survey plat may be reproduced or transmitted in any form by any means - graphic, electronic, or mechanical, including photocopying, tracing, or information storage and retrieval systems - without permission in writing from Douglas G. Olson, Jensen & Olson Land Surveying, LLC.

I, Douglas G. Olson, Wisconsin Registered Land Surveyor, do hereby certify that this survey was performed by me, or under my direction in full compliance with the owner's/agent's instructions and Chapter A-E 7 of the Wisconsin Administrative Code "Minimum Standards for Property Surveys"; and that this map is an accurate representation thereof to the best of my knowledge and belief.

Douglas G. Olson
Wisconsin Registered Land Surveyor - 2093

South 1/8 Corner of
the Northeast 1/4 of
Section 18-1-17.

East 1/4 Corner
Section 18-1-17.
N. 202,349.48
E. 2,398,457.54

No. 5 - Concrete
Foundation
No. 6 - AC removed

Survey Date: Sept. 14, 2012.
Revisions: No. 1 - Misc. Info.
No. 2 - Proposed House
& Deck
No. 3 - Existing House
etc. removed
No. 4 - Proposed House
& Deck 2014

Scale in Feet
1" = 10'

Jensen & Olson Land Surveying, LLC
45 South Wisconsin Street * P.O. Box 322 * Elkhorn, Wisconsin. 53121
Telephone: (262) 723-3434 * Facsimile: (262) 723-8044
Email: jensen.olson@elknet.net

Legend
Found County Section Corner
Found Iron Pipe
Found Iron Rod
Set Mag Nail
Recorded Information
Utility Pedestal
Utility Pole
Asphalt Surface
Concrete Surface
Gravel
Gravel

Sheet 1 of 1 Sheets
Job Reference Number
2014.137

2014.137

ICA-16 117-3786