


FARRIS, HANSEN & ASSOCIATES, INC.

ENGINEERING — ARCHITECTURE — SURVEYING
7 RIDGWAY COURT — P.O. BOX 437 — ELKHORN, WISCONSIN 53121
PHONE: (262) 723-2098 FAX: (262) 723-5886



PLAT OF SURVEY

LOTS 6 & 7, BLOCK 8 GENEVISTA SUBDIVISION
LOCATED IN THE SW 1/4 OF THE SW 1/4 SEC. 10
TOWN 1 NORTH, RANGE 17 EAST
WALWORTH COUNTY, WI.

— WORK ORDERED BY —
UTESCH CONSTRUCTION
PO BOX 305
WALWORTH, WI. 53184

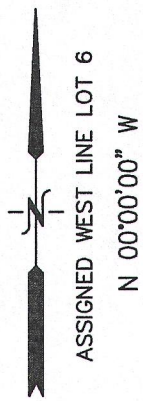

LINWOOD AVENUE

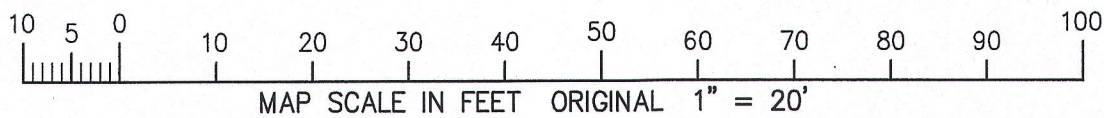
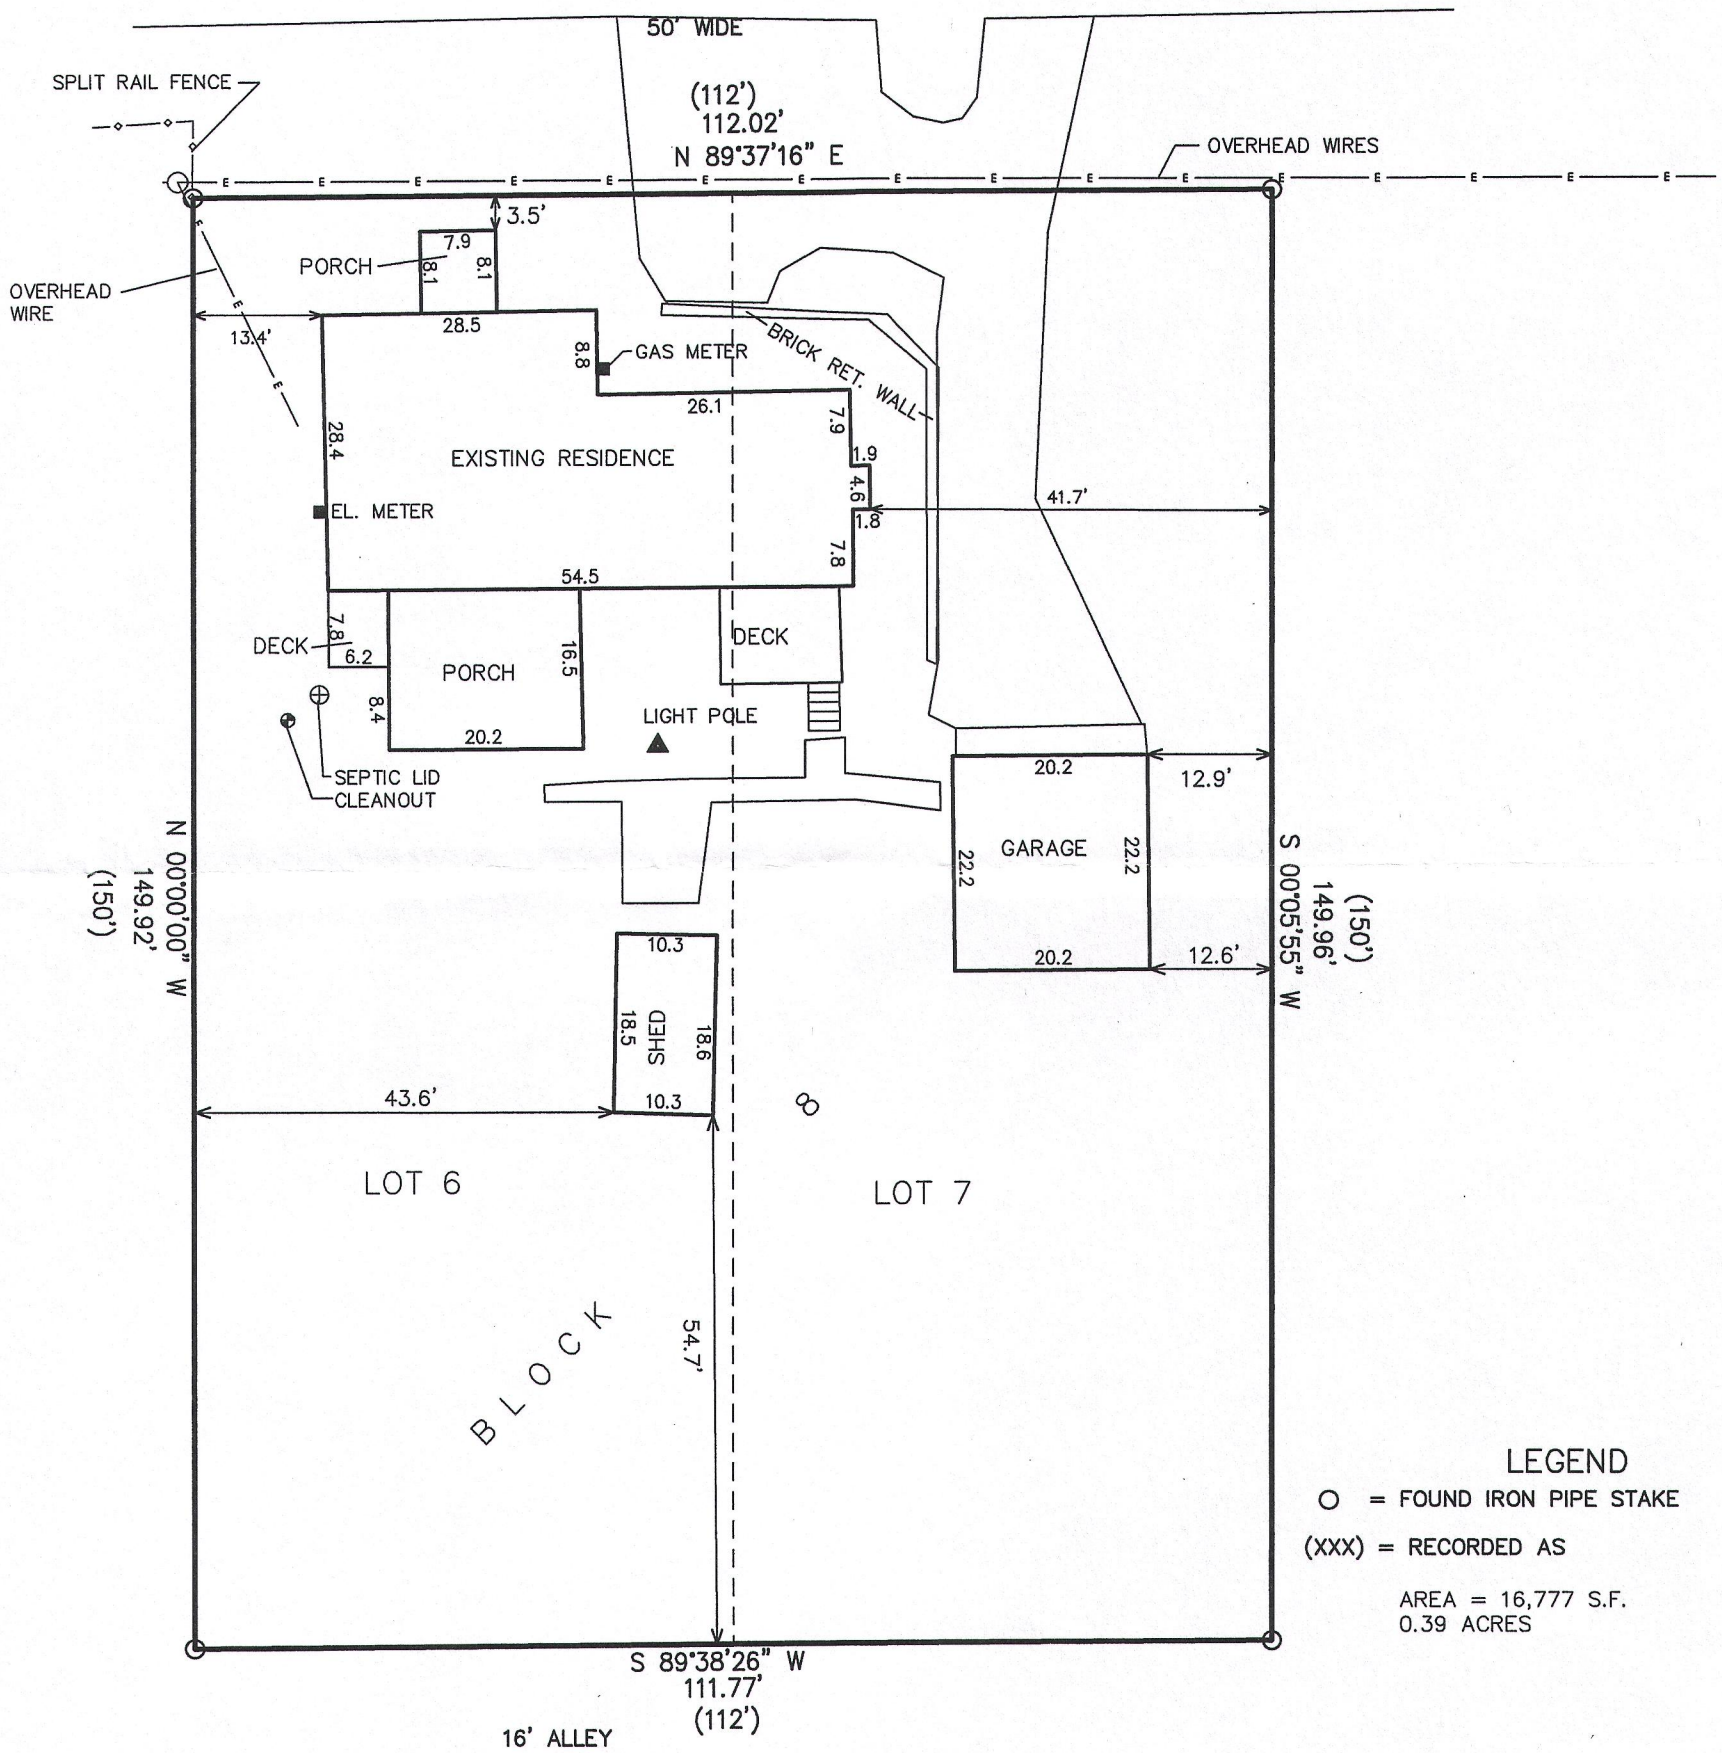


NOTE: COPIES OF THIS MAP TO WHICH THE FOLLOWING CERTIFICATE WILL APPLY SHOW THE SURVEYOR'S ORIGINAL SEAL AND SIGNATURE IN RED INK. COPIES BY ANY OTHER MEANS MAY HAVE ALTERATIONS WHICH DO NOT REPRESENT THE SURVEYOR'S WORK PRODUCT.

I HEREBY CERTIFY THAT THE ABOVE DESCRIBED PROPERTY HAS BEEN SURVEYED UNDER MY DIRECTION AND THAT THE ABOVE MAP IS A TRUE REPRESENTATION THEREOF AND SHOWS THE SIZE AND LOCATION OF THE PROPERTY AND ITS EXTERIOR BOUNDARIES. THIS SURVEY IS MADE FOR THE USE OF THE PRESENT OWNERS OF THE PROPERTY, AND ALSO THOSE WHO PURCHASE, MORTGAGE, OR GUARANTEE THE TITLE THERETO WITHIN ONE YEAR FROM THE DATE HEREOF.

DATED: MARCH 26, 2015

PETER S. GORDON P.L.S. 2101

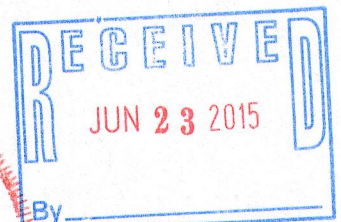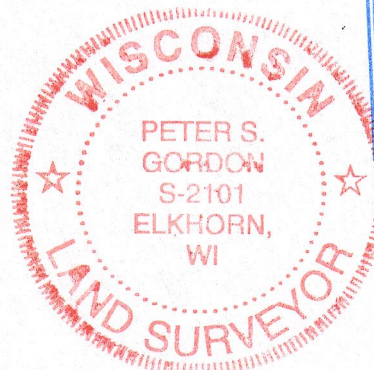

PROJECT: 9248
DATE: 03-25-2015
SHEET 1 OF 1

MAR 26 2015

IGV-43

117-3801