PREPARED FOR: SALLY EDELMAN

)= recorded as

= found iron bar

= found iron pipe

= set iron pipe

= set iron bar

TAX ID # ISHS-00010

SCALE 1" = 20'

JOB # 02-271

20

PLAT OF SURVEY

- OF -LOT 10 SUNSET HILLS SHORES, BEING A SUBDIVISION LOCATED IN TOWN 1 NORTH, RANGE 17 EAST, WALWORTH COUNTY, WISCONSIN. PATHFINDER SURVEYING INC.


(formerly)

J.K. SURVEYING INC.

P.O BOX 322

LAKE GENEVA, WI. 53147

WWW.PATHFINDERSURVEYING.NET
262-248-8303

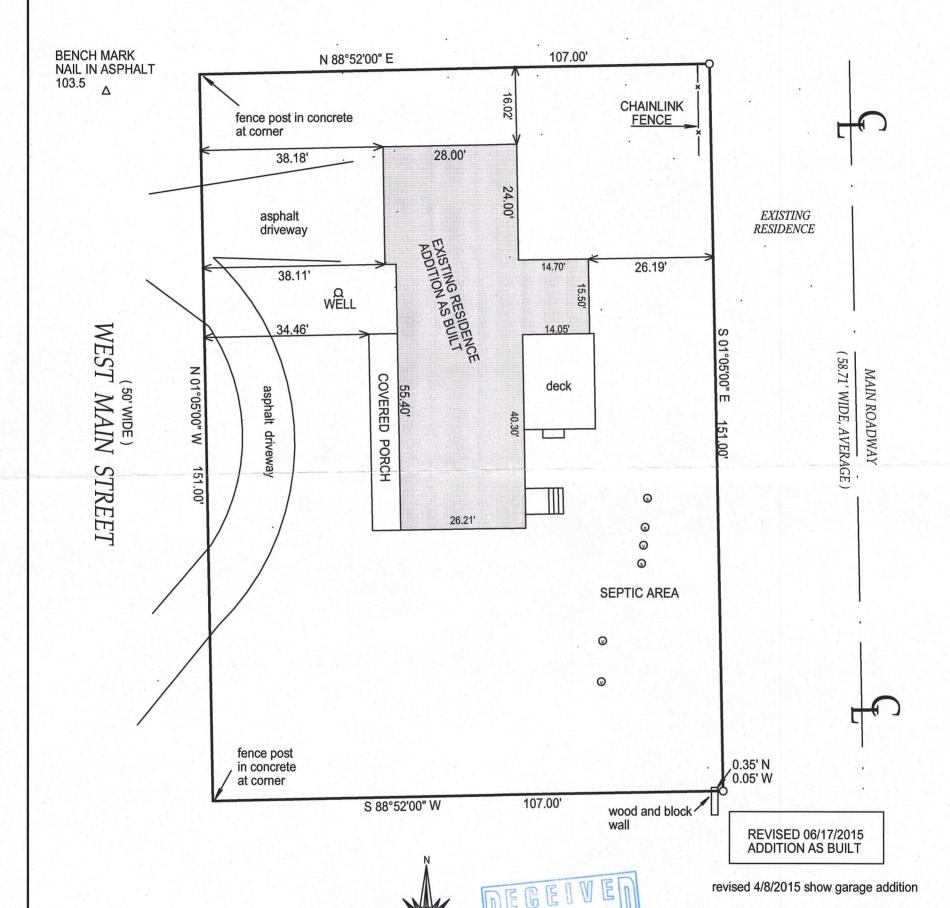

"I hereby certify that I have surveyed the above described property and that the above map is a true representation thereof and shows the size and location of all visible structures, apparent easements and encroachments if any."

BASIS OF BEARING OF THIS PLAT: THE EAST LINE OF WEST MAIN ST. WAS ASSUMED TO BEAR N 01°05'00" W.

This survey is made for the present owners of the property, and those who purchase, mortgage, or guarantee the title thereto, within one year from the date hereof.

DATED THIS 17 TH, DAY OF JUNE 20 02 .

JEFFREY L KIMPS S - 2436 Wisconsin Registered Land Surveyor (original if signed in red)

SUR

REVISED 9/17/2014 ADDED TOPOGRAPHY AND

SHOW VISI BLE CHANGES.

REVISED JULY 30, 2002 DATE OF LAST REVISION 01-07-03