

PLAT OF SURVEY  
-OF-

LOTS 1 AND 2 OF CERTIFIED SURVEY MAP NO. 3361, AS RECORDED IN THE OFFICE OF THE REGISTER OF DEEDS FOR WALWORTH COUNTY, WISCONSIN ON OCTOBER 5, 2001 IN VOLUME 19 OF CERTIFIED SURVEY MAPS ON PAGES 124-126 AS DOCUMENT NO. 485128 AND LOCATED IN THE SOUTHEAST 1/4 OF THE NORTHEAST 1/4 OF SECTION 9, TOWNSHIP 1 NORTH, RANGE 17 EAST OF THE FOURTH PRINCIPAL MERIDIAN, IN THE TOWN OF LINN, COUNTY OF WALWORTH AND STATE OF WISCONSIN.

SURVEY FOR: CHERYL HANSEN OF RE/MAX GENEVA REALTY  
SURVEY ADDRESS: N1931 SOLAR LANE, LAKE GENEVA, WI 53147


NOTE: REFER TO A CURRENT TITLE REPORT FOR EASEMENTS, RESTRICTIONS OR COVENANTS WHICH MAY AFFECT THIS PROPERTY.

LEGEND

- ⊙ FOUND AXLEROD
- FOUND IRON REBAR
- FOUND IRON PIPE
- + FOUND CHISELED CROSS-CUT
- ⌵ UTILITY POLE
- ( ) RECORDED AS

CURVE DATA

|                                       |
|---------------------------------------|
| C1                                    |
| RADIUS = 35.00'                       |
| CENTRAL ANGLE = 84°26'03" (84°18'00") |
| CHORD = 47.04' (46.98')               |
| CHORD BEARING = S21°32'46"E           |
| C2                                    |
| RADIUS = 28.70'                       |
| CENTRAL ANGLE = 109°13'04"            |
| CHORD = 46.79'                        |
| CHORD BEARING = S07°33'20"W           |
| C3                                    |
| RADIUS = 737.86'                      |
| CENTRAL ANGLE = 35°21'46"             |
| CHORD = 448.21'                       |
| CHORD BEARING = S79°24'00"W           |
| C4                                    |
| RADIUS = 737.86'                      |
| CENTRAL ANGLE = 20°28'58"             |
| CHORD = 262.38'                       |
| CHORD BEARING = S71°57'34"W           |
| C5                                    |
| RADIUS = 737.86'                      |
| CENTRAL ANGLE = 14°52'48"             |
| CHORD = 191.09'                       |
| CHORD BEARING = S89°38'32"W           |

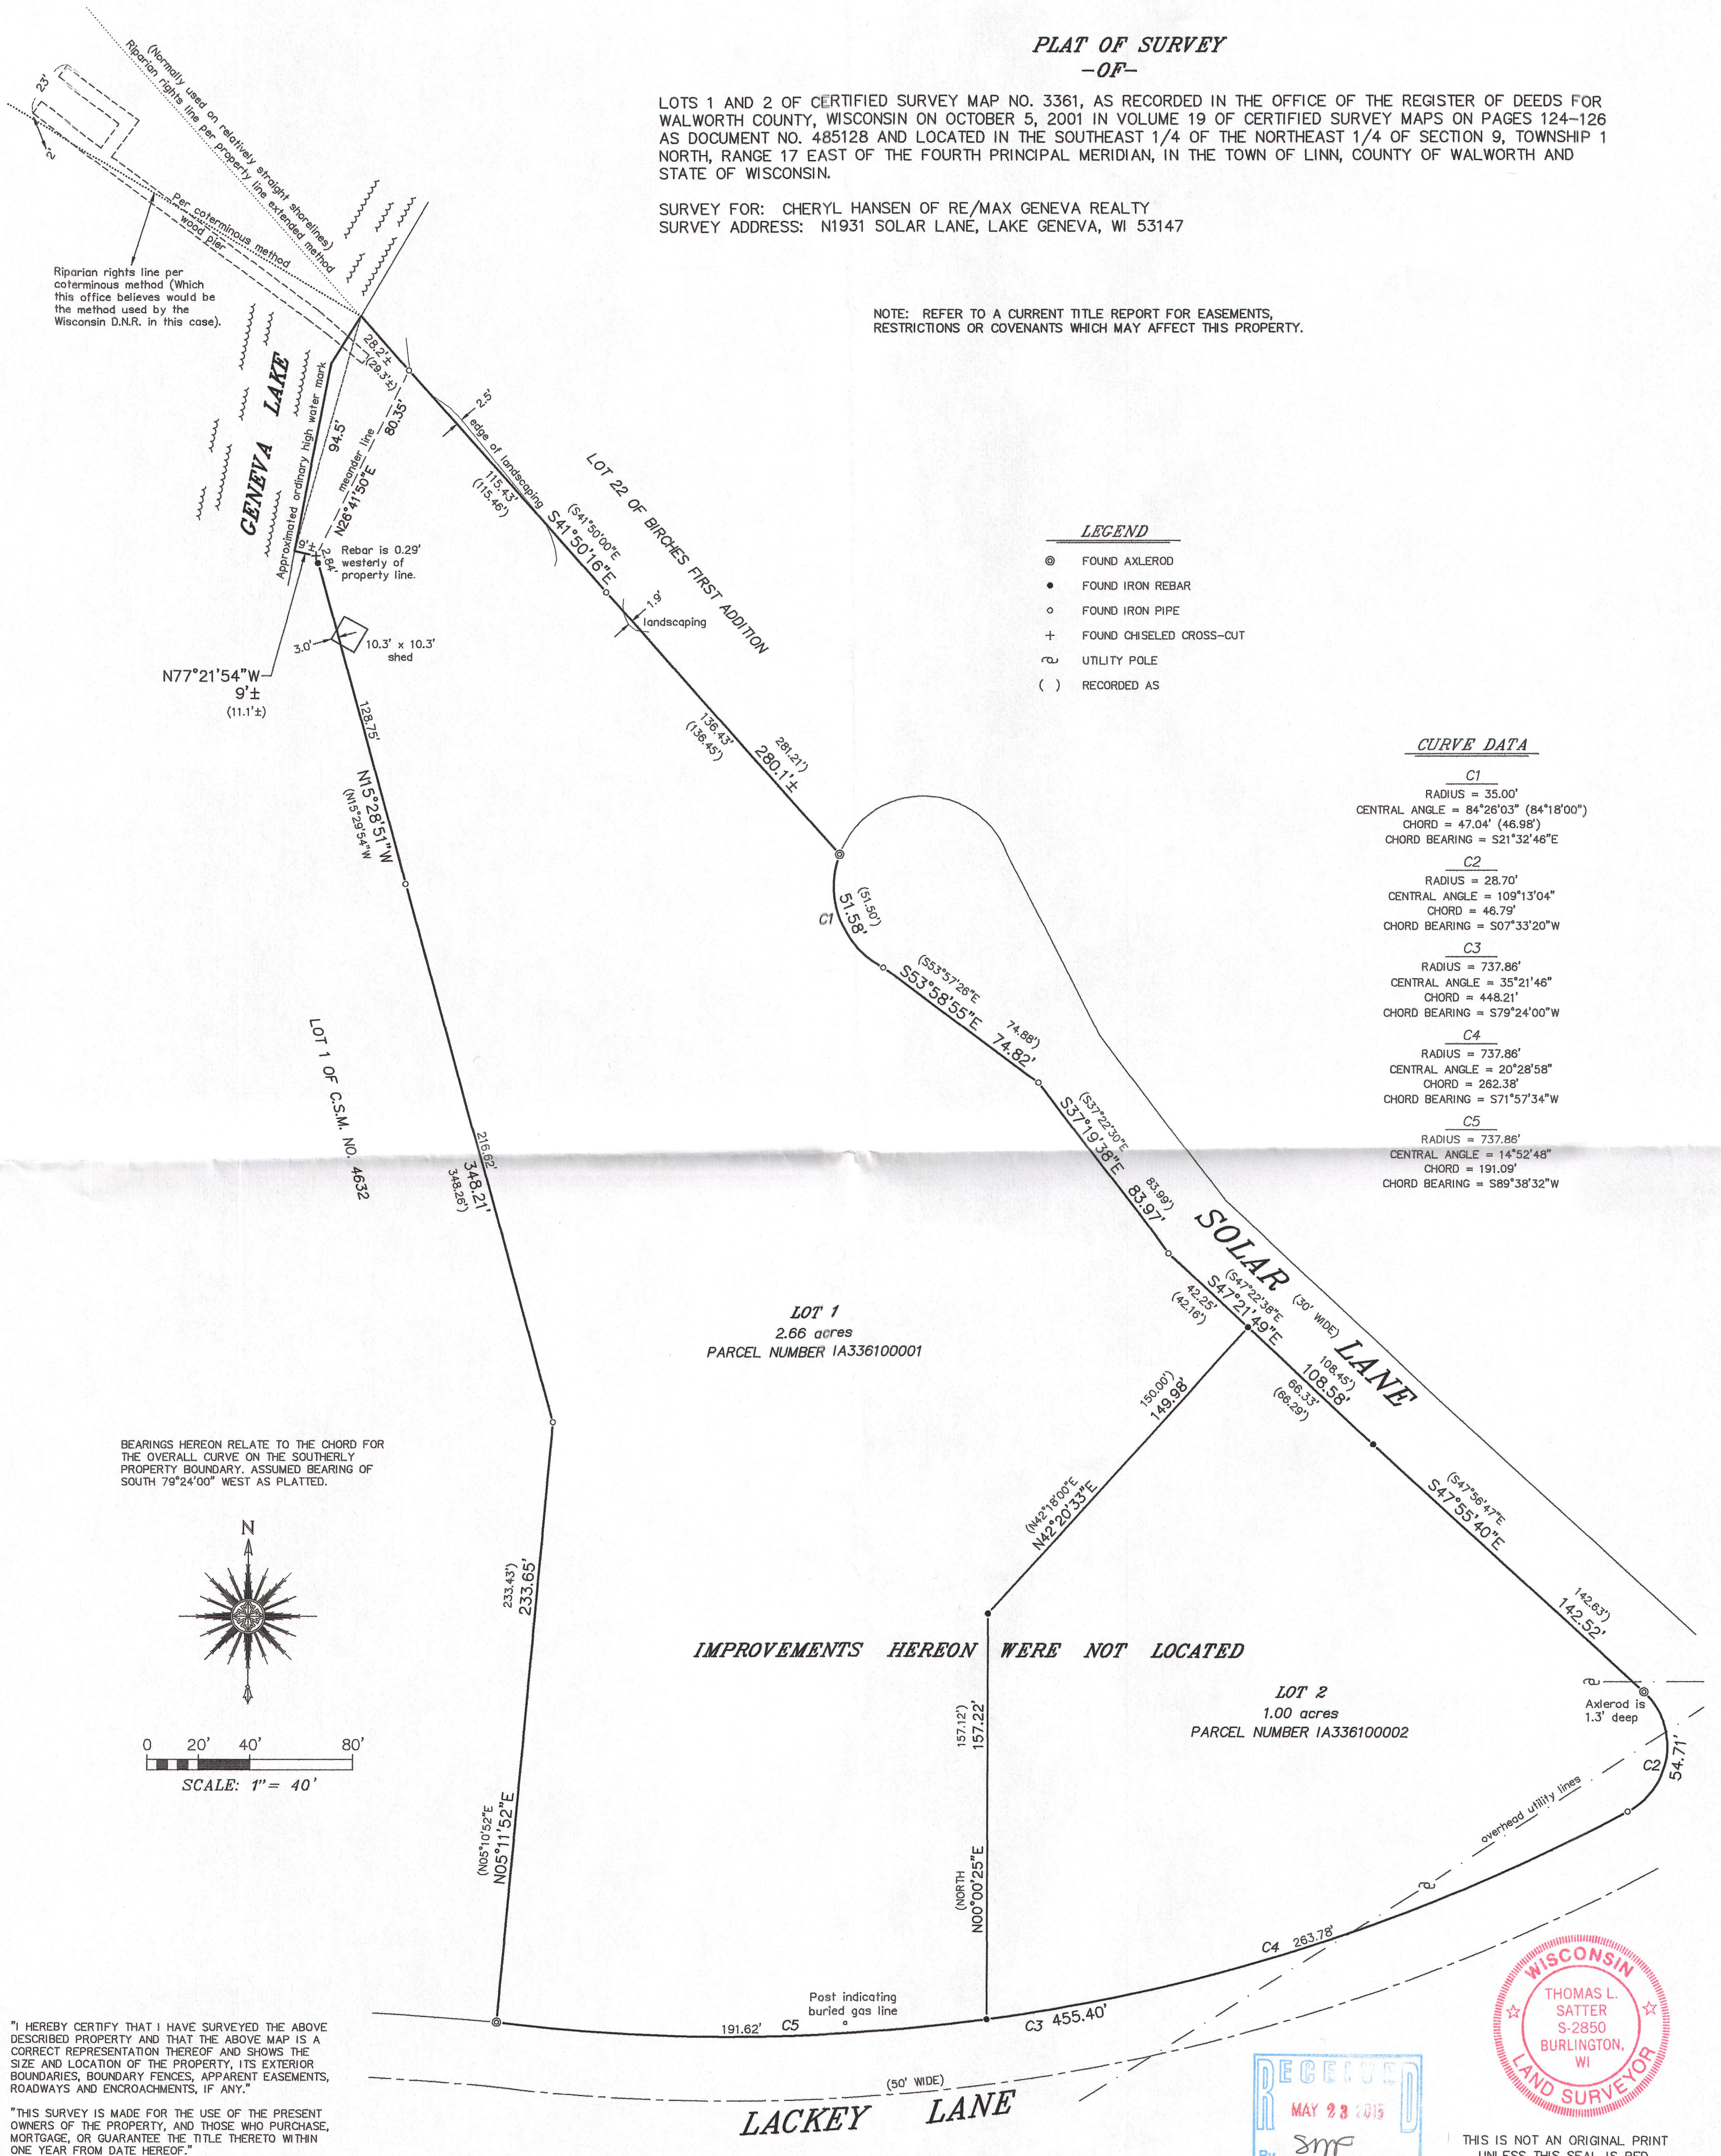


"I HEREBY CERTIFY THAT I HAVE SURVEYED THE ABOVE DESCRIBED PROPERTY AND THAT THE ABOVE MAP IS A CORRECT REPRESENTATION THEREOF AND SHOWS THE SIZE AND LOCATION OF THE PROPERTY, ITS EXTERIOR BOUNDARIES, BOUNDARY FENCES, APPARENT EASEMENTS, ROADWAYS AND ENCROACHMENTS, IF ANY."

"THIS SURVEY IS MADE FOR THE USE OF THE PRESENT OWNERS OF THE PROPERTY, AND THOSE WHO PURCHASE, MORTGAGE, OR GUARANTEE THE TITLE THERETO WITHIN ONE YEAR FROM DATE HEREOF."

SATTER SURVEYING, LLC

LAND SURVEYS, MAPPING AND PLANNING  
272 ORIGIN STREET  
BURLINGTON, WI 53105  
262-661-4239

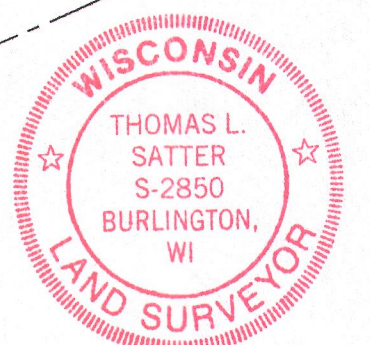

THIS IS NOT AN ORIGINAL PRINT UNLESS THIS SEAL IS RED.

Thomas L. Satter  
THOMAS L. SATTER S-2850

MAY 19, 2016  
DATE  
051604  
JOB NUMBER

117-3910