

F

JANCIK RESIDENCE
N1848 CAIN LANE

— WORK ORDERED BY —
JEFF JANCIK
N1848 CAIN LANE

FARRIS, HANSEN & ASSOCIATES, INC.
ENGINEERING — ARCHITECTURE — SURVEYING
7 BINGWAY COURT P.O. BOX 437

REVISION

1/7/2014-KB
ADJUST POOL
REMOVE ONE


4/29/2014-K
ADD WALLS B
ADJUST GRADE

5/1/2014-KB
ADJUST WALLS
GRADES

5/6/2014-KB
ADJUST POOL
& WALL HEIGH

9/30/2016-K
TO SHOW SIZE
OF AS-BUILT
PROPOSED DE

PROJECT NO.
889
DATE
10/9/2
SHEET NO.
1 OF

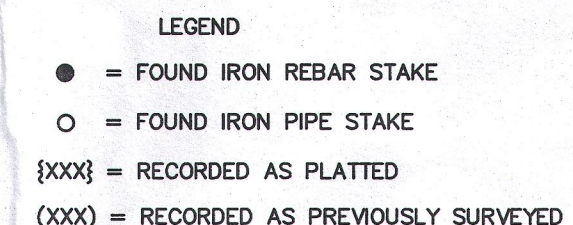

I HEREBY CERTIFY THAT THE ABOVE DESCRIBED PROPERTY HAS BEEN SURVEYED UNDER MY DIRECTION AND THAT THE ABOVE MAP IS A TRUE REPRESENTATION THEREOF AND SHOWS THE SIZE AND LOCATION OF THE PROPERTY AND ITS EXTERIOR BOUNDARIES. THIS SURVEY IS MADE FOR THE USE OF THE PRESENT OWNERS OF THE PROPERTY, AND ALSO THOSE WHO PURCHASE, MORTGAGE, OR GUARANTEE THE TITLE THERETO WITHIN ONE YEAR FROM THE DATE HEREOF.

REvised 10-03-2016

RECEIVED
NOV 01 2016
By *[Signature]*

