
PREPARED FOR MARGARET CANFIELD @ PROPERTIES LAKE GENEVA, WI.

## PLAT OF SURVEY

- OF -

PATHFINDER SURVEYING INC. ( formerly ) J.K. SURVEYING INC. P.O BOX 322 LAKE GENEVA, WI. 53147 WWW.PATHFINDERSURVEYING.NET 262-248-8303

LOTS 12 AND 13 OF ODDEN PARK SUBDIVISION, ACCORDING TO THE RECORD PLAT THEREOF, LOCATED IN SECTION 4, TOWNSHIP 1 NORTH, RANGE 17 EAST, TOWN OF LINN, COUNTY OF WALWORTH AND STATE OF WISCONSIN.

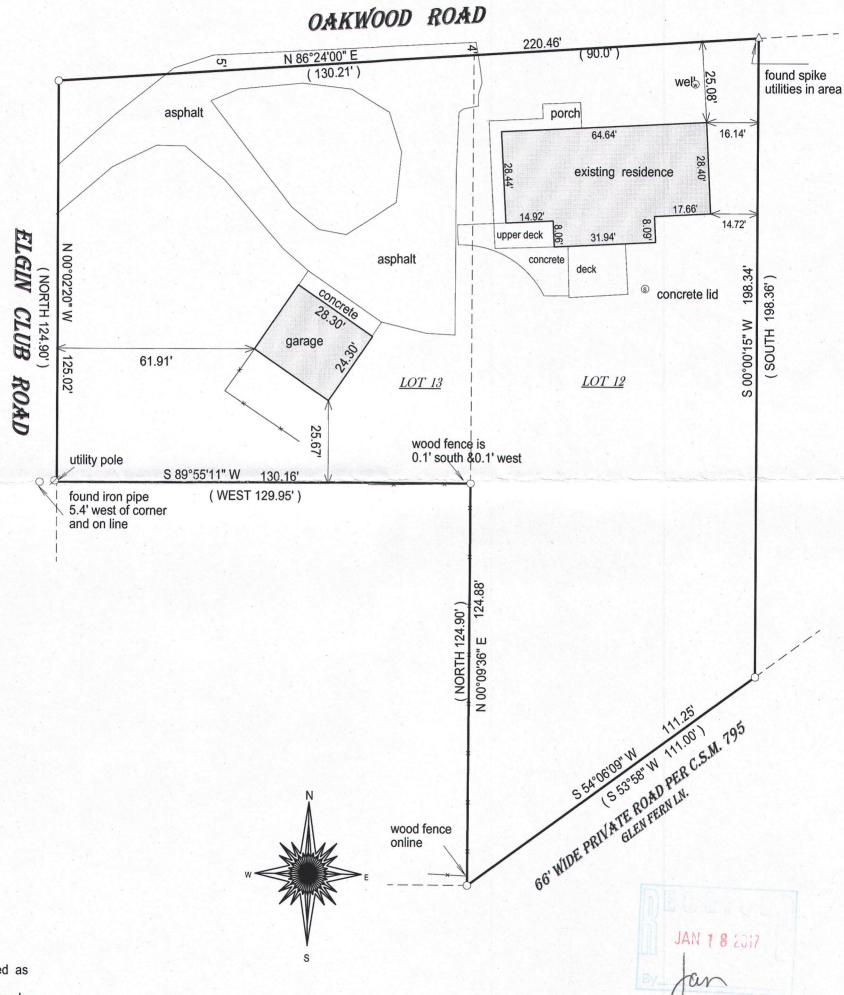

)= recorded as

= found iron bar

= found iron pipe

= set iron pipe

= set iron bar

SCALE 1" = 30'

JOB # 16-298

TAX ID # IOP 00012


BASIS OF BEARING OF THIS PLAT: THE SOUTH LINE OF OAKWOOD

I hereby certify that I have surveyed the above- described property and the above map is a is a true representation thereof and shows the size and location of the property, its exterior boundaries, the location and dimensions of all structures thereon, fences, apparant easements and roadways and visible encroachments if any.

WAS ASSUMED TO BEAR N 86°24' E AS MONUMENTED AND PLATTED.

This survey is made for the present owners of the property, and those who purchase, mortgage, or guarantee the title thereto, within one year from the date hereof.

DATED THIS 23rd day of September, 2016.

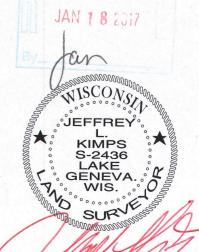

JEFEREY L KIMPS S-2436 Wisconsin Professional Land Surveyor

( original if signed in red )