


GEORGE T. DUNHAM  
SURVEYING & SUBDIVIDING  
DELAVAN, WISCONSIN

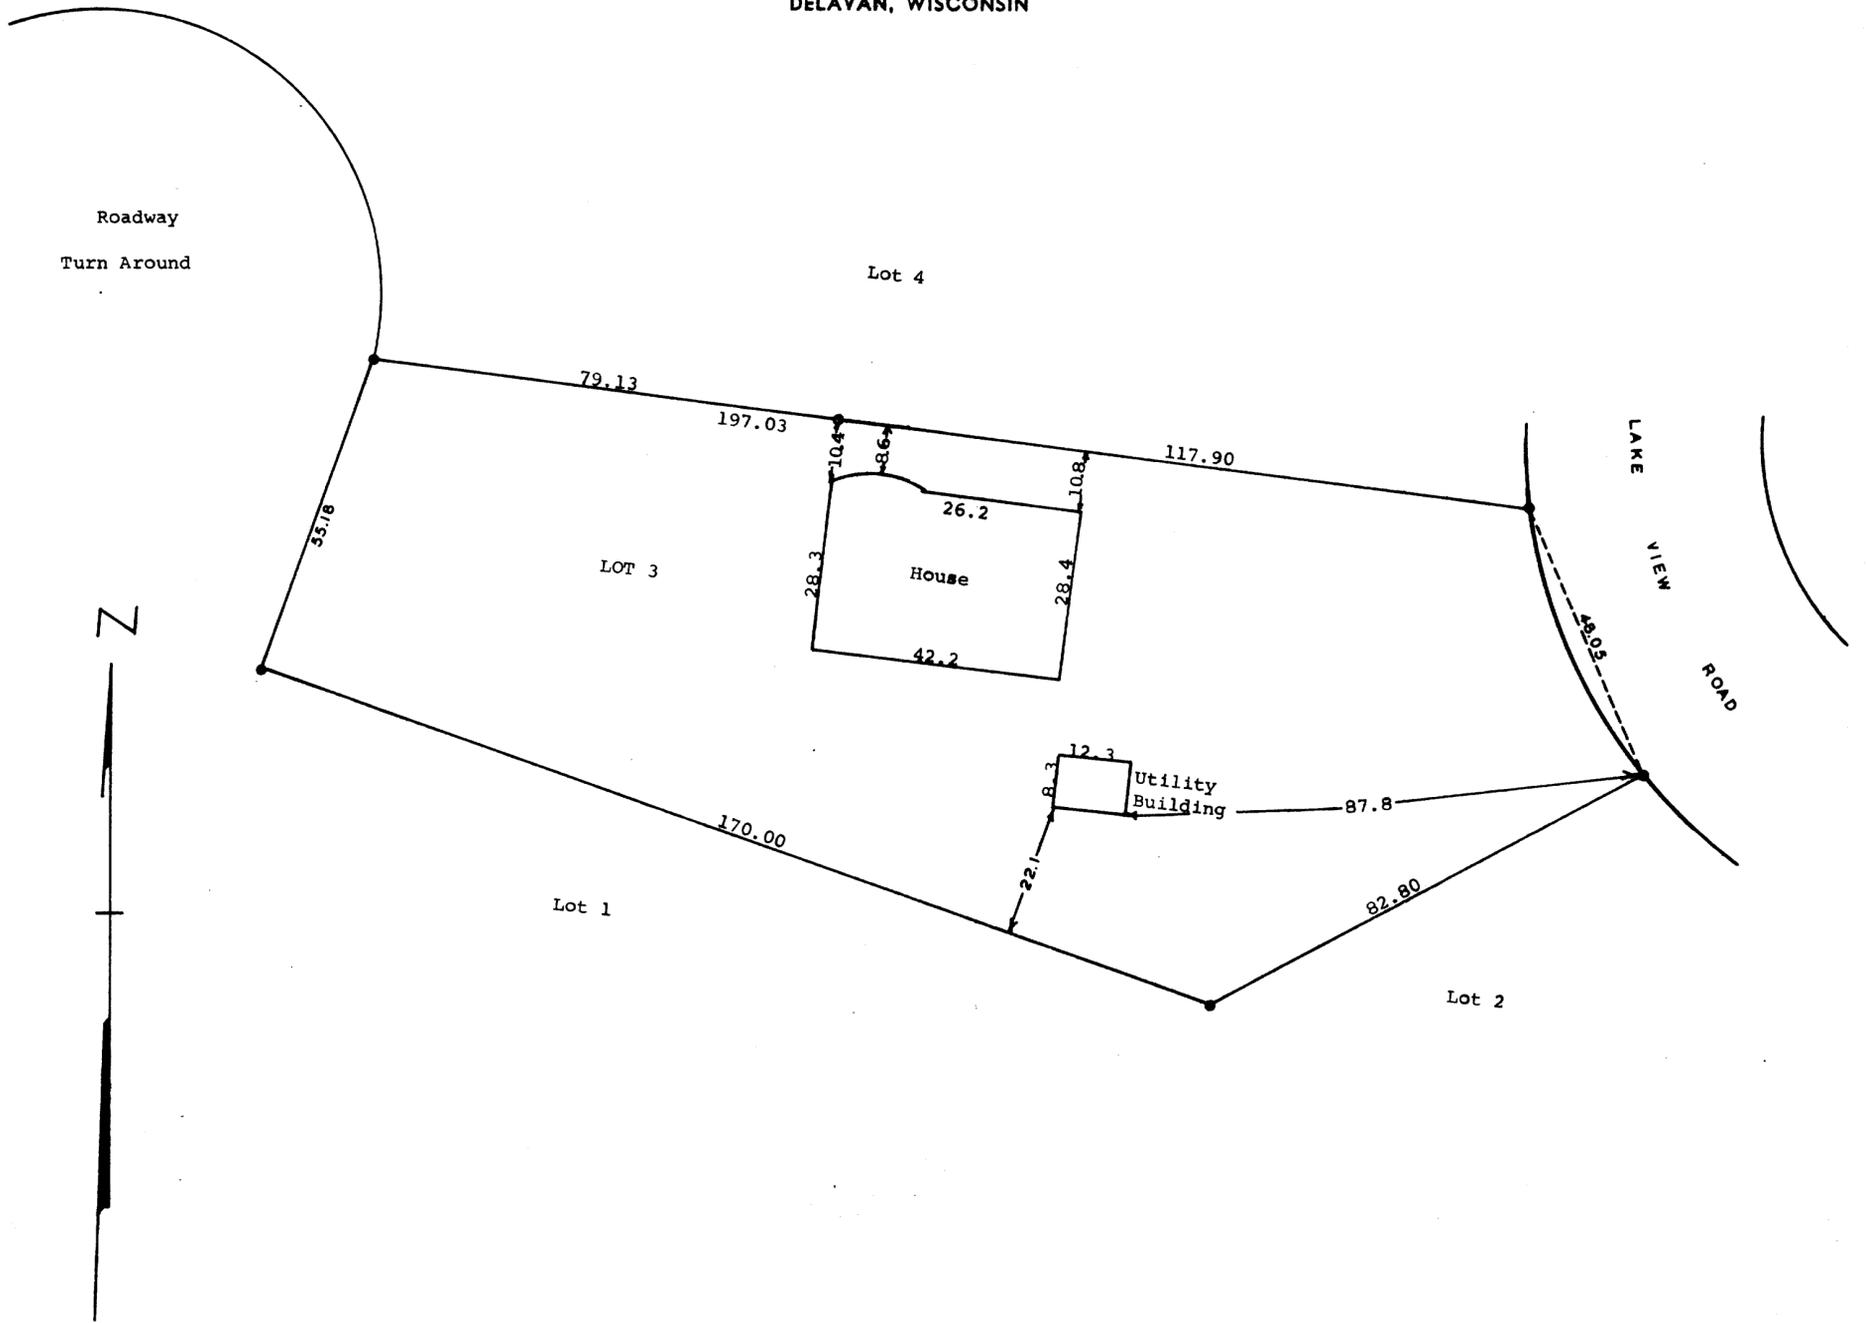

Scale - 1" = 20'  
 ○ = Iron Pipe  
 ● = Concrete Monument

STATE OF WISCONSIN)  
 COUNTY OF WALWORTH) SS  
 I, George T. Dunham, Surveyor, certify that I have surveyed  
 the property described as follows,  
 Lot 3 in Block 1, Wooddale Addition, located in Section 9,  
 T 1 N, R 17 E, Walworth County, Wisconsin,  
 and that the plat shown above is an accurate survey and a true representation  
 thereof and correctly shows the exterior boundary lines and location of  
 buildings on said property and the correct measurements thereof.  
 September 6, 1973

IW-3

*George T. Dunham*  
 George T. Dunham, Surveyor

