


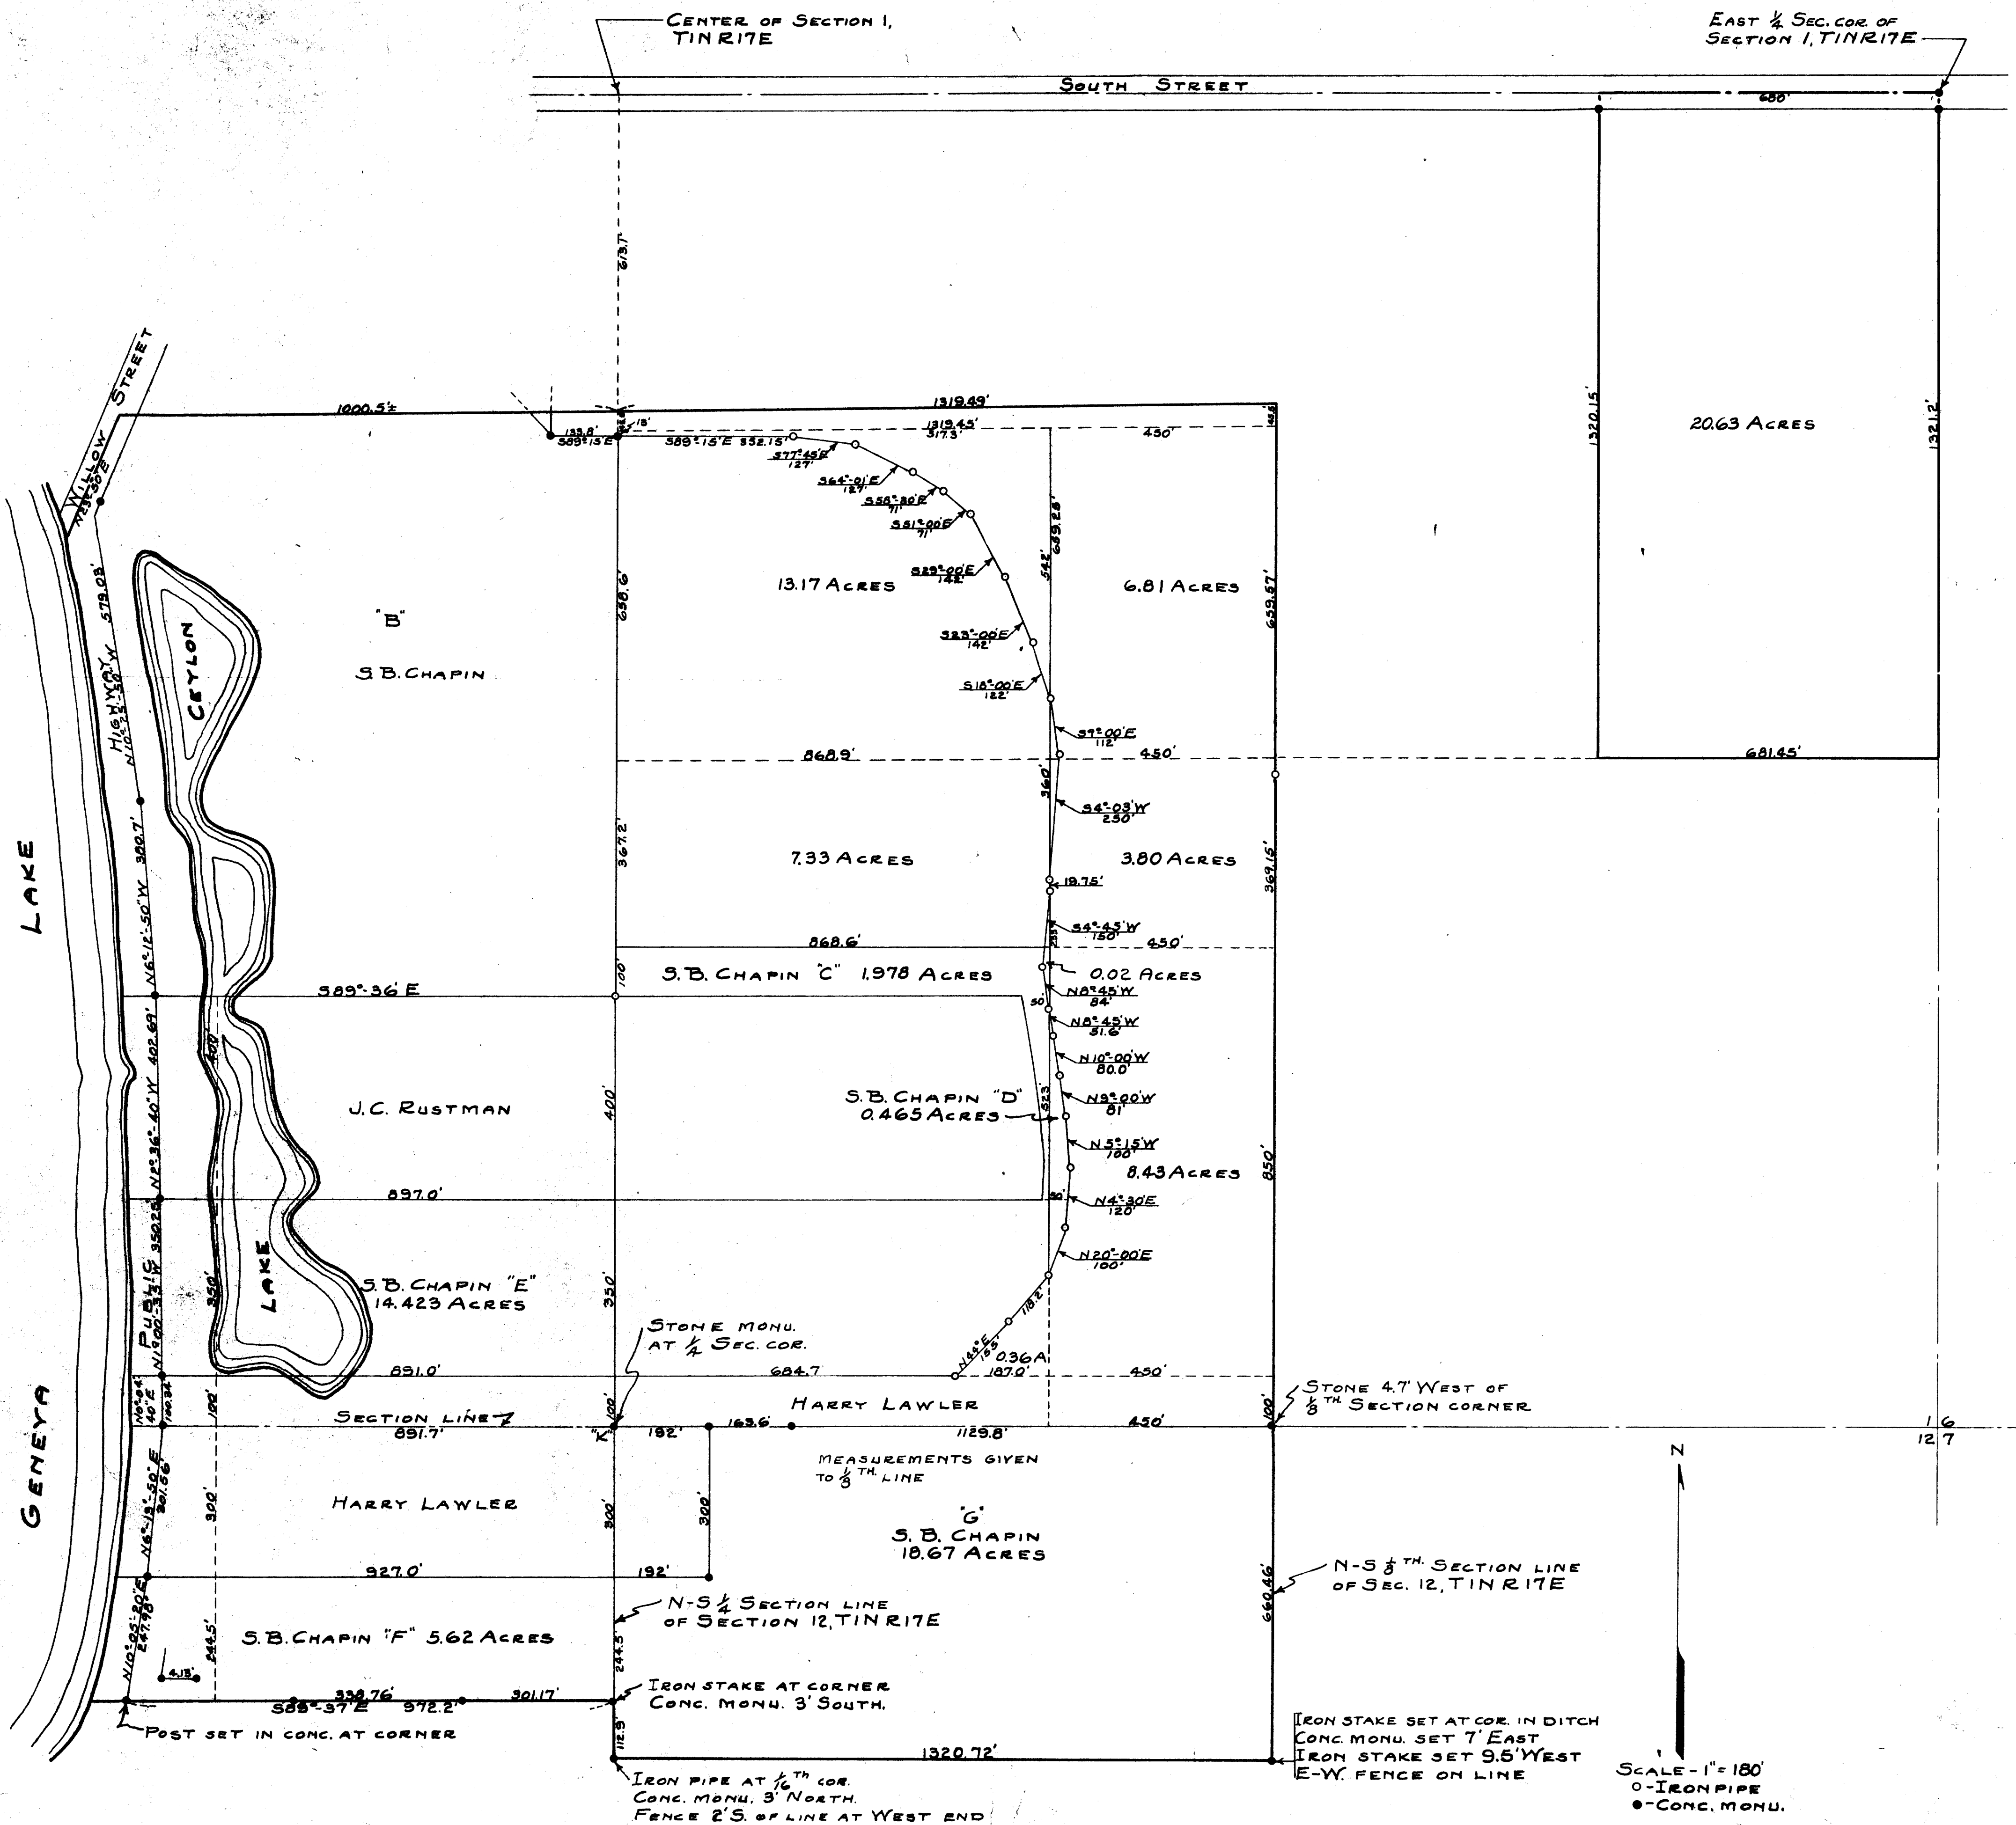

PLAT OF LAND LOCATED IN SECTIONS 1 AND 12 OF TIN RITE OF WALWORTH COUNTY, WISCONSIN.

Lloyd L. Jensen
COUNTY SURVEYOR

MAY 1946