


PLAY OF SURVEY & TOPOGRAPHIC MAPPING
LOT 1 OF CSM NO. 3741
LOCATED IN THE NE 1/4 AND SE 1/4
OF SECTION 9, T10N, R10E, S17E
TOWN OF LINN, WALWORTH COUNTY, WISCONSIN

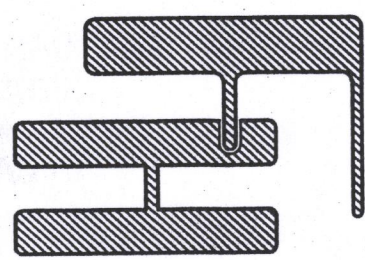


PLAT OF SURVEY & TOPOGRAPHIC MAPPING
N1895 BIRCHES DRIVE
LAKE GENEVA, WI 53147

— WORK ORDERED BY —
JOHNSON & SULLIVAN
11 E. HUBBARD STREET SUITE 702
CHICAGO, IL 60611

FARRIS, HANSEN & ASSOCIATES, INC.
ENGINEERING — ARCHITECTURE — SURVEYING
7 RIDGWAY COURT P.O. BOX 437
ELKHORN, WISCONSIN 53121
OFFICE: (262) 723-2098 FAX: (262) 723-5886

REVISIONS
DATE BY
TOPO SHEET 18

PROJECT NO.
6593.18
DATE
09/20/2004
SHEET NO.
1 OF 1

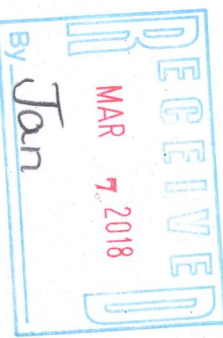


NOTE: COPIES OF THIS MAP TO WHICH THE FOLLOWING CERTIFICATE WILL APPLY SHALL BE CONSIDERED CORRECT AND VALID FOR ALL PURPOSES. ANY ALTERATIONS TO THIS MAP SHALL BE MADE BY THE SURVEYOR'S SIGNATURE IN RED INK. COPIES BY ANY OTHER MEANS MAY HAVE ALTERATIONS WHICH DO NOT REPRESENT THE SURVEYOR'S WORK PRODUCT.



I HEREBY CERTIFY THAT THE ABOVE DESCRIBED PROPERTY HAS BEEN SURVEYED UNDER MY DIRECTION AND THAT THE ABOVE MAP IS A TRUE REPRESENTATION THEREOF AND SHOWS THE SIZE AND LOCATION OF THE PROPERTY AND ITS EXTERIOR BOUNDARIES. THIS STATEMENT IS MADE IN THE PRESENCE OF THE FOLLOWING WITNESSES, WHO ARE PERSONS WHO ARE NOT PARTIES TO THIS SURVEY, AND I GUARANTEE THE TITLE THEREIN WITHIN ONE YEAR FROM THE DATE HEREOF.

DATED: 09/20/2004 02/01/2018 REVISION TO SHOW TOPOGRAPHIC MAPPING

BRAUN M. CARLSON, P.L.S. 2039

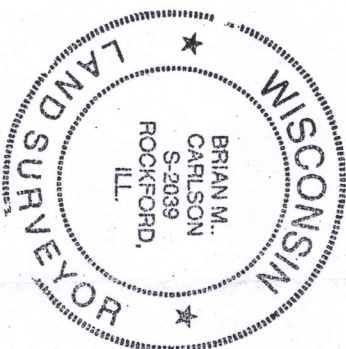

LEGEND
● = FOUND IRON REBAR STAKE
[xxx] = RECORDED AS

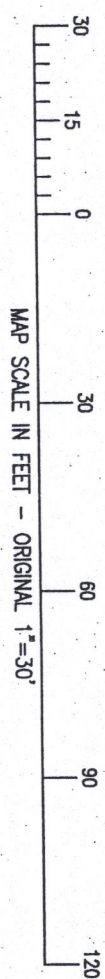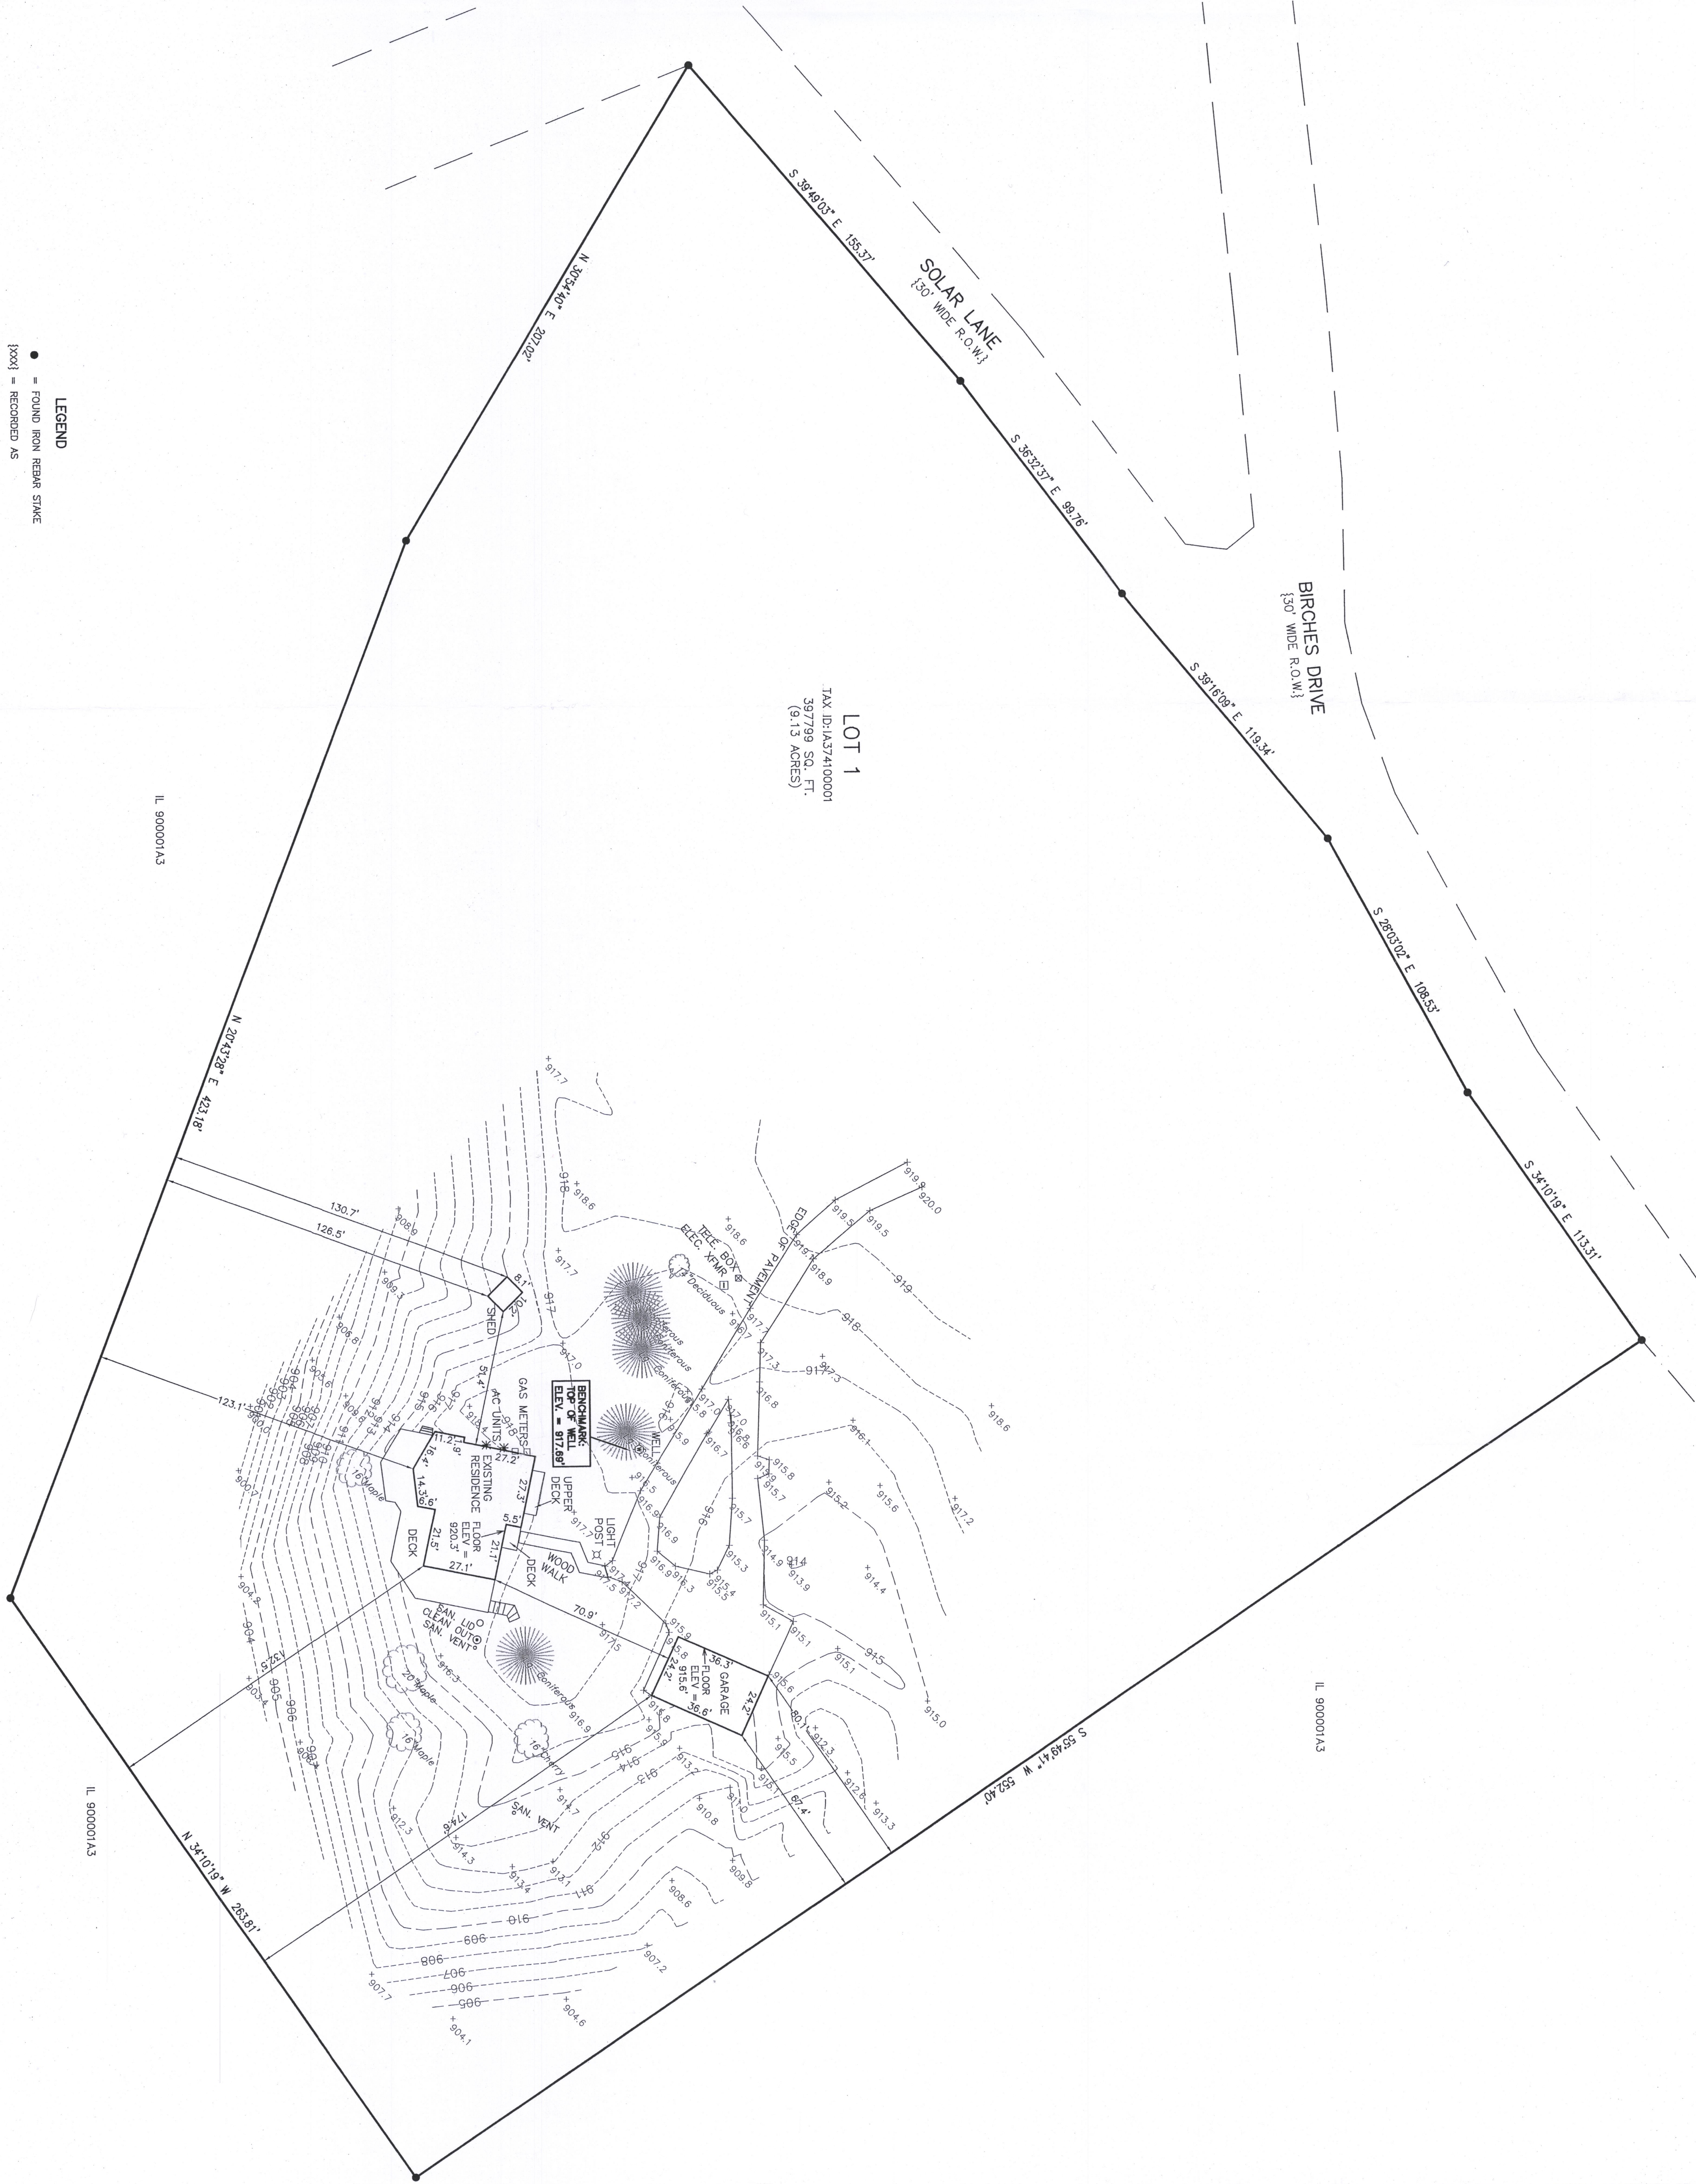

Feb 01 2018

X:\PROJECTS\6593\6593.18\ACAD\6593.18 TOPO SURVEY.DWG

IA3741-1 117-4105