


PLAT OF SURVEY

OF

LOT 24, LOT 26, AND THE NORTH $\frac{1}{2}$ OF LOT 28 OF
SHORE HAVEN, A SUBDIVISION LOCATED IN THE
NORTH EAST $\frac{1}{4}$ OF SECTION 18, T.1N. R.17E. WALKWORTH
COUNTY, WISCONSIN.

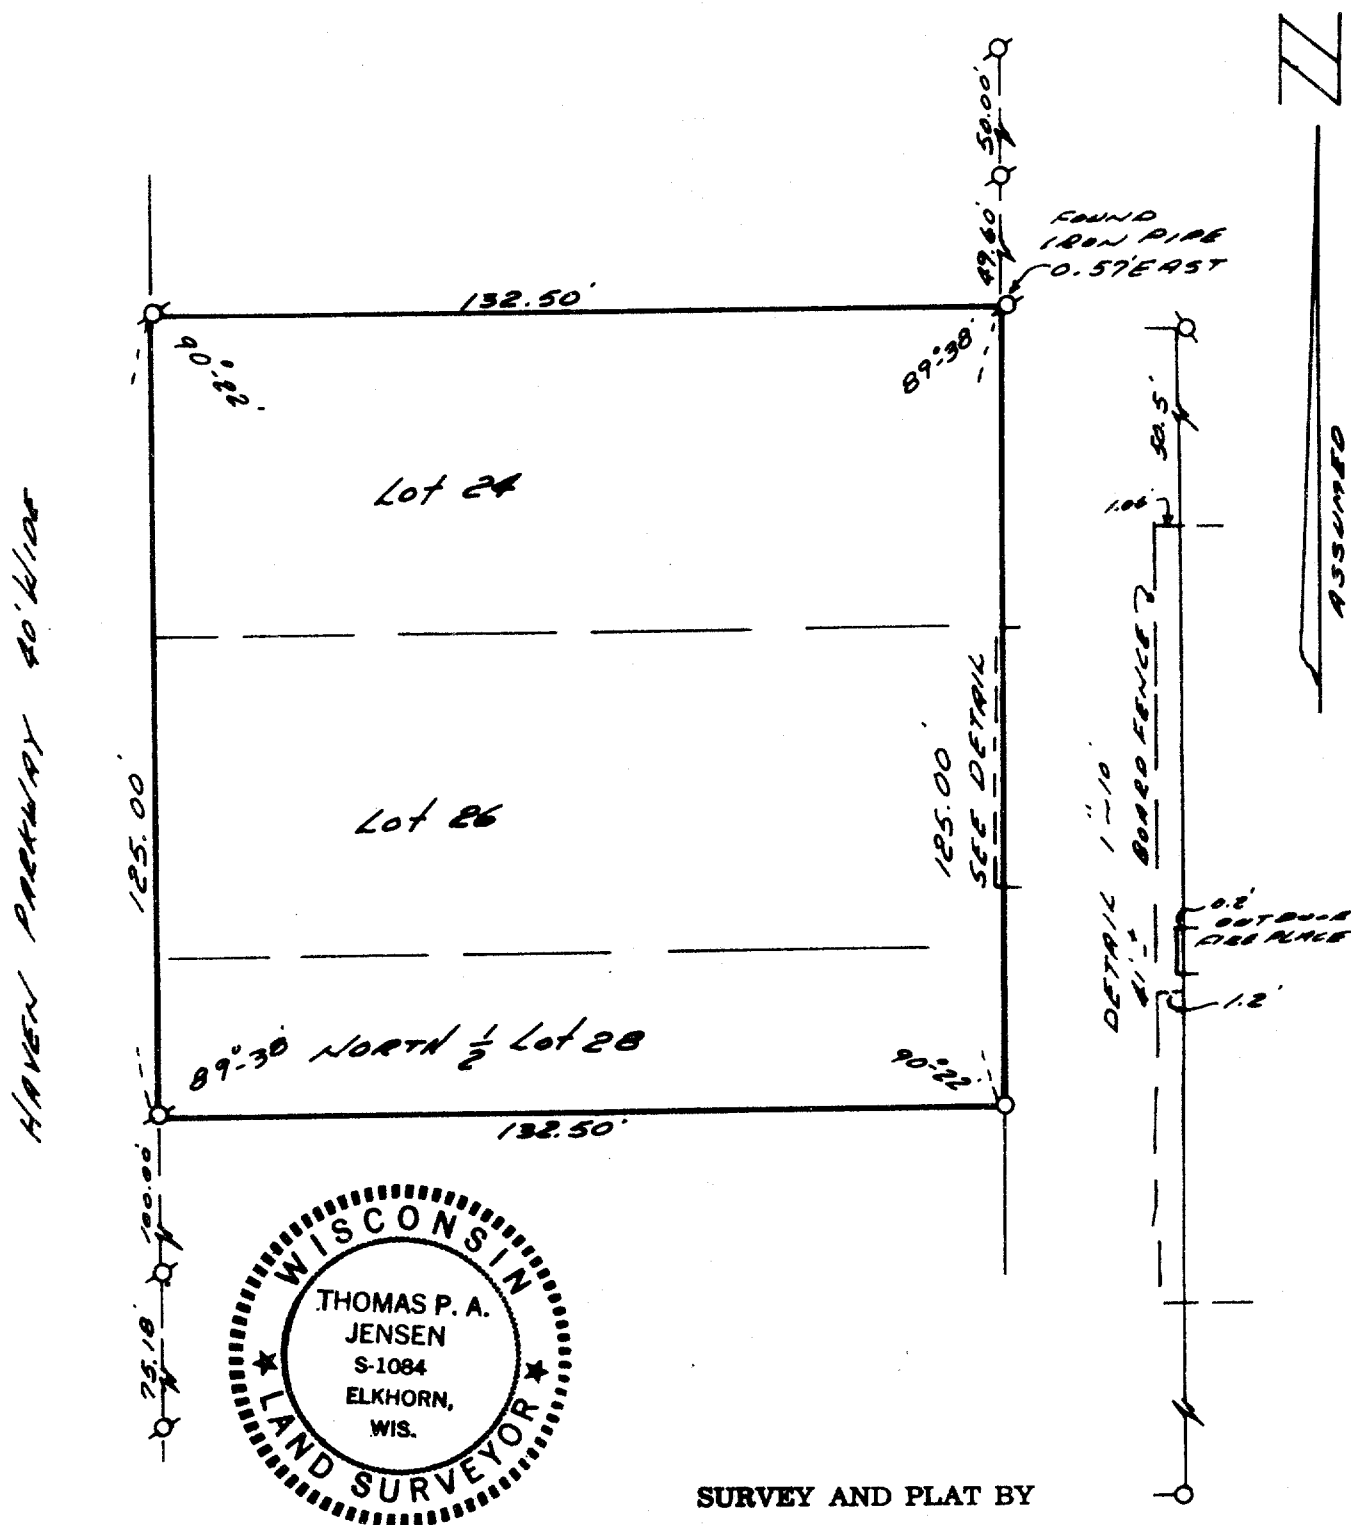

LEGEND

○ — Iron Pipe SET

● — Concrete Monument

Scale 1" = 30'

○ — IRON PIPE FOUND

WE CERTIFY: That we have surveyed the above described property and that the plat shown hereon is an accurate survey and a true representation thereof and correctly shows the exterior boundary lines and all divisions of said property.

Date JUNE 12, 1973

Thomas P. A. Jensen

Wisconsin Registered Land Surveyor, No. 1084