


PLAT OF SURVEY

-OF-

LOTS 7 AND 8 IN BLOCK I OF "CISCO BEACH", ACCORDING TO THE RECORDED PLAT THEREOF RECORDED OCTOBER 9, 1926 IN VOLUME 8 OF PLATS ON PAGE 103 AND BEING A SUBDIVISION LOCATED IN PART OF THE WEST 1/2 OF THE NORTHEAST 1/4 OF SECTION 5 AND LOT 1 IN BLOCK 1 OF ROWENA PARK SUBDIVISION, ALL IN TOWNSHIP 1 NORTH, RANGE 17 EAST OF THE FOURTH PRINCIPAL MERIDIAN, IN THE TOWN OF LINN, COUNTY OF WALWORTH AND STATE OF WISCONSIN.



SURVEY FOR: JOHN LAW OF RE/MAX PLAZA
SURVEY ADDRESS: N2436 SHOREVIEW DRIVE, LAKE GENEVA, WI 53147

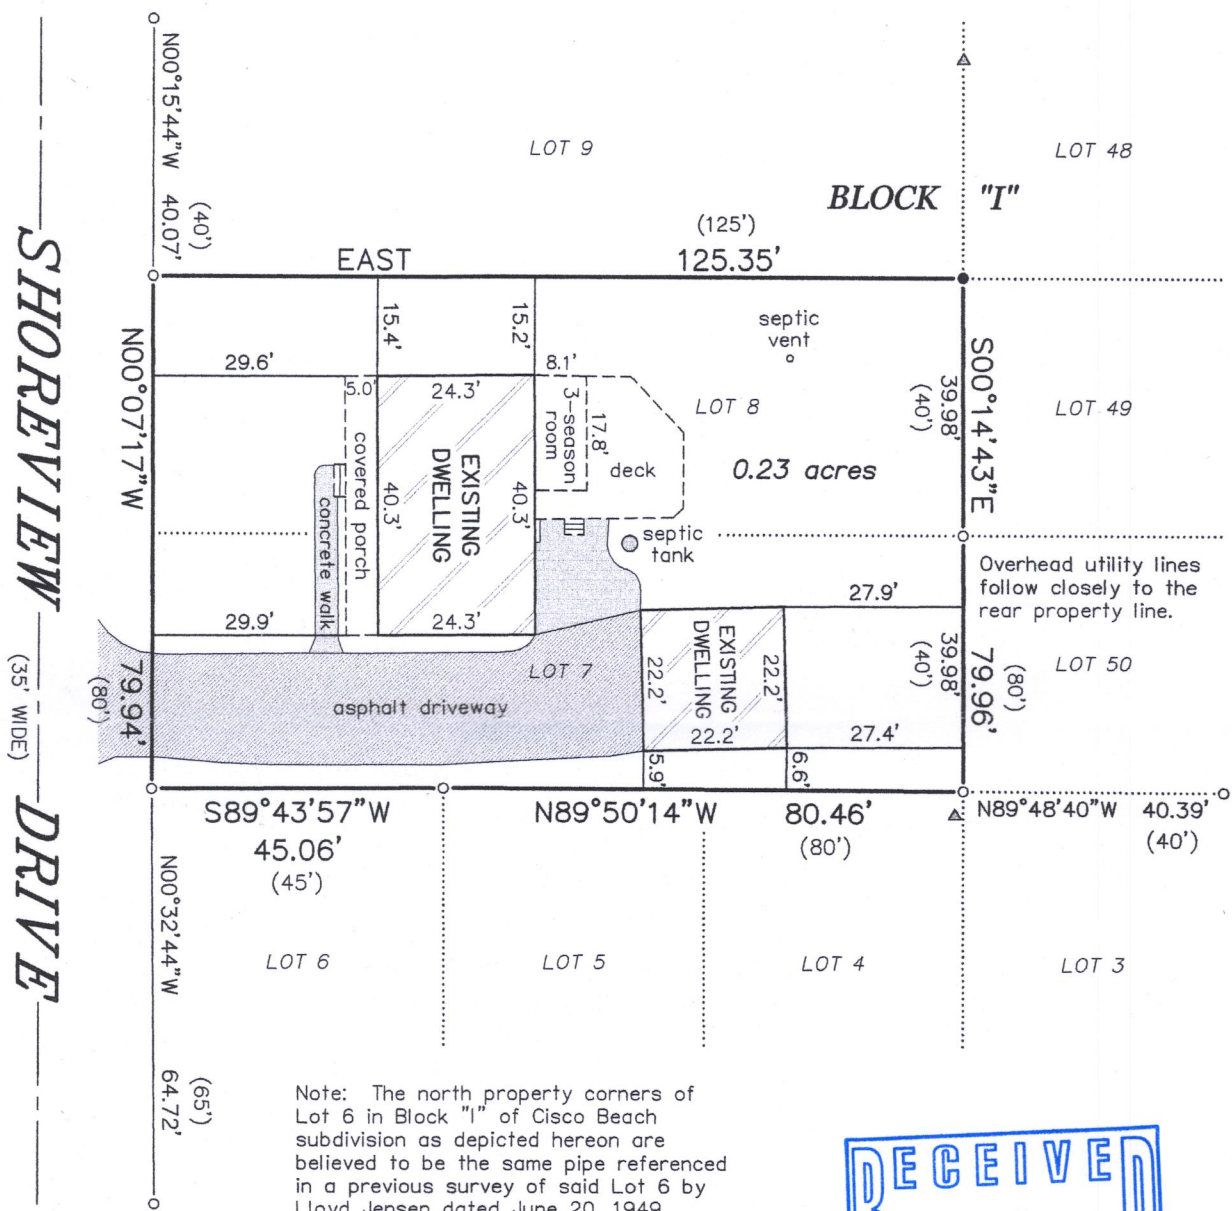

LEGEND

- FOUND IRON PIPE
- FOUND IRON ROD
- () RECORDED AS
- ▲ UTILITY POLE


BEARINGS HEREON RELATE TO THE NORTH LINE OF LOT 8 IN BLOCK "I" OF CISCO BEACH SUBDIVISION. ASSUMED BEARING OF EAST.

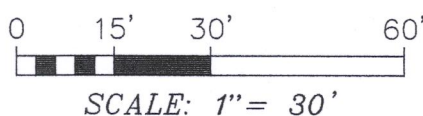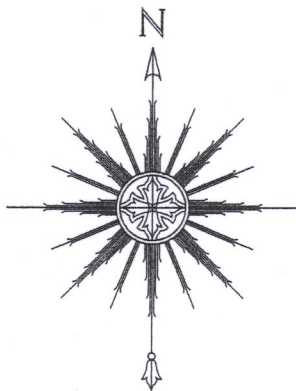

"I HEREBY CERTIFY THAT I HAVE SURVEYED THE ABOVE DESCRIBED PROPERTY AND THAT THE ABOVE MAP IS A CORRECT REPRESENTATION THEREOF AND SHOWS THE SIZE AND LOCATION OF THE PROPERTY, ITS EXTERIOR BOUNDARIES, THE LOCATION OF ALL VISIBLE STRUCTURES AND DIMENSIONS OF ALL PRINCIPAL BUILDINGS THEREON, BOUNDARY FENCES, APPARENT EASEMENTS, ROADWAYS AND ENCROACHMENTS, IF ANY."

"THIS SURVEY IS MADE FOR THE USE OF THE PRESENT OWNERS OF THE PROPERTY, AND THOSE WHO PURCHASE, MORTGAGE, OR GUARANTEE THE TITLE THERETO WITHIN ONE YEAR FROM DATE HEREOF."

SATTER SURVEYING, LLC
LAND SURVEYS, MAPPING AND PLANNING
272 ORIGIN STREET
BURLINGTON, WI 53105
262-661-4239

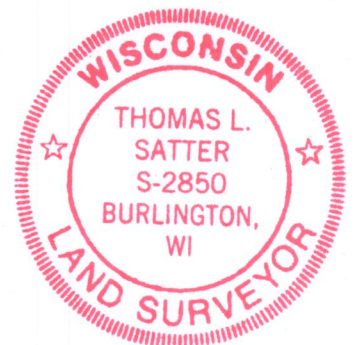

THIS IS NOT AN ORIGINAL PRINT
UNLESS THIS SEAL IS RED.

Thomas L. Satter
THOMAS L. SATTER S-2850

JUNE 14, 2019
DATE

061901
JOB NUMBER

ICI-194

117-4264