


PLAT OF SURVEY & TOPOGRAPHIC MAPPING LOTS 55 & 58 OF LAKE GENEVA BEACH, A SUBDIVISION

LOCATED IN PART OF THE SW 1/4 OF THE SW 1/4
OF SECTION 11, TOWN 1 NORTH, RANGE 17 EAST,
TOWN OF LINN, WALWORTH COUNTY, WISCONSIN

ASSIGNED W. LINE OF LANDS SURVEYED
N 00°00'00" W

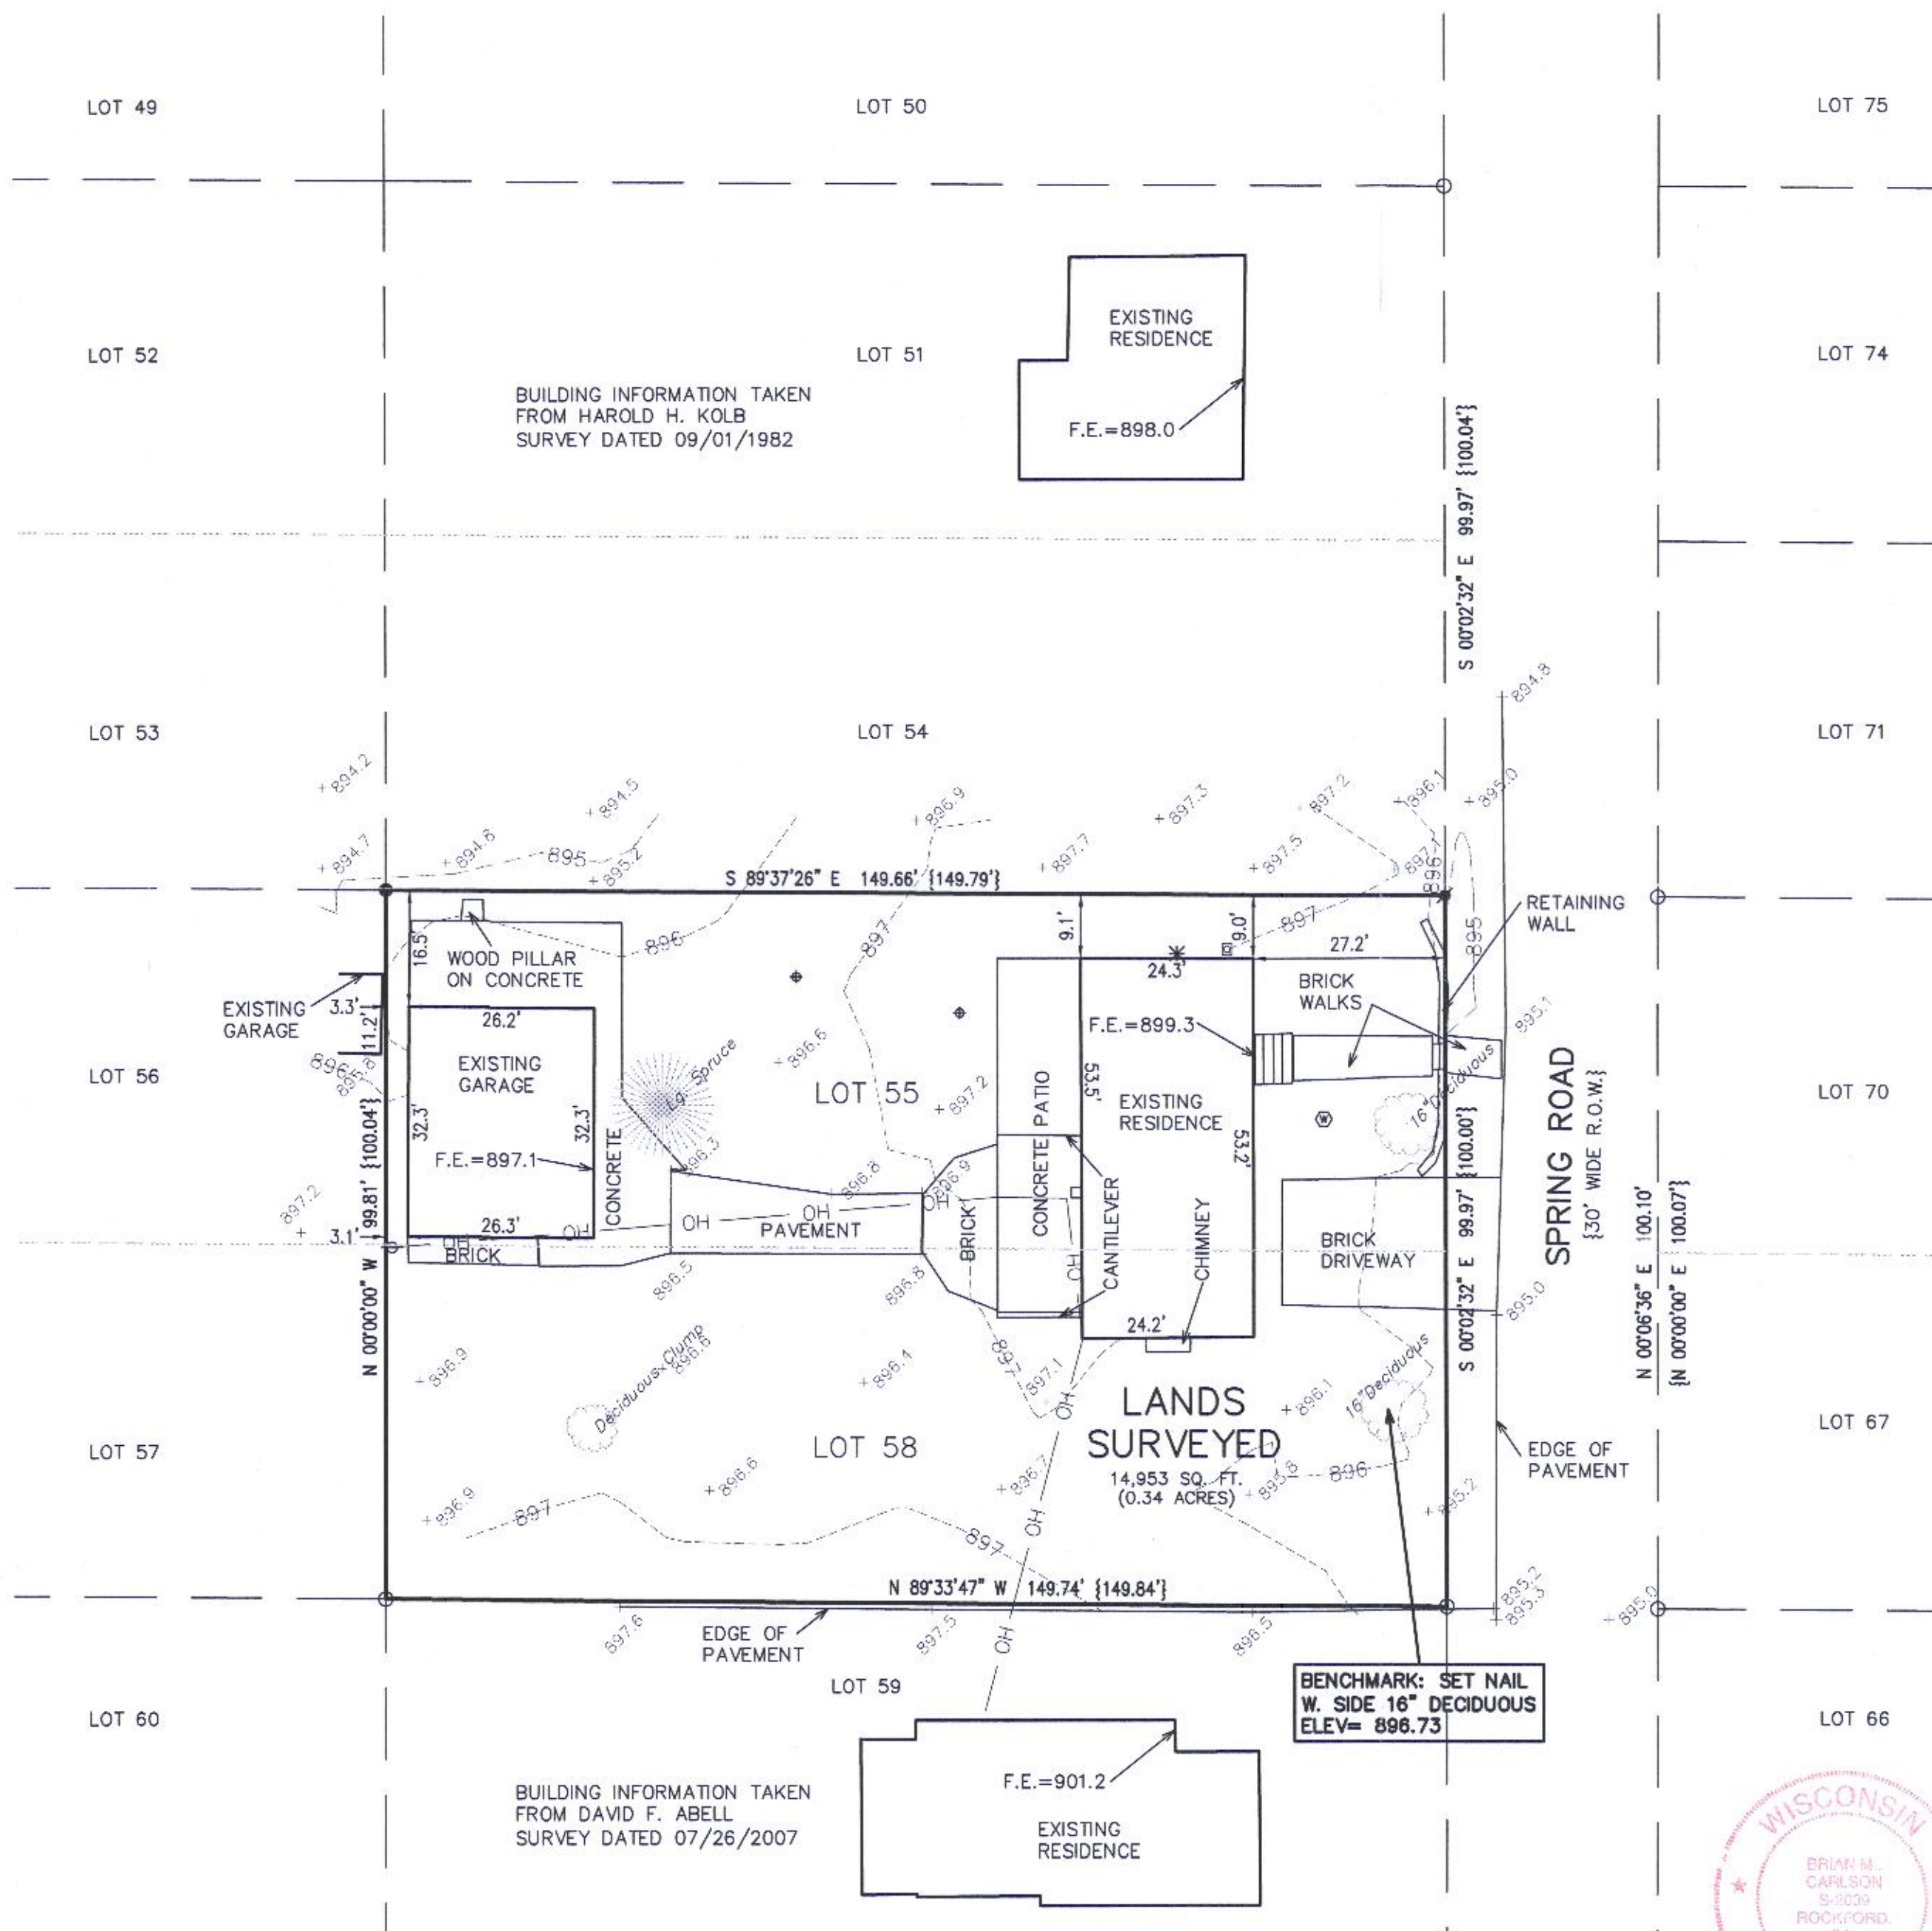

LEGEND

- = FOUND IRON PIPE STAKE
- = FOUND REBAR STAKE
- ✱ = SET REBAR STAKE
- ⊠ = GAS METER
- ✱ = AIR CONDITIONING UNIT
- ⊙ = WELL
- ⊕ = SANITARY LID
- = ELECTRIC METER
- ⊕ = UTILITY POLE
- OH — = OVERHEAD WIRE
- {XXX} = RECORDED AS
- F.E. = FLOOR ELEVATION
- +XXXX = EXISTING GROUND ELEVATION
- XXXX- = EXISTING LAND CONTOURS



NOTE: COPIES OF THIS MAP TO WHICH THE FOLLOWING CERTIFICATE WILL APPLY SHOW THE SURVEYOR'S ORIGINAL SEAL AND SIGNATURE IN RED INK. COPIES BY ANY OTHER MEANS MAY HAVE ALTERATIONS WHICH DO NOT REPRESENT THE SURVEYOR'S WORK PRODUCT.

I HEREBY CERTIFY THAT THE ABOVE DESCRIBED PROPERTY HAS BEEN SURVEYED UNDER MY DIRECTION AND THAT THE ABOVE MAP IS A TRUE REPRESENTATION THEREOF AND SHOWS THE SIZE AND LOCATION OF THE PROPERTY AND ITS EXTERIOR BOUNDARIES. THIS SURVEY IS MADE FOR THE USE OF THE PRESENT OWNERS OF THE PROPERTY, AND ALSO THOSE WHO PURCHASE, MORTGAGE, OR GUARANTEE THE TITLE THERETO WITHIN ONE YEAR FROM THE DATE HEREOF.

DATED: 02/25/2020

Brian M. Carlson
BRIAN M. CARLSON P.L.S. 2039



TOPOGRAPHIC SURVEY
N1735 SPRING ROAD
LAKE GENEVA, WI 53147

— WORK ORDERED BY —
GENEVA HOMES
P.O. BOX 7
LAKE GENEVA, WI 53147

FARRIS, HANSEN & ASSOCIATES, INC.
ENGINEERING — ARCHITECTURE — SURVEYING
7 RIDGWAY COURT P.O. BOX 437
ELKHORN, WISCONSIN 53121
OFFICE: (262) 723-2098 FAX: (262) 723-5886

REVISIONS
02/25/2020 LB
100% SURVEY

PROJECT NO.
10230
DATE:
02/25/2020
SHEET NO.
1 OF 1

X:\PROJECTS\10230\ACAD\10230.DWG

MAP SCALE IN FEET — ORIGINAL 1"=20'

ILGB-49

117-4362