


GEORGE T. DUNHAM
SURVEYOR & ENGINEERING
DELAVER, WISCONSIN

N


Scale -- 1" = 40'
= Iron Pipe Found
• = Iron Pipe Placed
o = Iron Pin Found and Replaced by an Iron Pipe
(60.00) = Distances Shown on the Recorded Plat if Different than those found in the Field.

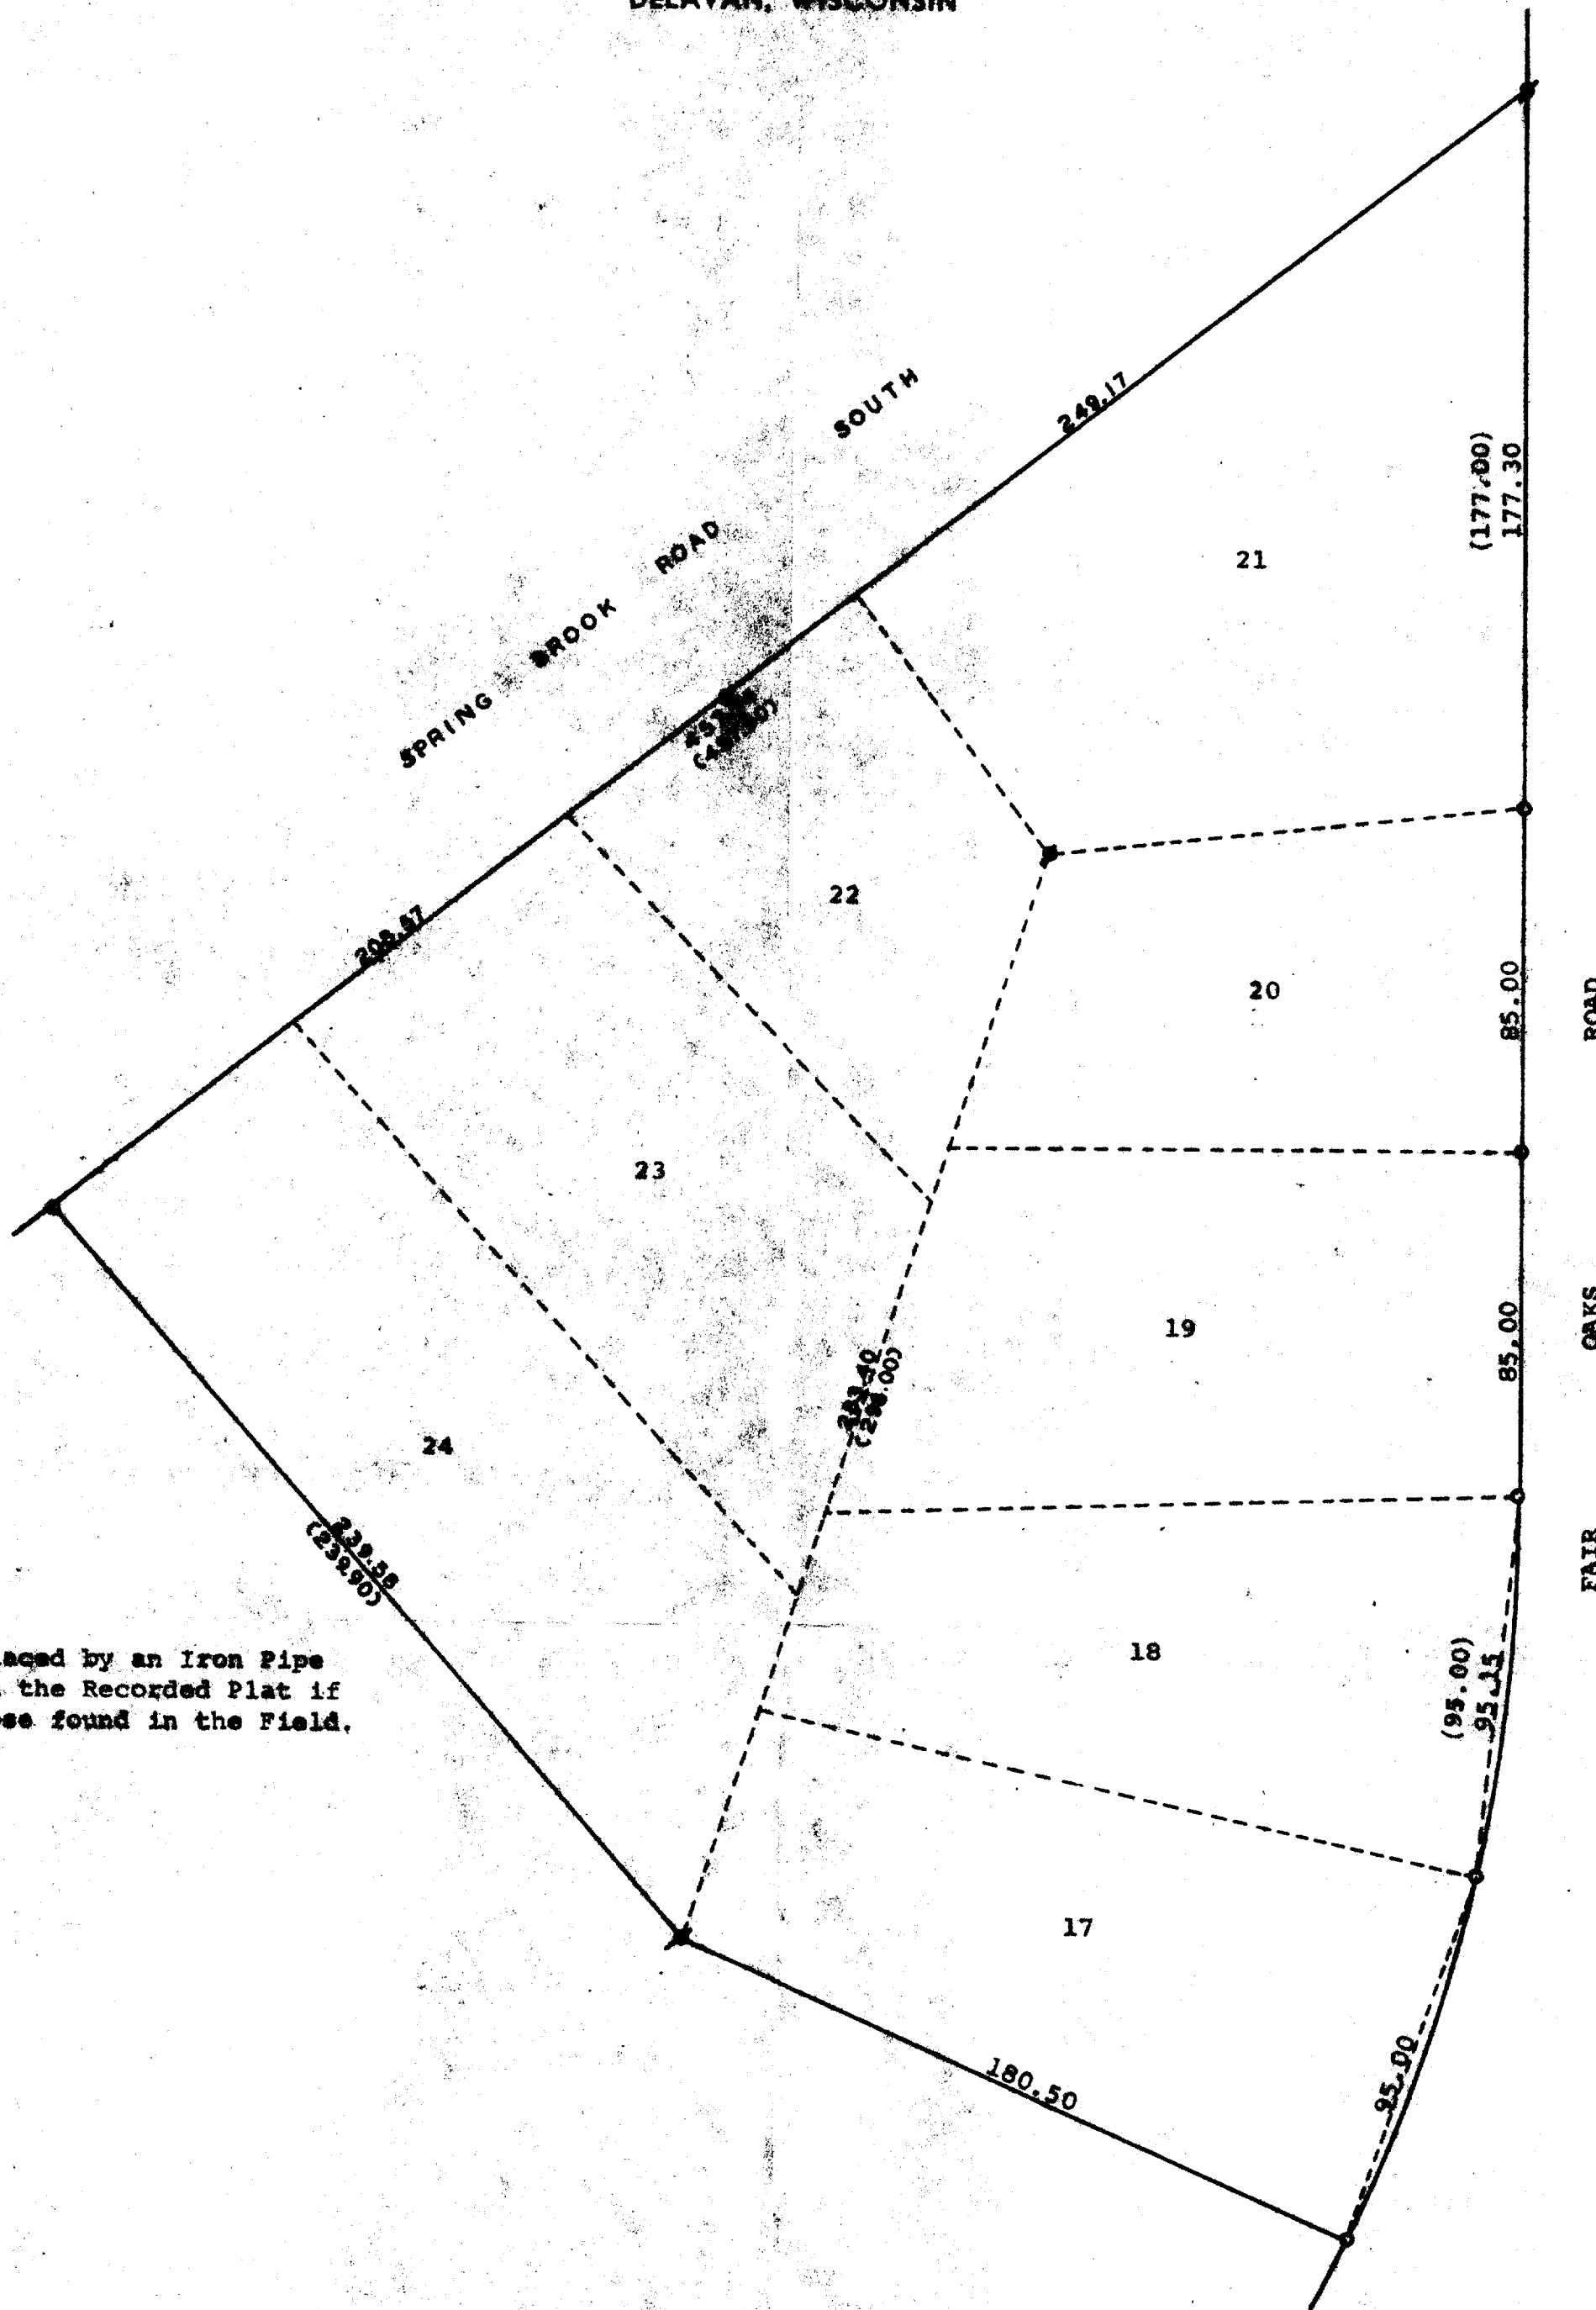

STATE OF WISCONSIN)
COUNTY OF WALWORTH)

I, George T. Dunham, Surveyor, certify that I have surveyed the property described as follows:
Lots 17-24 inclusive in Block 15 of Wooddale Addition located in Sections 9 & 16, T 1 N, R 17 E, Walworth County, Wisconsin, and that the above map is a true representation thereof and shows the size and location of the property, its exterior boundaries, and there are no buildings, fences, apparent encroachments or visible encroachments on said property, other than underground utility cables on the rear lines of the lots.
May, 1974

George T. Dunham, Surveyor

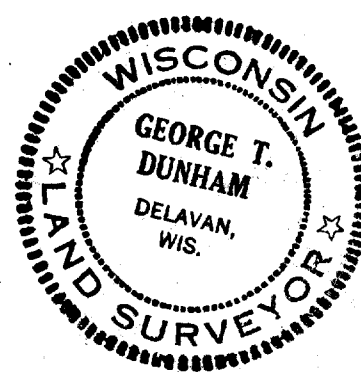

IW-77DI

117-438