


North 1/4 Corner
Section 5-1-17
N. 216,037.16
E. 2,400,862.38

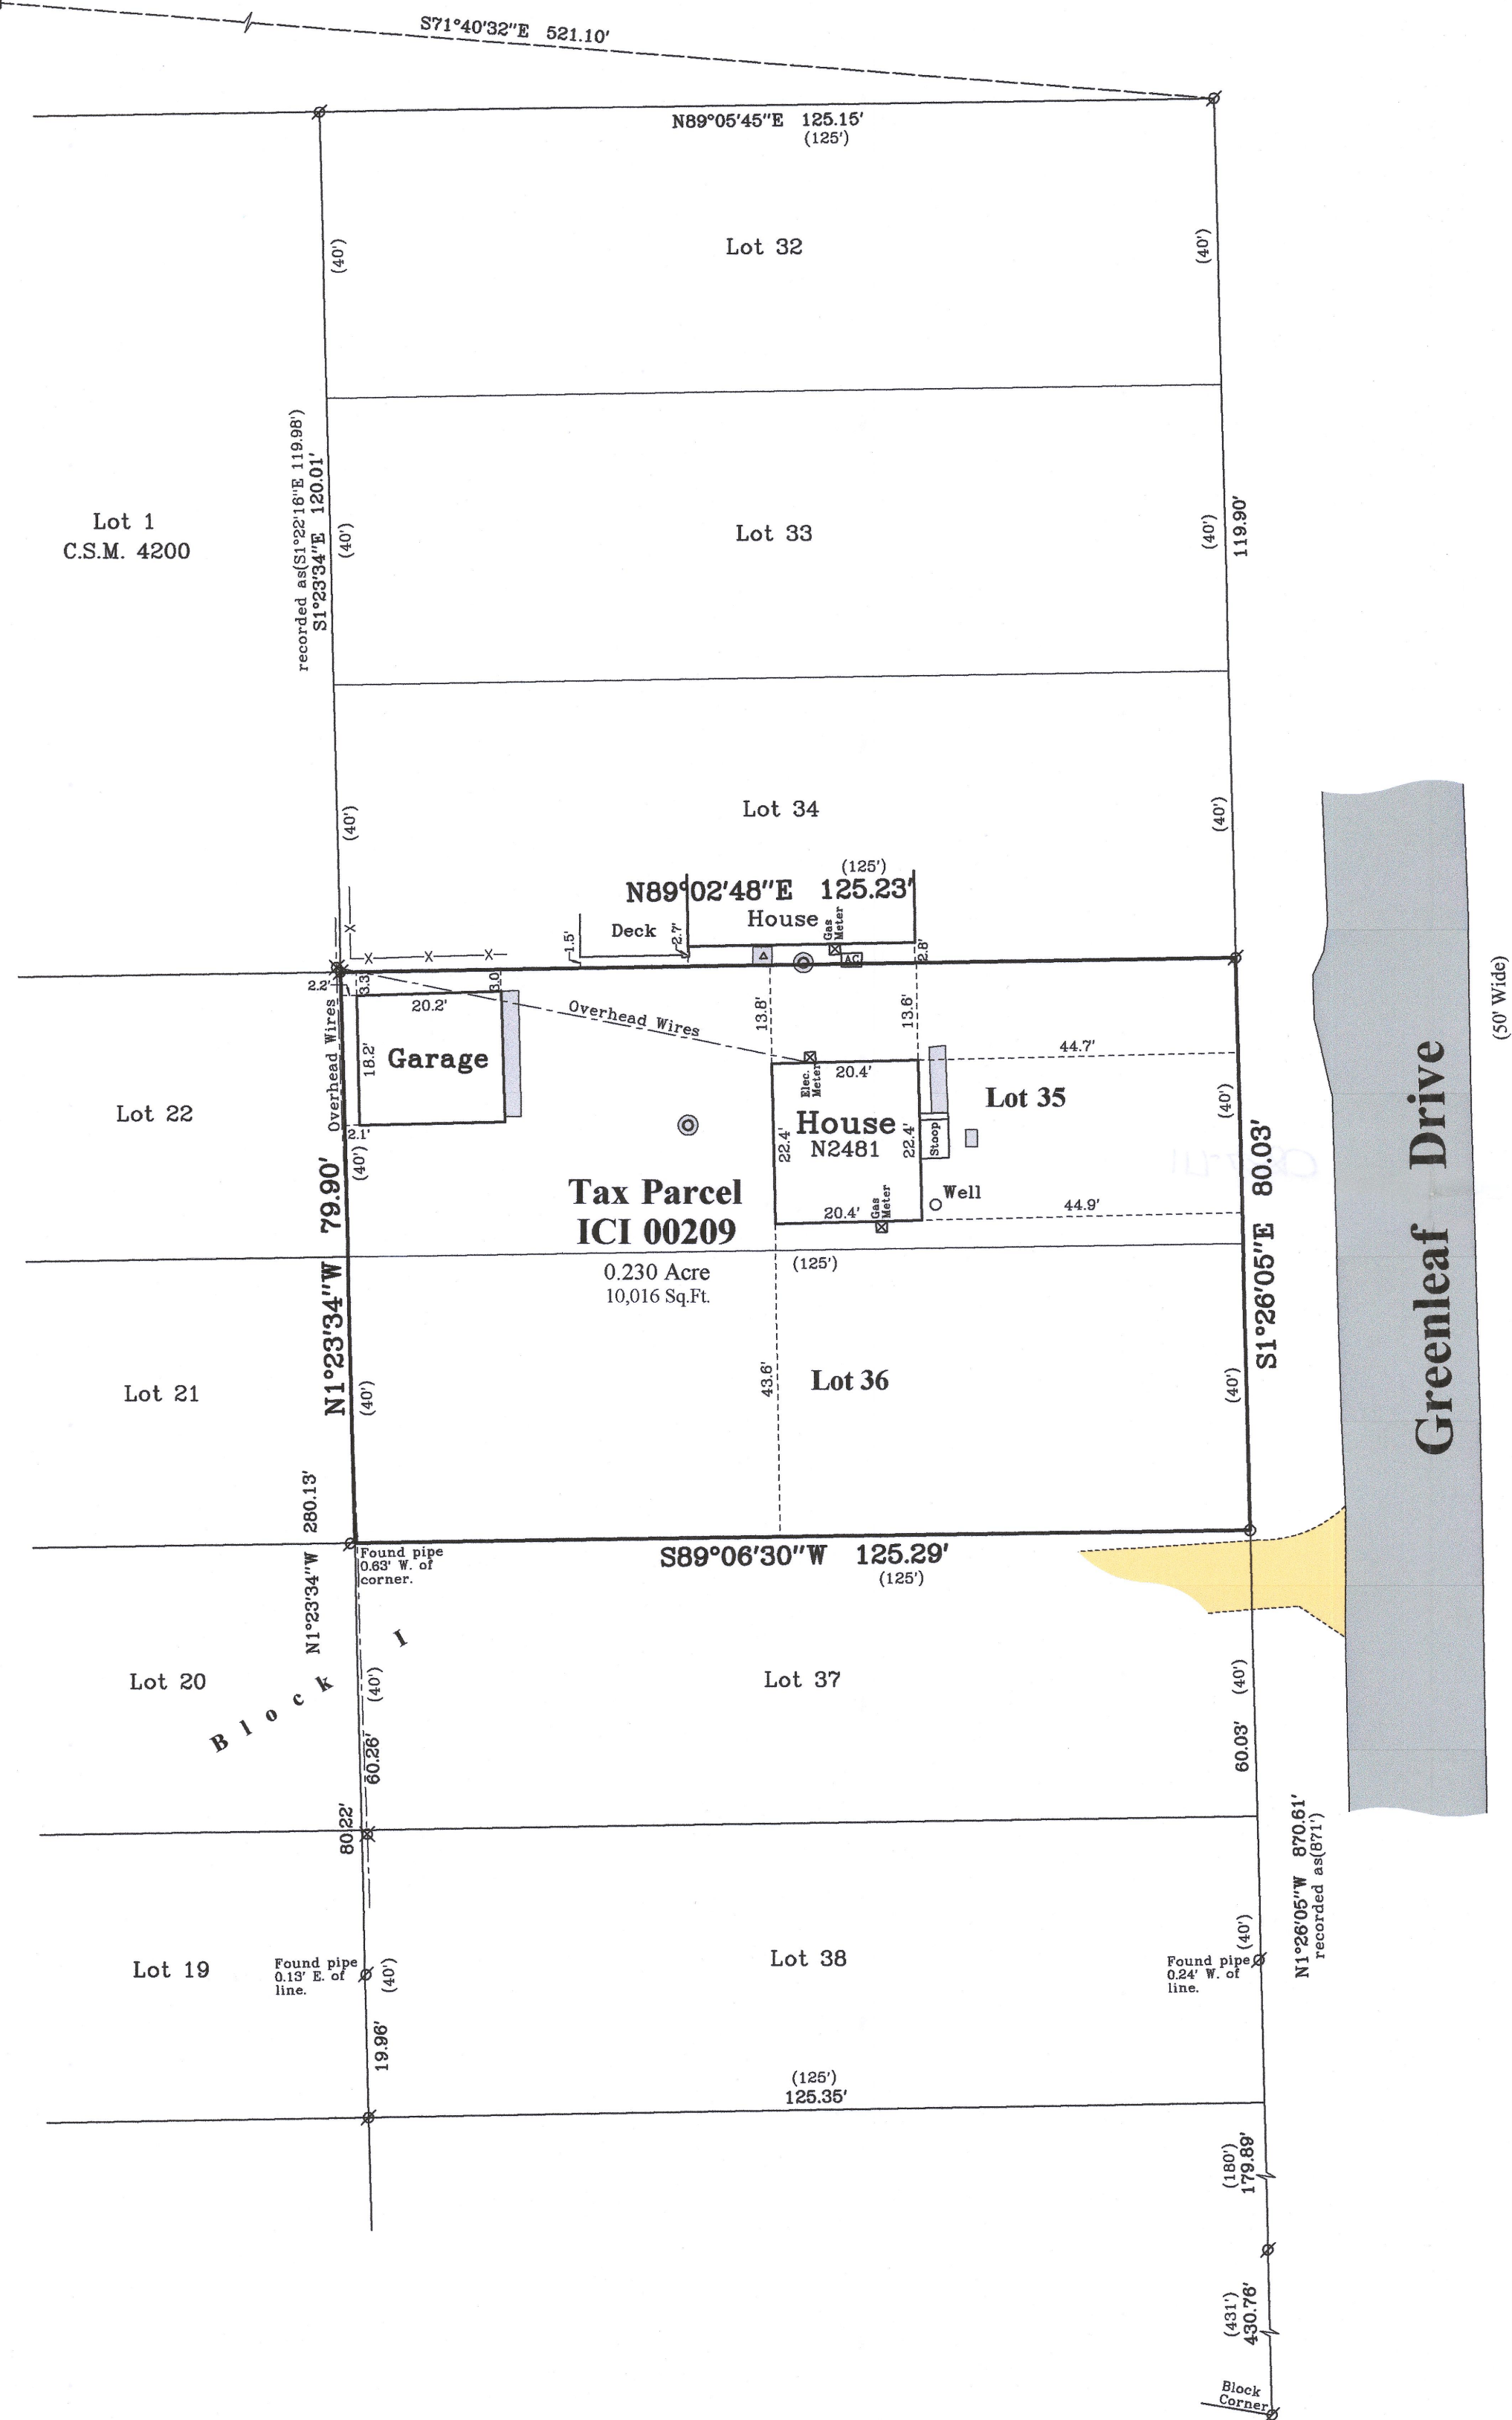


Plat of Survey

of

Lots 35 & 36 in Block I of Cisco Beach,


a subdivision located in the Northwest 1/4 of the Northeast 1/4 of Section 5, Town 1 North, Range 17 East, Town of Linn, Walworth County, Wisconsin.

Surveyed for: **Holly Adams**
16740 Queen Ann Drive
Brookfield, Wisconsin. 53005

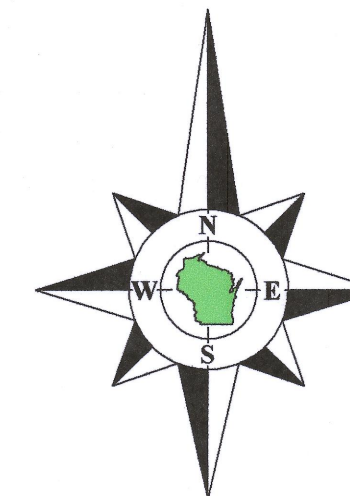


Bearings referenced to the North line of the Northeast 1/4 of Section 5-1-17, recorded as N89°06'30"E in the Wisconsin State Plane Coordinate System, South Zone, (NAD-27).

Coordinates are referenced to the Wisconsin State Plane Coordinate System, South Zone, (NAD-27).

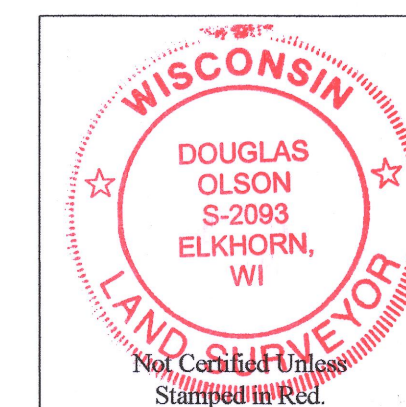

Notes:

- 1) This Plat of Survey is not certified unless signed and sealed in red ink.
- 2) This survey is subject to Wisconsin lien laws. This Plat of Survey is the notice of intent to file lien. Lien waiver required.
- 3) The Survey Date shown on this Plat of Survey is the completion date of the field work.

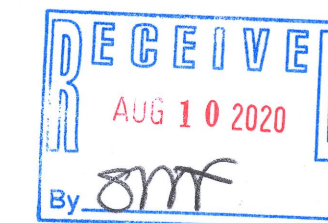

Copyright ©2020 by Olson Land Surveying, LLC.

All rights reserved. No part of this survey plat may be reproduced or transmitted in any form by any means - graphic, electronic, or mechanical, including photocopying, tracing, or information storage and retrieval systems - without permission in writing from Douglas G. Olson, Olson Land Surveying, LLC.


I hereby certify that I have surveyed the above described property in compliance with Chapter A-E 7 of the Wisconsin Administrative Code and that the map hereon is correct to the best of my professional knowledge and belief and shows the size and location of the property, its exterior boundaries, the location and dimensions of all visible structures thereon, boundary fences, apparent easements and roadways and visible encroachments, if any.

This survey is made for the exclusive use of the present owners of the property, and also those who purchase, mortgage or guarantee title thereto, within one year from the date hereof.

Douglas G. Olson
Wisconsin Professional Land Surveyor - 2093

Survey Date: June 12, 2020.
Revisions:

Scale in Feet
1" = 20'



A horizontal scale bar with alternating black and white segments. The segments are labeled from left to right: 0', 10', 20', 40', and 60'.

445 South Wisconsin Street | P.O. Box 322
Elkhorn, Wisconsin. 53121
Telephone: (262) 723-3434
Facsimile: (262) 723-8044
Email: doug@olsonsurveying.com
Website: www.olsonsurveying.com

OLSON
LAND SURVEYING, LLC
Rural | Residential | Commercial

Legend of Symbols & Abbreviations		N	North
	Found County Section Corner	S	South
	Set Iron Pipe	W	West
	Recorded Information	in	In Bearings
	Utility Pole	°	Degrees
	Utility Pedestal	"	Minutes
	Metal Cover	"	Seconds
	Asphalt Surface	in	Inches
	Concrete Surface	ft	Feet
	Gravel Surface		
	TV Antenna		

Sheet 1 of 1 Sheets

Drawing Name:

Job Reference Number
2020.045

2020.045