




**Vanderstappen**  
Land Surveying, Inc.  
www.vandersinc.com  
1316 N. Madison St.  
Woodstock, Illinois 60098  
ph. 815-337-8310 fax 815-337-8314  
"Always faithful to the property line"

# PLAT OF SURVEY

Lots 7 through 10, Block 1, Kuebker's Addition to the Village of Zenda, Walworth County, Wisconsin.


**PLEASANT STREET**  
(PLATTED AS ZENDA STREET)

**ZENDA ROAD**

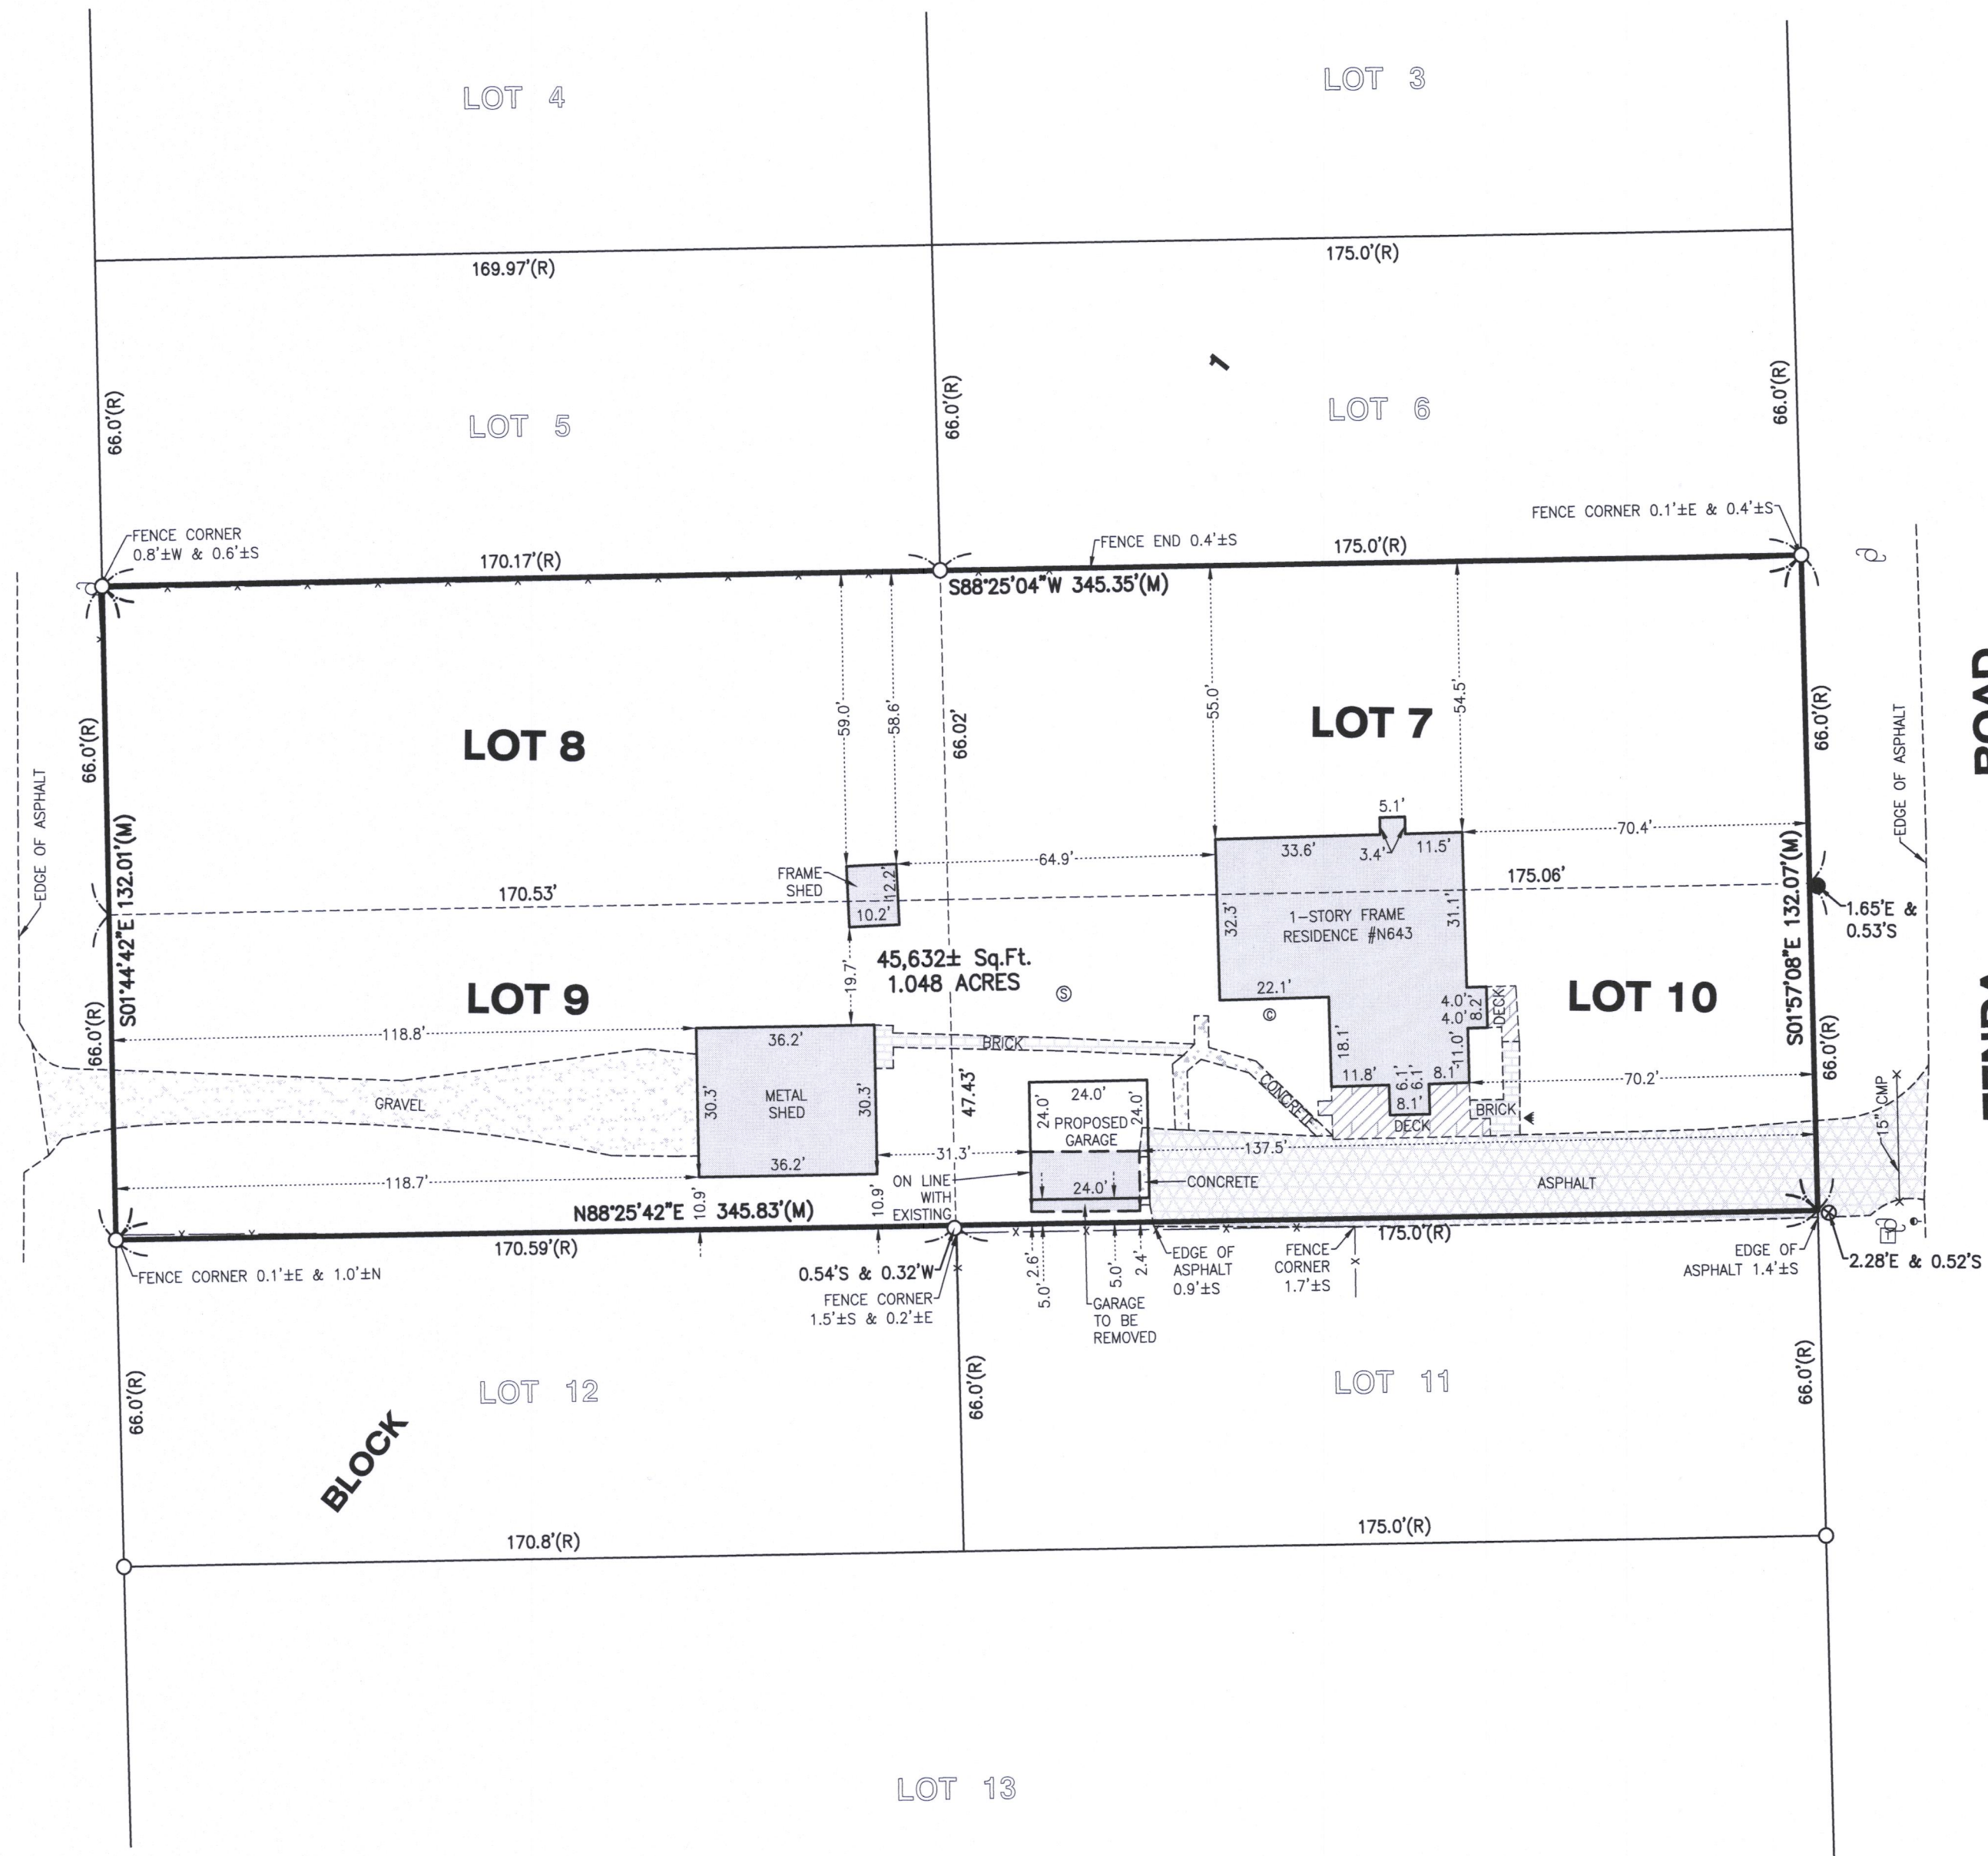

## LEGEND

|     |                 |
|-----|-----------------|
| ⊙   | CLEAN OUT       |
| •   | DOWN GUY        |
| ●   | FOUND IRON BAR  |
| ○   | FOUND IRON PIPE |
| ⊗   | FOUND MAG NAIL  |
| Ⓢ   | SEPTIC LID      |
| Ⓣ   | TELEPHONE RISER |
| Ⓤ   | UTILITY POLE    |
| Ⓨ   | YARD LIGHT      |
| (R) | RECORD          |
| (M) | MEASURED        |

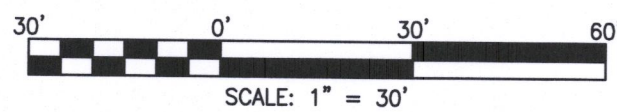

**NOTE:** Only those Building Line Restrictions or Easements shown on a Recorded Subdivision Plat are shown hereon unless the description ordered to be surveyed contains a proper description of the required building lines or easements.

- \* No distance should be assumed by scaling.
- \* No underground improvements have been located unless shown and noted.
- \* No representation as to ownership, use, or possession should be hereon implied.
- \* This Survey and Plat of Survey are void without original embossed or colored seal and signature affixed.

Compare your description and site markings with this plat and AT ONCE report any discrepancies which you may find.


STATE OF ILLINOIS )  
COUNTY OF McHENRY ) S.S.

In my professional opinion, and based on my observations, I hereby certify that we have surveyed the premises above described, and that the plat hereon is a true representation of the said survey. This professional service conforms to the current Illinois minimum standards for a boundary survey.

Dated at Woodstock, McHenry County, Illinois 09/03 A.D., 20 20.

Vanderstappen Land Surveying Inc.  
Design Firm No. 184-002792

By: \_\_\_\_\_  
Illinois Professional Land Surveyor No. S1777

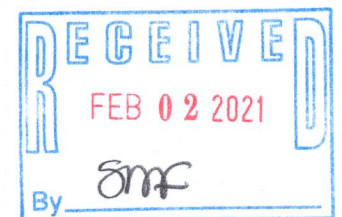

CLIENT: FRANK HAYDEN  
DRAWN BY: GMJ CHECKED BY: WJV  
SCALE: 1"=30' SEC. 28 T. 01 R. 17 E.  
BASIS OF BEARING: ASSUMED  
P.I.N.: IZK 00001B  
JOB NO.: 200664 I.D. LSS  
FIELDWORK COMP.: 09/02/20 BK. PG.  
ALL DISTANCES SHOWN IN FEET AND DECIMAL PARTS THEREOF CORRECTED TO 68° F. REF: \_\_\_\_\_