


**REGISTERED PROFESSIONAL LAND SURVEYOR
LAKE GENEVA, WISCONSIN**

30.00

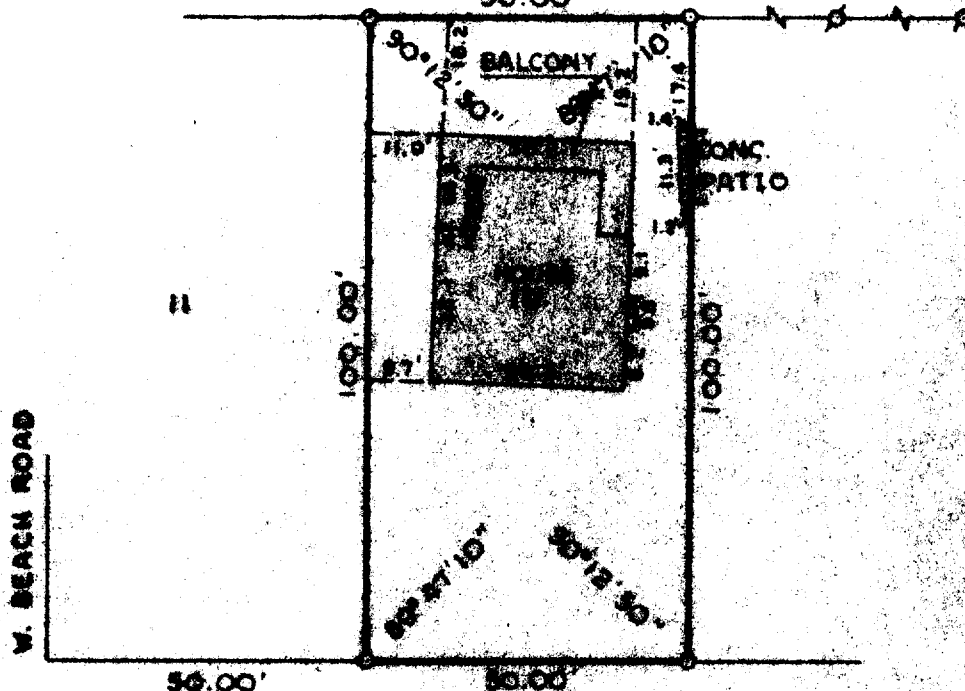

LAKEVIEW ROAD - 30' WIDE

N



SCALE: 1"=30'


PLAT OF SURVEY OF

Lot 10, Lake Geneva Highlands, a subdivision located in the Southeast $\frac{1}{4}$ of Section 8, T 1 N, R 17 E, Walworth County, Wisconsin.

OWNER: Ruth Morgan

ACCURACY: Distances $\pm 0.01'$
Angles $\pm 05''$
Error of closure
less than $1/3000$

- ♀ - IRON PIPE FOUND
 O - IRON PIPE PLACED
 ● - CONCRETE MONUMENT
 X - SPIKE

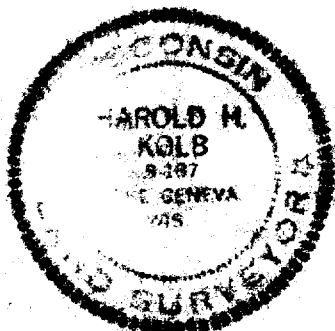

I, HAROLD H. KOLE, DO HEREBY CERTIFY THAT I HAVE SURVEYED THE PROPERTY HEREON DESCRIBED ACCORDING TO THE OFFICIAL RECORDS, AND THAT THE PLAT HEREON IS A CORRECT REPRESENTATION OF THE LOT LINES.

Harold H. Kolt
HAROLD H. KOLT
WISCONSIN REGISTERED LAND SURVEYOR, S-187
DATE August 19, 1974

FLG H-10

BRUNING 40-108 1N/6-71

117-447