


GENEVA LAKE

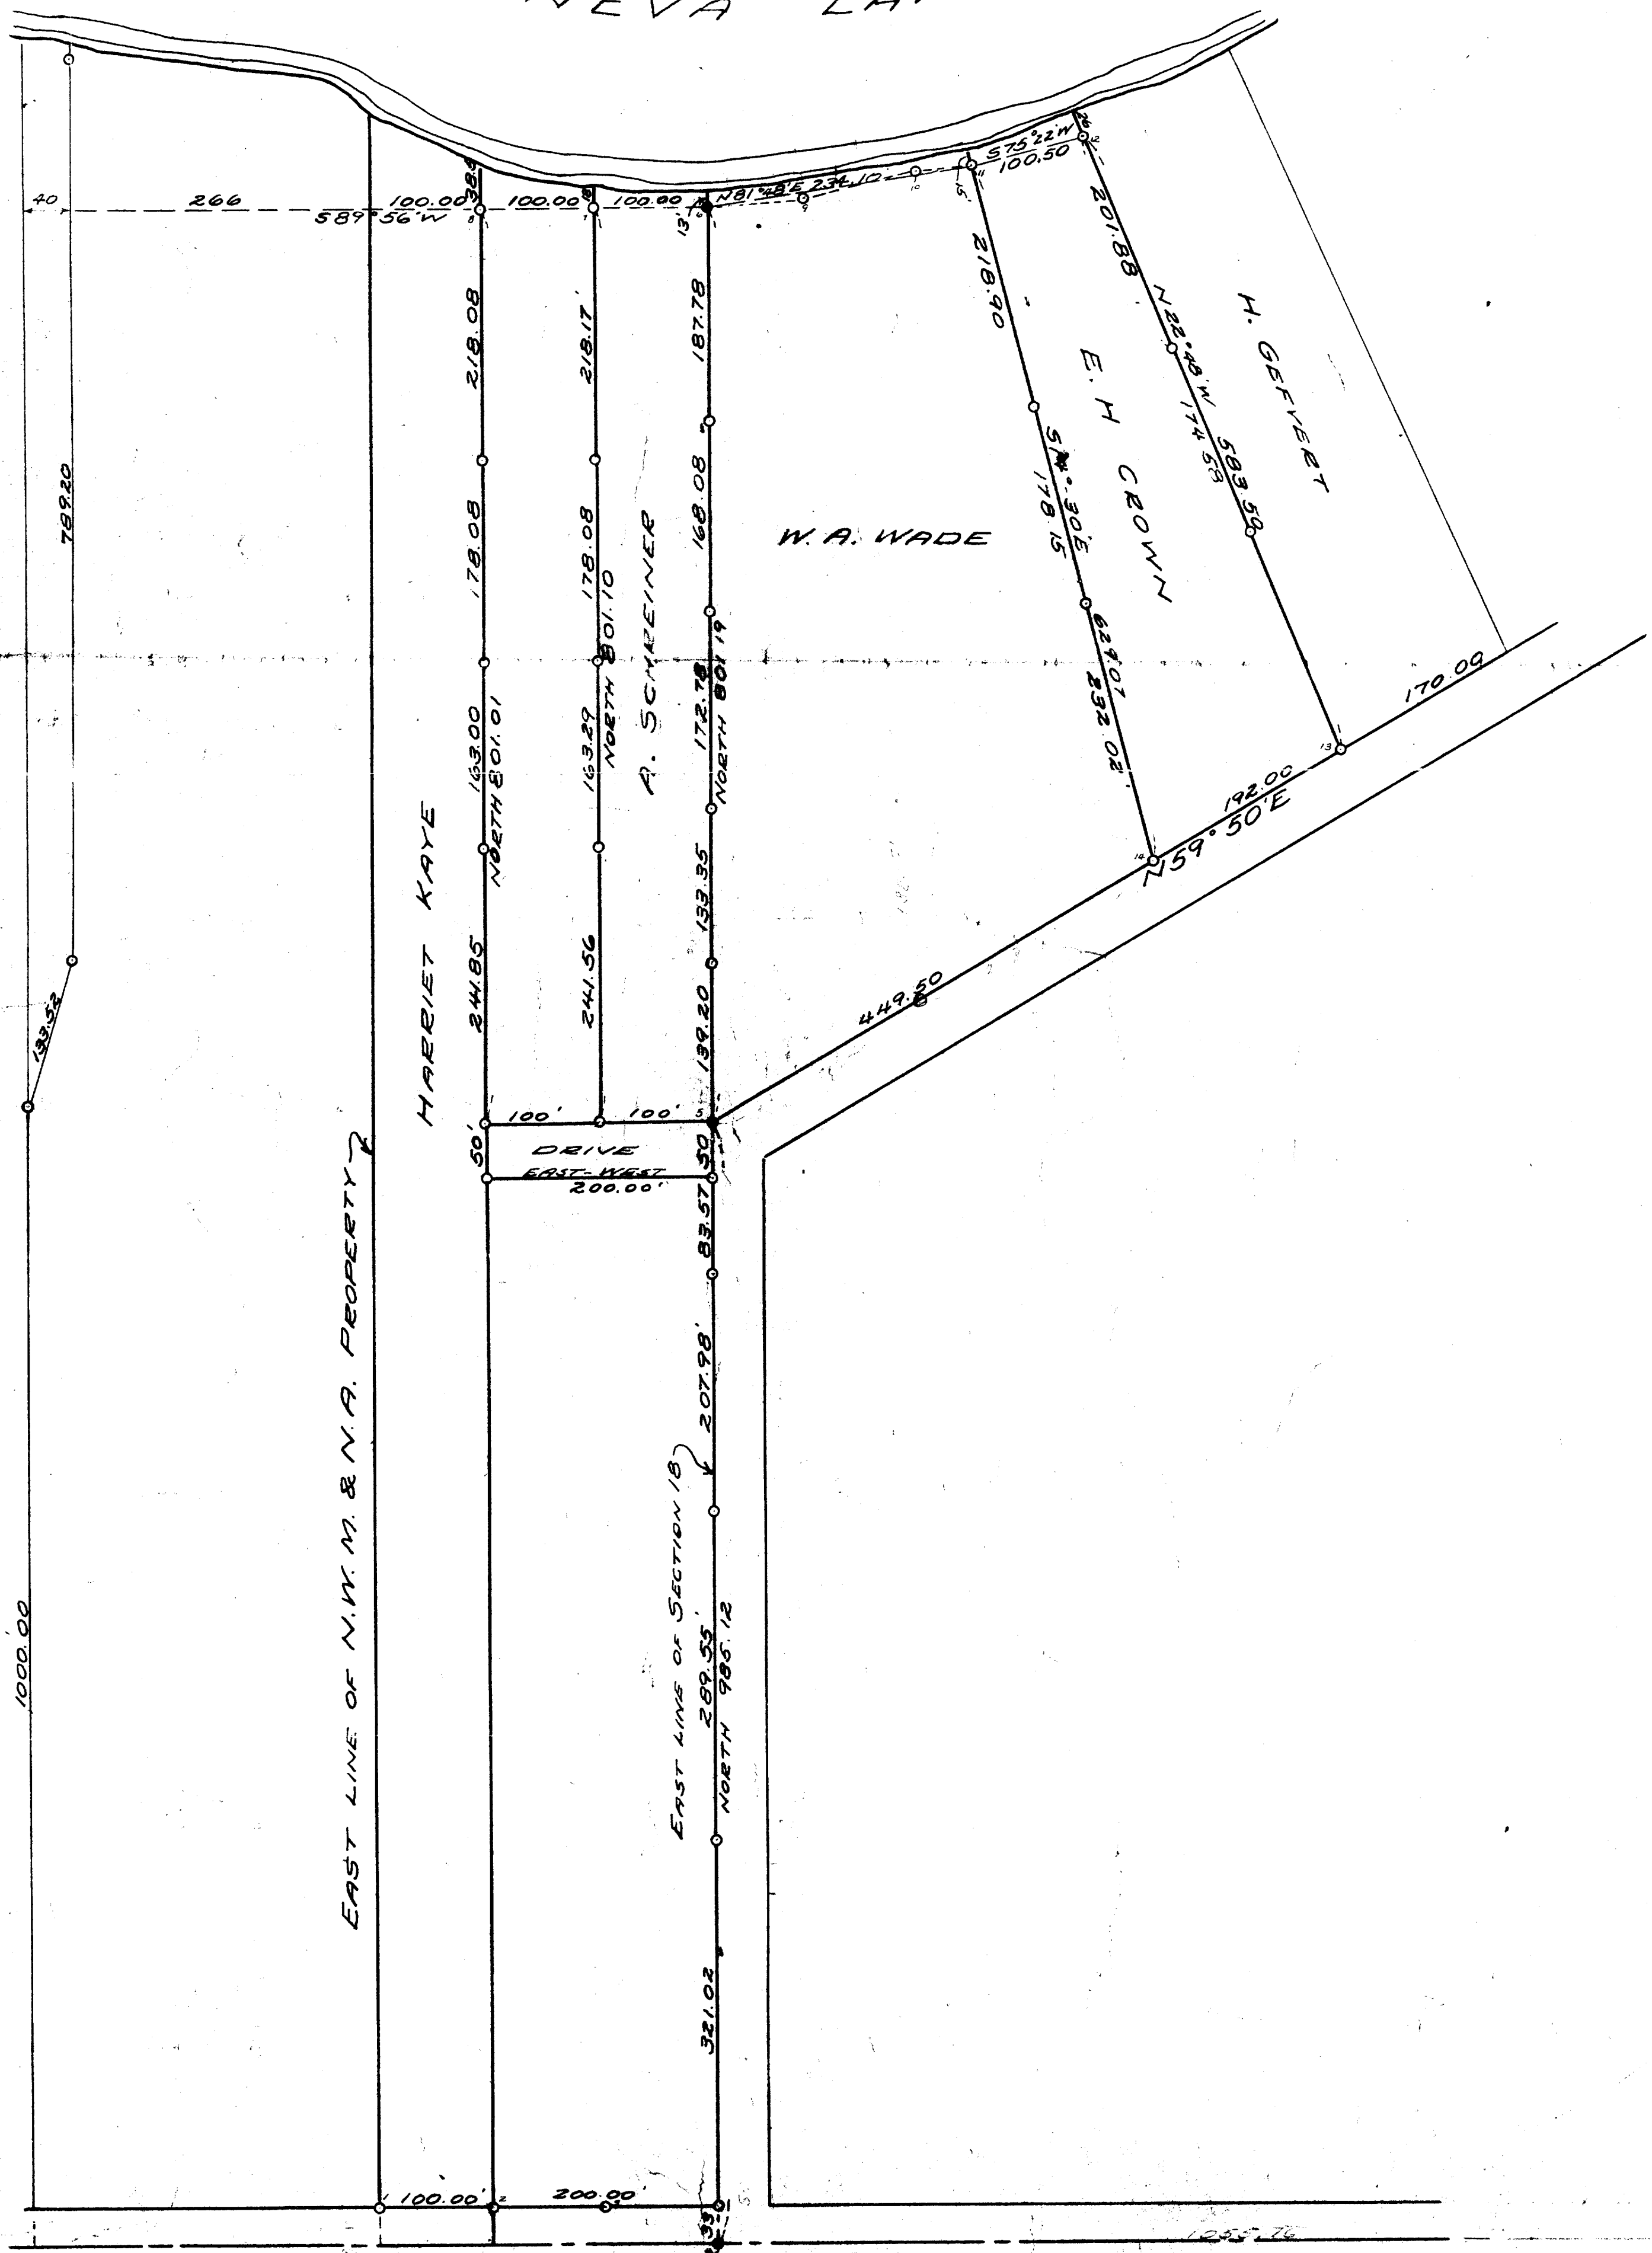

1/4 SECTION COR. BETWEEN SECTIONS 17 & 18, T1N, R1E

SCALE - 1" = 100'
 ○ = IRON PIPE
 ● = ROCK MONUMENT

PLAT OF SURVEY OF LANDS LOCATED IN THE NW FRACTIONAL 1/4 OF SECTION 17 AND THE NE FRACTIONAL 1/4 OF SECTION 18, T1N, R1E, WALWORTH COUNTY, WISCONSIN. IRON PIPES WERE FOUND AT POINTS NUMBERED FROM 1 TO 14
 NOV 18, 1940

H. E. Johnson
 SURVEYOR

L-17-12A, 13A
 12 and 11A, 11

L-18-1
 1E, 1B

L-18-2, 2CS, 4

117-454