


PLAT OF SURVEY

A PARCEL OF LAND LOCATED IN THE SOUTHWEST 1/4 OF THE NORTHEAST 1/4 OF SECTION 5 IN TOWNSHIP 1 NORTH, RANGE 17 EAST, IN THE TOWN OF LINN, WALWORTH COUNTY, WISCONSIN.

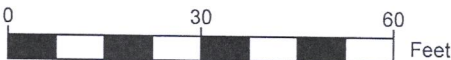

SCALE: 1"=30'


- NOTE:
- 1. BASIS OF BEARING: THE WISCONSIN STATE PLANE COORDINATE SYSTEM, NAD-83, SOUTH ZONE.
  - 2. FIELD WORK COMPLETED APRIL, 28 2021
  - 3. BUILDING SURVEYED TO THE EXTERIOR OF SIDING.
  - 4. FIELD CREW CHIEF: LOGAN RANDLE

LEGAL DESCRIPTION:

A PARCEL OF LAND LOCATED IN THE SOUTHWEST 1/4 OF THE NORTHEAST 1/4 OF SECTION 5 IN TOWNSHIP 1 NORTH, RANGE 17 EAST, IN THE TOWN OF LINN, WALWORTH COUNTY, WISCONSIN.

LOT 1 OF CERTIFIED SURVEY MAP NO. 675 AS RECORDED IN DOCUMENT NO. 18528 RECORDED IN WALWORTH COUNTY REGISTER OF DEEDS.

LOT 3  
CSM 675

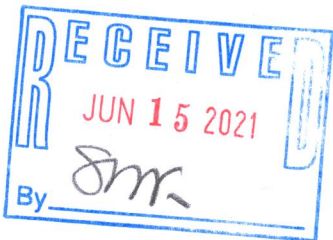

LEGEND

- FOUND 1" IRON PIPE
- FOUND IRON ROD
- △ FOUND MAG NAIL
- ▲ SET MAG NAIL
- EXISTING BUILDING
- EXISTING DECK
- EXISTING CONCRETE
- EXISTING PAVER SIDEWALK

LOT 2  
CSM 675

LOT 1  
CSM 675

OUTLOT 1  
CSM 675


SURVEY ORDERED BY:

BOB WEBSTER

PROPERTY ADDRESS:

W4237 ORIOLE DR,  
LAKE GENEVA, WI

PAUL H. VAN HENKELUM, PLS  
CARDINAL ENGINEERING LLC

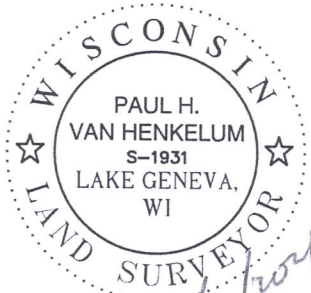

"I HEREBY CERTIFY THAT I HAVE SURVEYED THE ABOVE DESCRIBED PROPERTY AND THE MAP IS A TRUE AND CORRECT REPRESENTATION OF ITS EXTERIOR BOUNDARIES AND SHOWS THE SIZE AND LOCATION OF ALL VISIBLE STRUCTURES, APPARENT EASEMENTS AND ENCROACHMENTS, IF ANY.

PAUL H VAN HENKELUM, PLS #1931

DATE



CARDINAL ENGINEERING LLC  
DESIGNING IN TRUE DIRECTIONS

PO BOX 281 - 1200 LA SALLE ST.  
LAKE GENEVA, WI 53147  
262-757-8776  
CARDINALENGINEERINGWI.COM

DATE: 04/29/2021 JOB No. 21371  
SHEET 1 OF 1 LGC

IA 675-1

117-4523