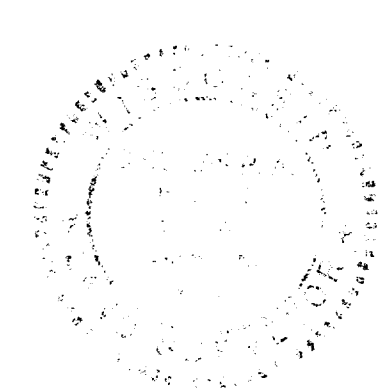
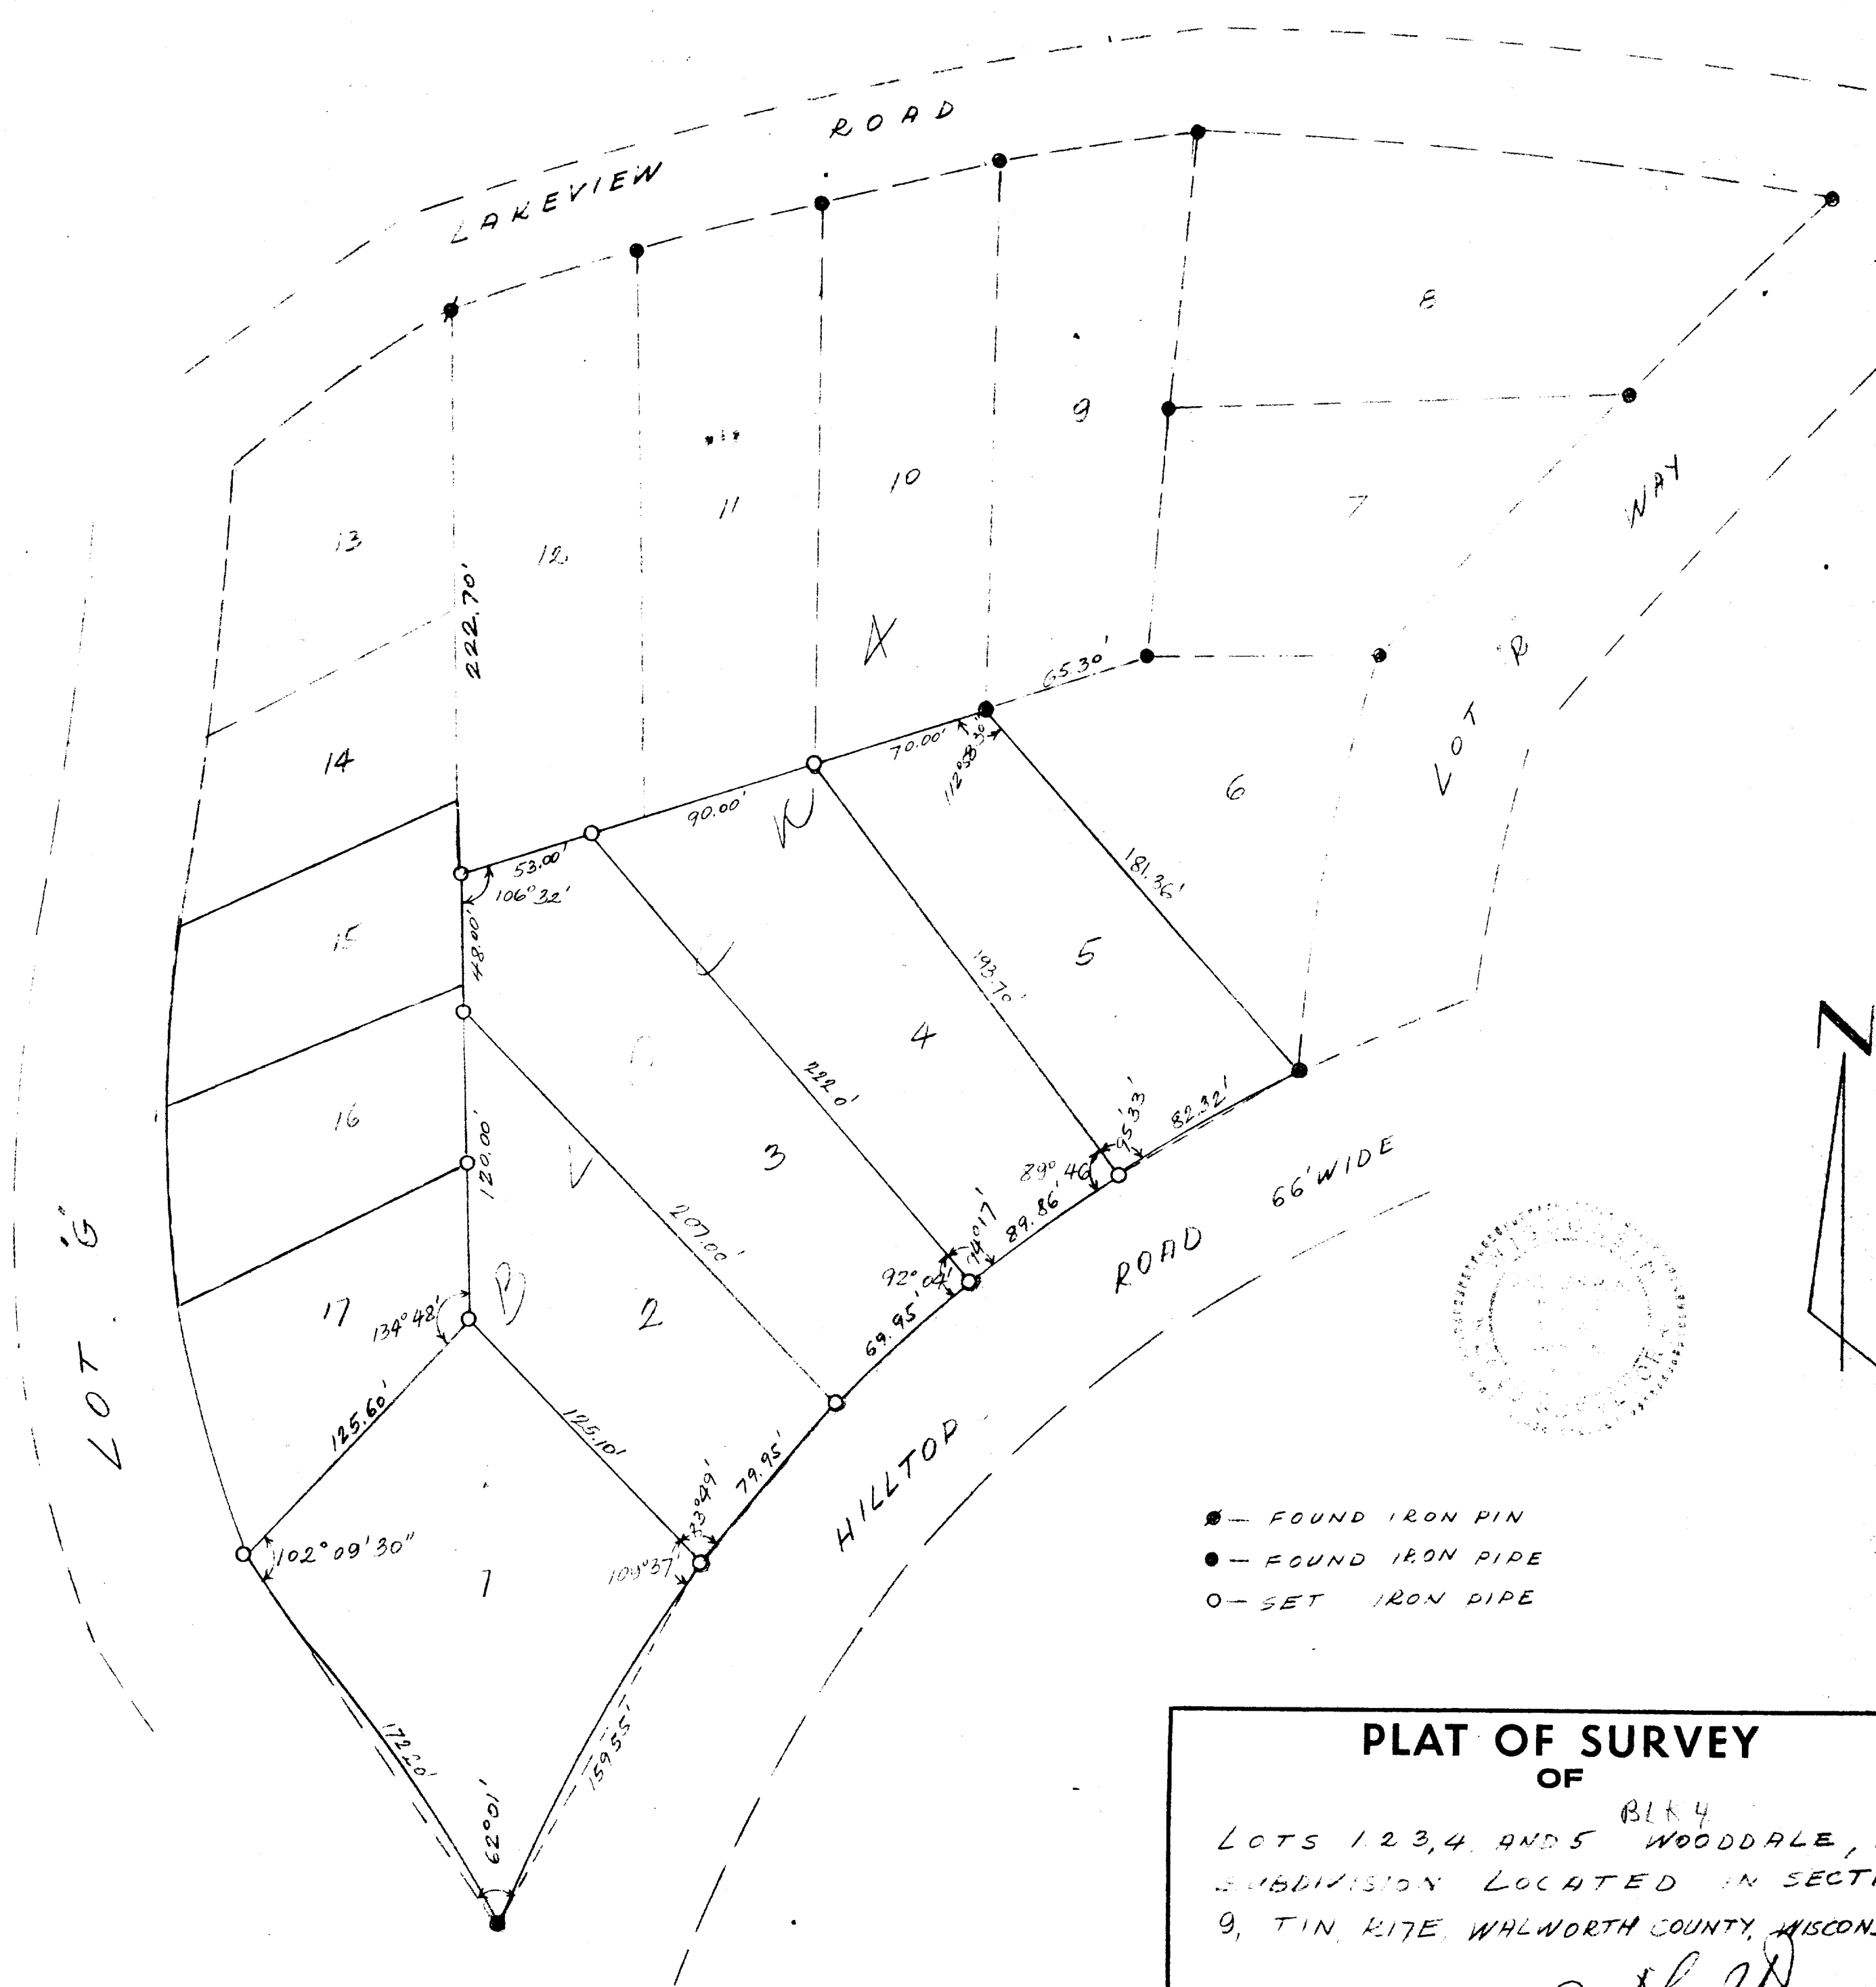


- — FOUND IRON PIN
- — FOUND IRON PIPE
- — SET IRON PIPE

PLAT OF SURVEY OF	
BLK 4 LOTS 1, 2, 3, 4, AND 5 WOODDALE, A SUBDIVISION LOCATED IN SECTION 9, T1N, R17E, WALWORTH COUNTY, WISCONSIN	
 SURVEYOR	
SCALE 1" = 50'	DATE NOV 7-1974

IW - 43A
 " 44
 43A + 45 (part of)