

BOUNDARY SURVEY

LAKE GENEVA

— WORK ORDERED BY —
GENEVA LAKEFRONT REALTY, LLC
323 BROAD STREET, SUITE 1S
LAKE GENEVA, WI 53147

FARRIS, HANSEN & ASSOCIATES, INC.

ENGINEERING - ARCHITECTURE - SURVEYING
- SIDEWAY COURT BOY 437

ELKHORN, WISCONSIN 53121


OFFICE: (202) 723-2990 FAX: (202) 723-2990

REVISIONS

PROJECT NO.
10459

DATE
AUGUST 21, 2021

SHEET NO.
OF 1

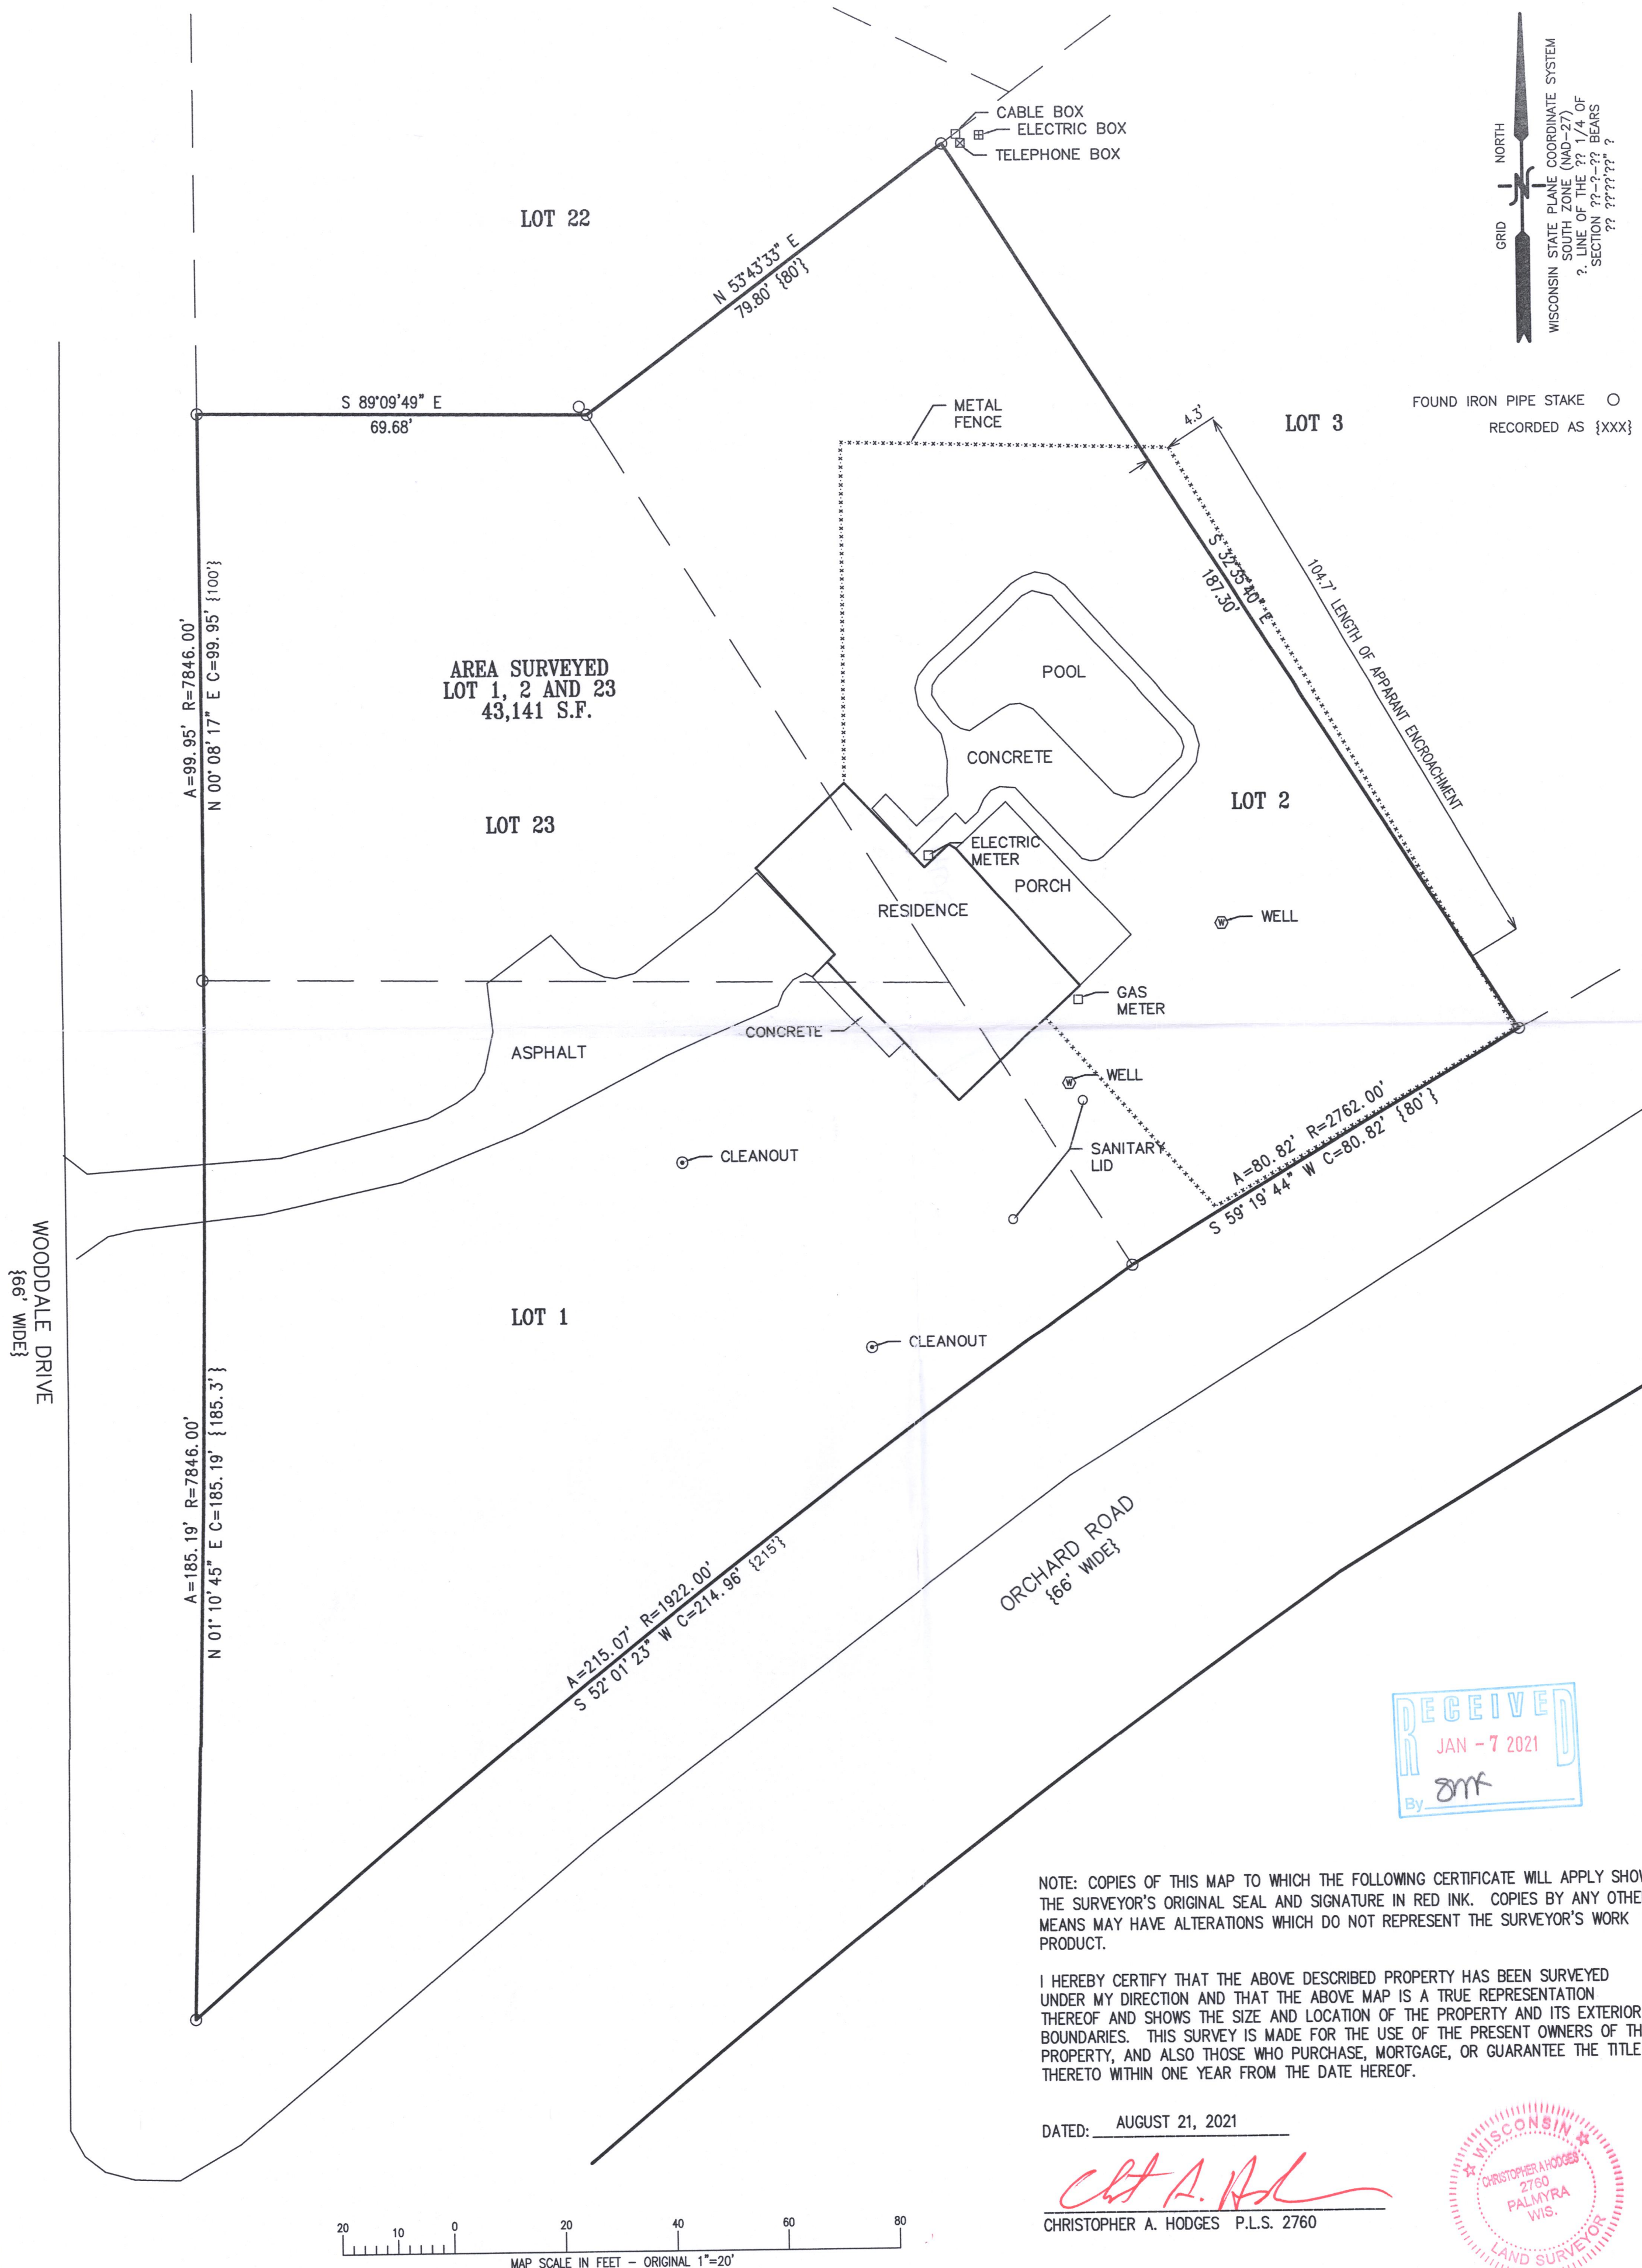

NOTE: COPIES OF THIS MAP TO WHICH THE FOLLOWING CERTIFICATE WILL APPLY SHOW THE SURVEYOR'S ORIGINAL SEAL AND SIGNATURE IN RED INK. COPIES BY ANY OTHER MEANS MAY HAVE ALTERATIONS WHICH DO NOT REPRESENT THE SURVEYOR'S WORK PRODUCT.

I HEREBY CERTIFY THAT THE ABOVE DESCRIBED PROPERTY HAS BEEN SURVEYED UNDER MY DIRECTION AND THAT THE ABOVE MAP IS A TRUE REPRESENTATION THEREOF AND SHOWS THE SIZE AND LOCATION OF THE PROPERTY AND ITS EXTERIOR BOUNDARIES. THIS SURVEY IS MADE FOR THE USE OF THE PRESENT OWNERS OF THE PROPERTY, AND ALSO THOSE WHO PURCHASE, MORTGAGE, OR GUARANTEE THE TITLE THERETO WITHIN ONE YEAR FROM THE DATE HEREOF.

DATED: AUGUST 21, 2021

CHRISTOPHER A. HODGES P.L.S. 2760

A circular red ink stamp. The outer ring contains the text "WISCONSIN" at the top and "LAND SURVEYOR" at the bottom, separated by two five-pointed stars. The inner circle contains the text "CHRISTOPHER A. HODGES" on the first line, "2760" on the second line, "PALMYRA" on the third line, and "WIS." on the fourth line.

IW-58

117-4613