


**REGISTERED PROFESSIONAL LAND SURVEYOR
LAKE GENEVA, WISCONSIN**

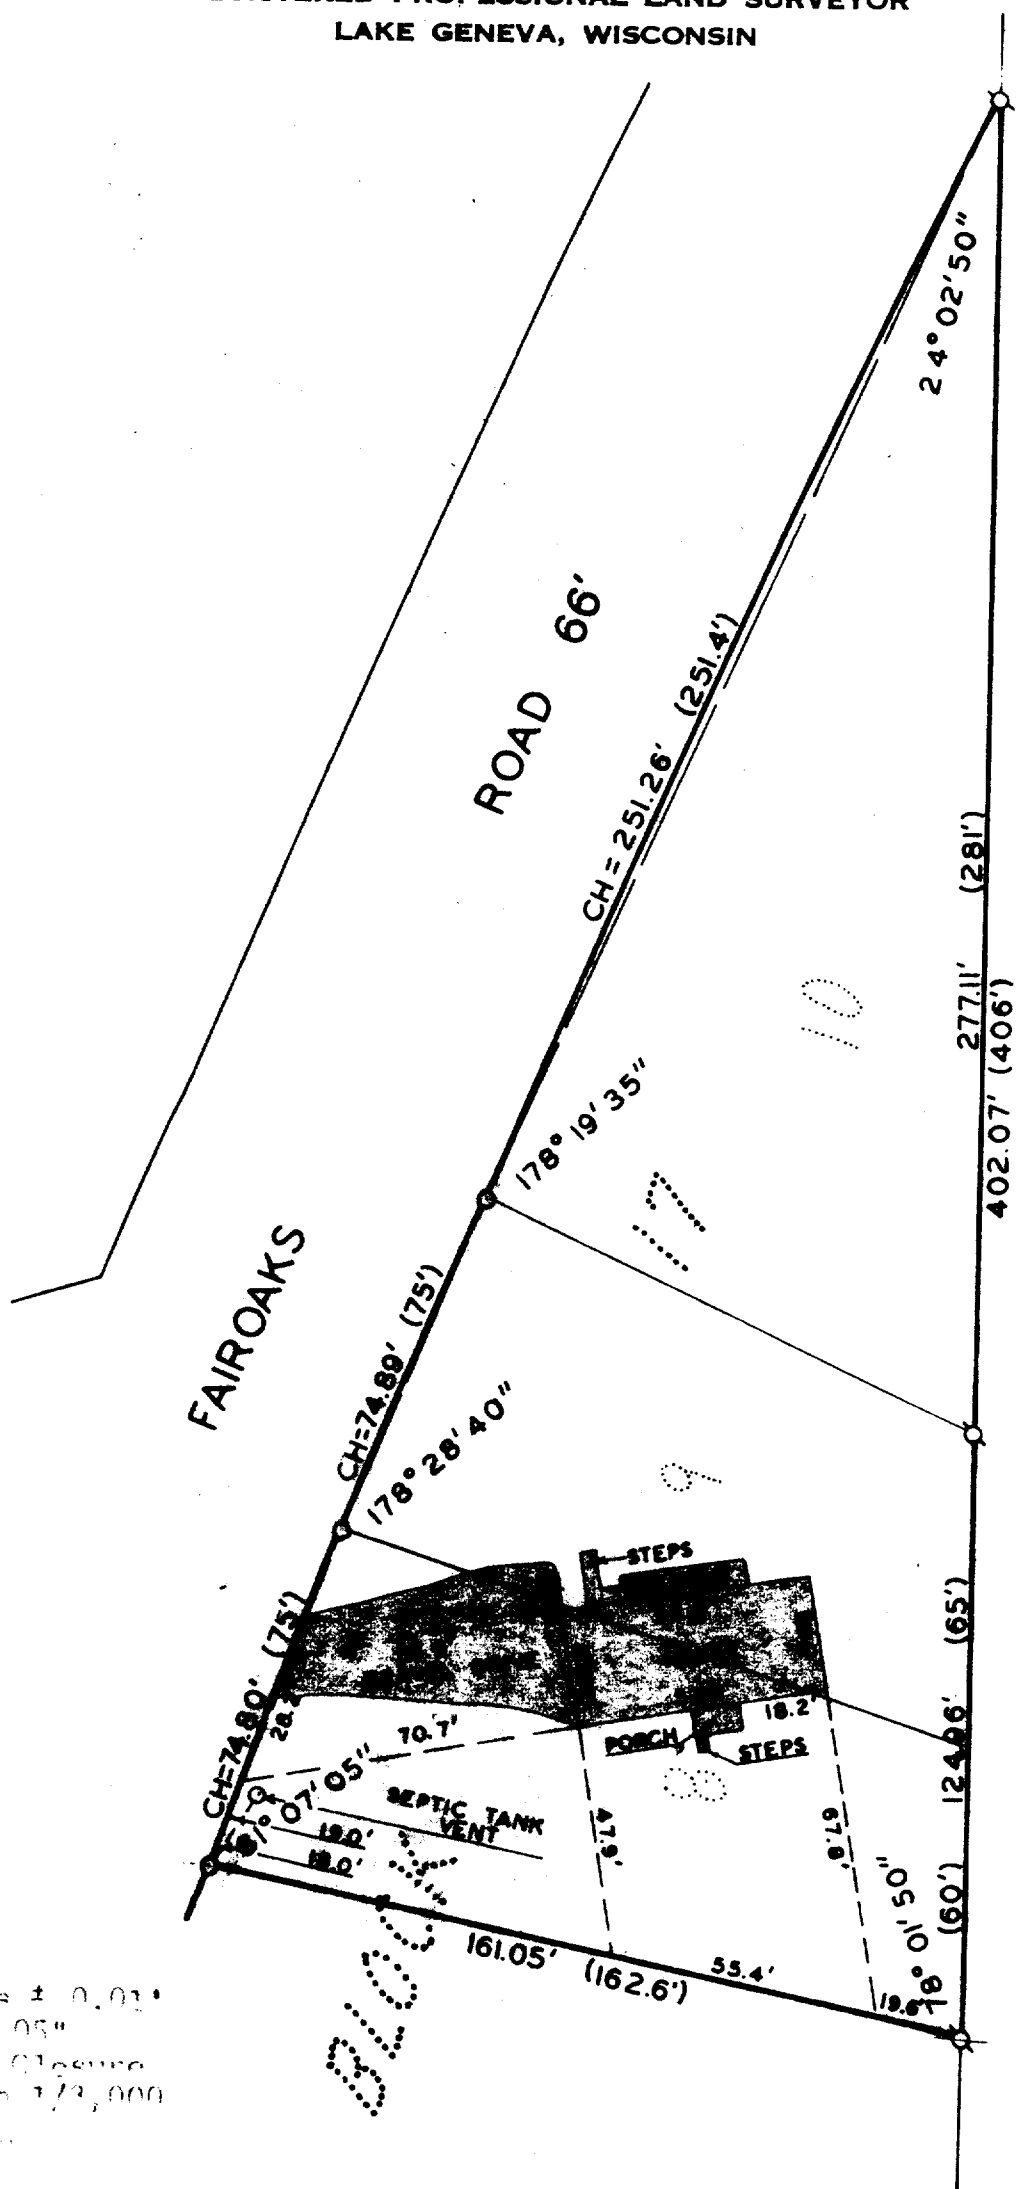

ACCURACY: Distances $\pm 0.01'$
Angles $\pm 05''$
Error of Closure
less than 1/2,000
OWNER: John Smith

PLAT OF SURVEY OF

Lots 8, 9 and 10, Block 17, Wooddale Subd.
located in the Northeast 1/4 Section 16, T 1 N,
R 17 E, Walworth County, Wisconsin.



SCALE 1"=40'

LEGEND

- φ — IRON PIPE FOUND
 ○ — IRON PIPE PLACED
 ● — CONCRETE MONUMENT
 X — SPIKE



I, HAROLD H. KOLB, DO HEREBY CERTIFY THAT I HAVE SURVEYED THE PROPERTY HEREON DESCRIBED ACCORDING TO THE OFFICIAL RECORDS, AND THAT THE PLAT HEREON IS A CORRECT REPRESENTATION OF THE LOT LINES.

Harold H. Koll

HAROLD H. KOLB
WISCONSIN REGISTERED LAND SURVEYOR, S-187

DATE Nov. 25, 1974
REVISED DATE: JUNE 17, 1975

Iw-81C

117-476