

PLAT OF SURVEY

N1935 BIRCHES DRIVE
LAKE GENEVA, WI 53147



— WORK ORDERED BY —
MICHAEL CHORNEYKO — MDC, INC.
40W304 LAFOR ROAD, SUITE B
ST CHARLES, IL 60175

FARRIS, HANSEN & ASSOCIATES, INC.
ENGINEERING — ARCHITECTURE — SURVEYING
7 RIDGWAY COURT P.O. BOX 437
ELKHORN, WISCONSIN 53121
PHONE: (262) 723-2098 e-mail: office@farris-hansen.com

REVISIONS

PROJECT NO.
10901
DATE
6/21/2023
SHEET NO.
1 OF 1

PLAT OF SURVEY
LOT 14, THE BIRCHES FIRST ADDITION
LOCATED IN THE SE 1/4 OF THE NE 1/4 OF SECTION 9, TOWN 1 NORTH, RANGE 17 EAST,
TOWN OF LINN, WALWORTH COUNTY, WISCONSIN

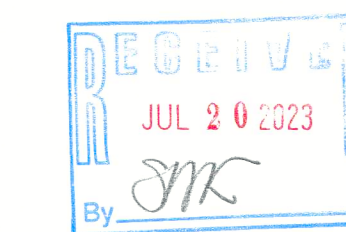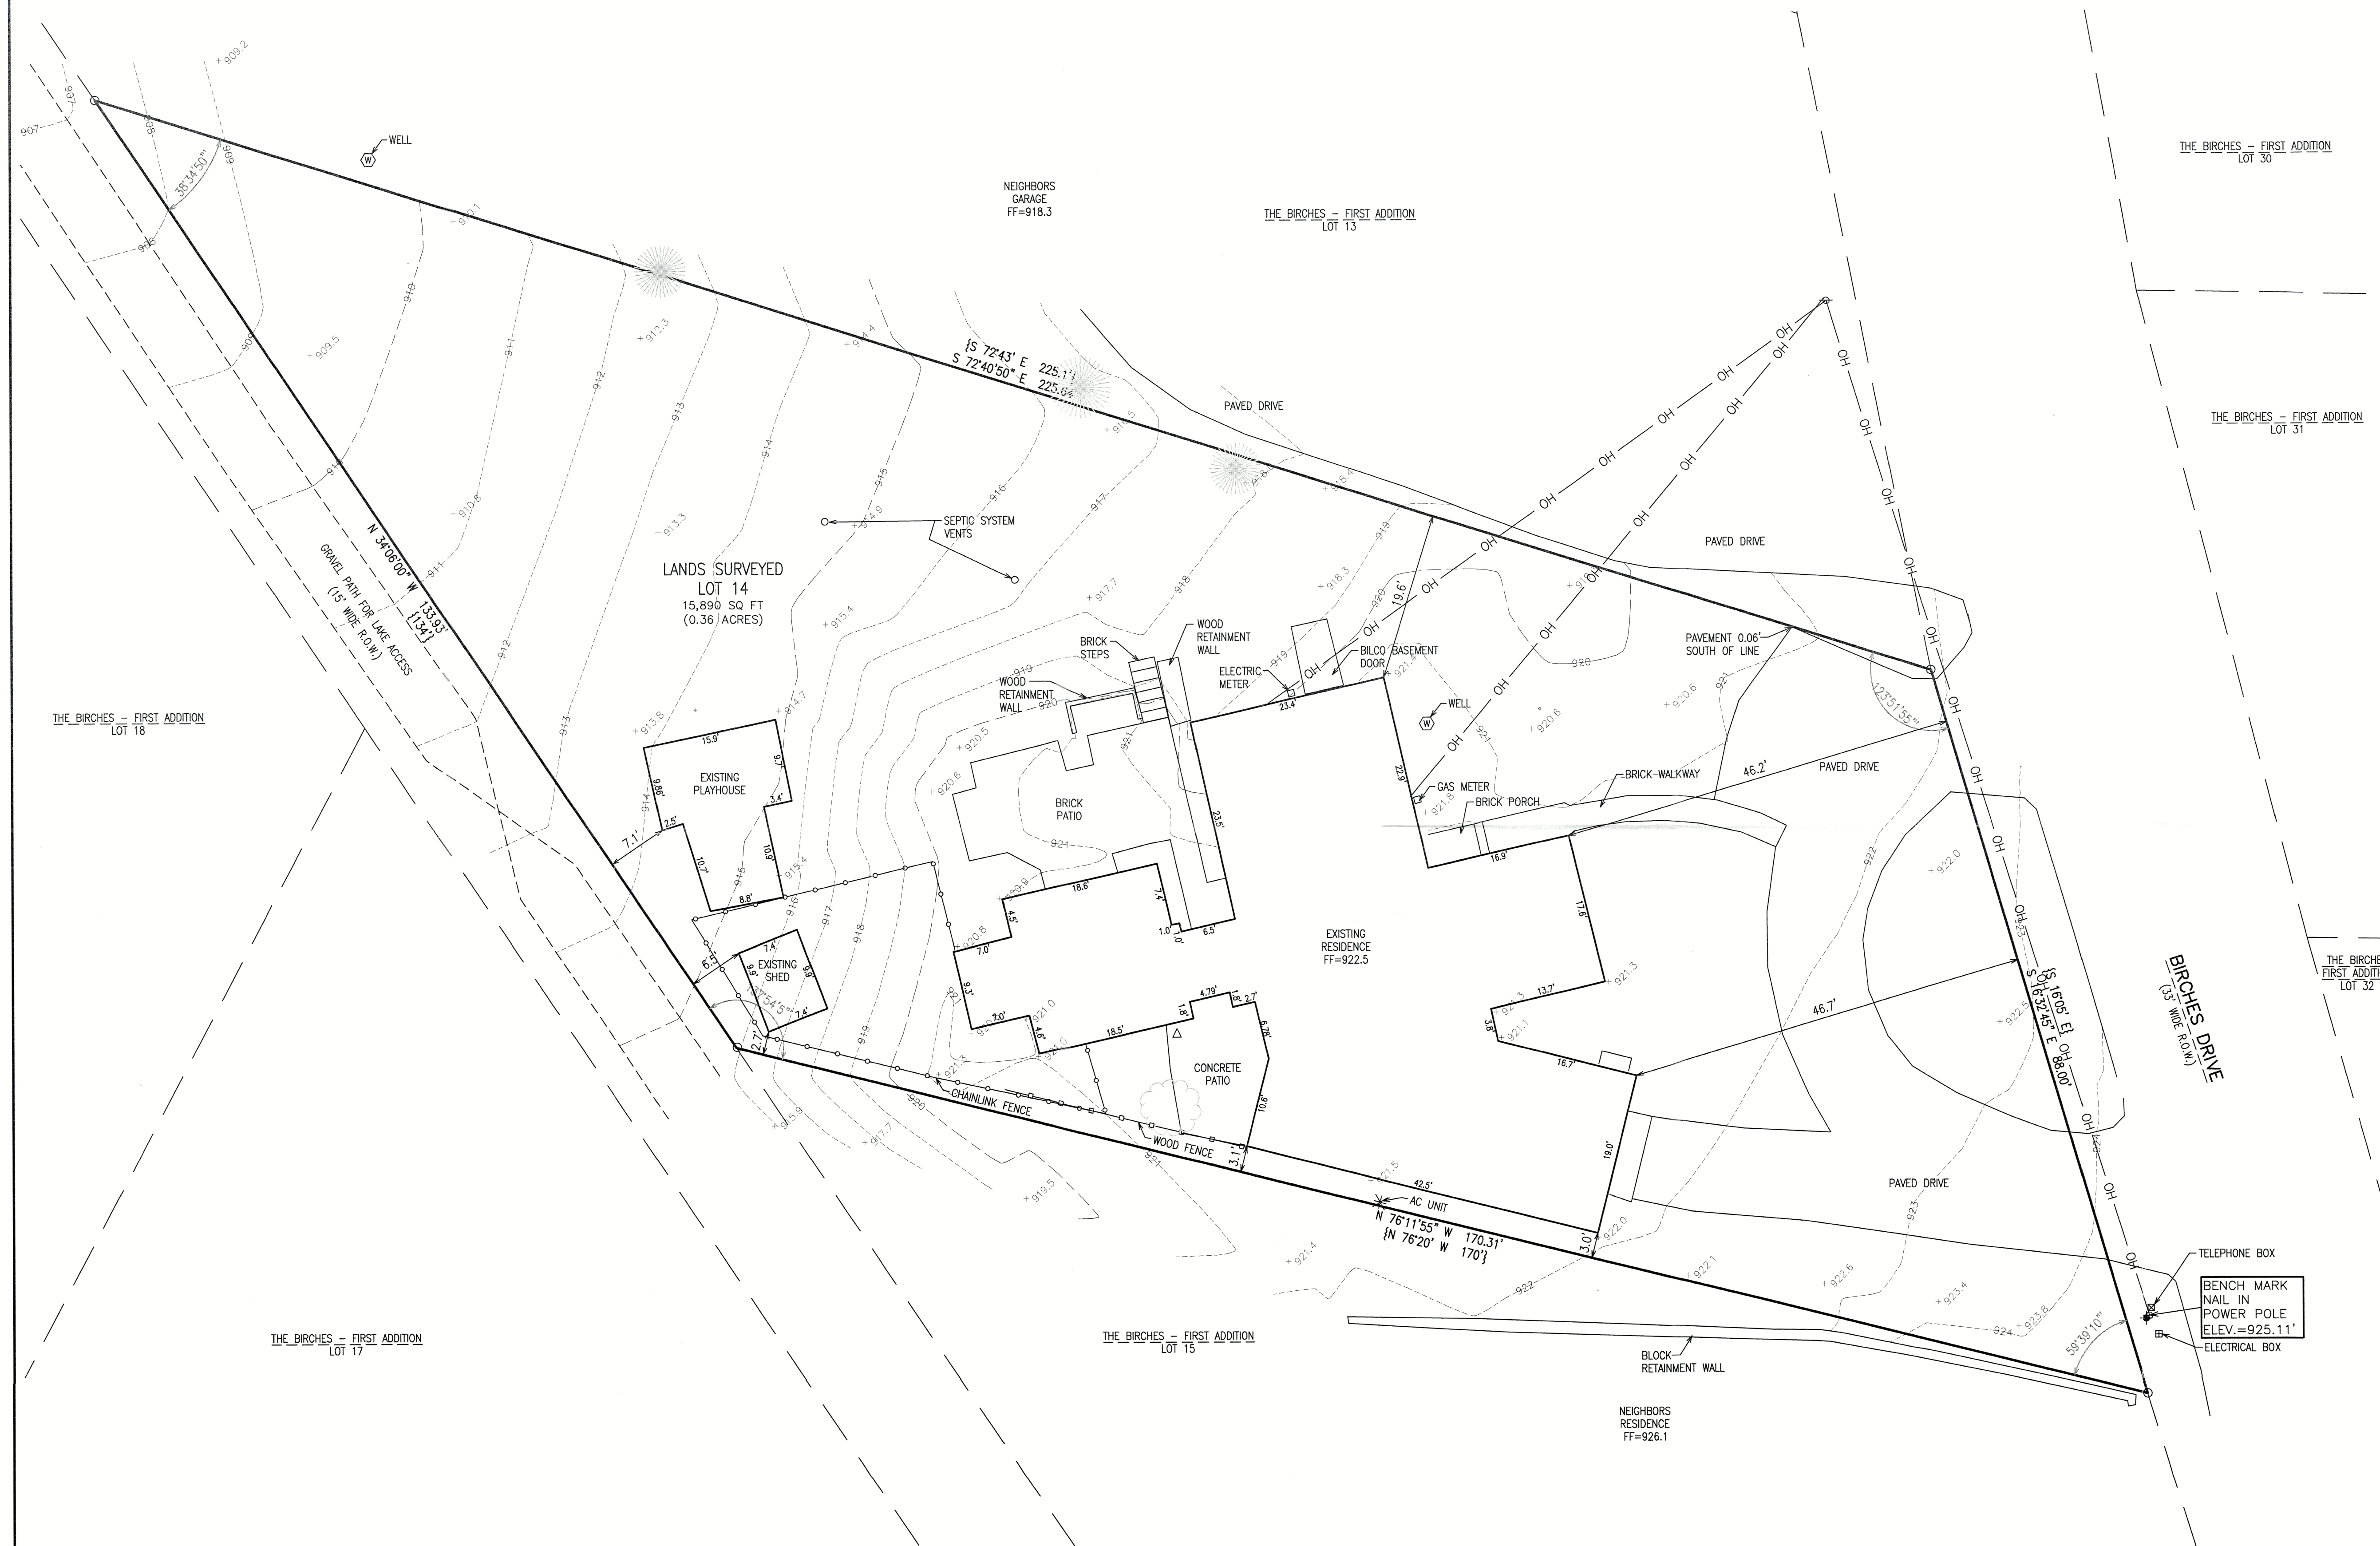


NOTE: COPIES OF THIS MAP TO WHICH THE FOLLOWING CERTIFICATE WILL APPLY SHOW THE SURVEYOR'S ORIGINAL SEAL AND SIGNATURE IN RED INK. COPIES BY ANY OTHER MEANS MAY HAVE ALTERATIONS WHICH DO NOT REPRESENT THE SURVEYOR'S WORK PRODUCT.

I HEREBY CERTIFY THAT THE ABOVE DESCRIBED PROPERTY HAS BEEN SURVEYED UNDER MY DIRECTION AND THAT THE ABOVE MAP IS A TRUE REPRESENTATION THEREOF AND SHOWS THE SIZE AND LOCATION OF THE PROPERTY AND ITS EXTERIOR BOUNDARIES. THIS SURVEY IS MADE FOR THE USE OF THE PRESENT OWNERS OF THE PROPERTY, AND ALSO THOSE WHO PURCHASE, MORTGAGE, OR GUARANTEE THE TITLE THERETO WITHIN ONE YEAR FROM THE DATE HEREOF.

DATED: 6/21/2023

CHRISTOPHER A. HODGES P.L.S. 2760

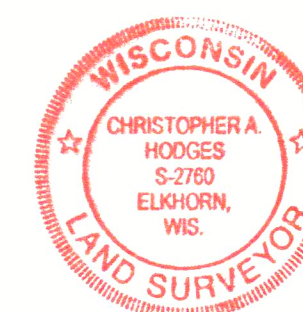

X:\Projects\10901\ACAD\10901.dwg

MAP SCALE IN FEET - ORIGINAL 1"=10'

IBA1-7

1124788