


HAROLD H. KOLB
REGISTERED PROFESSIONAL LAND SURVEYOR
LAKE GENEVA, WISCONSIN

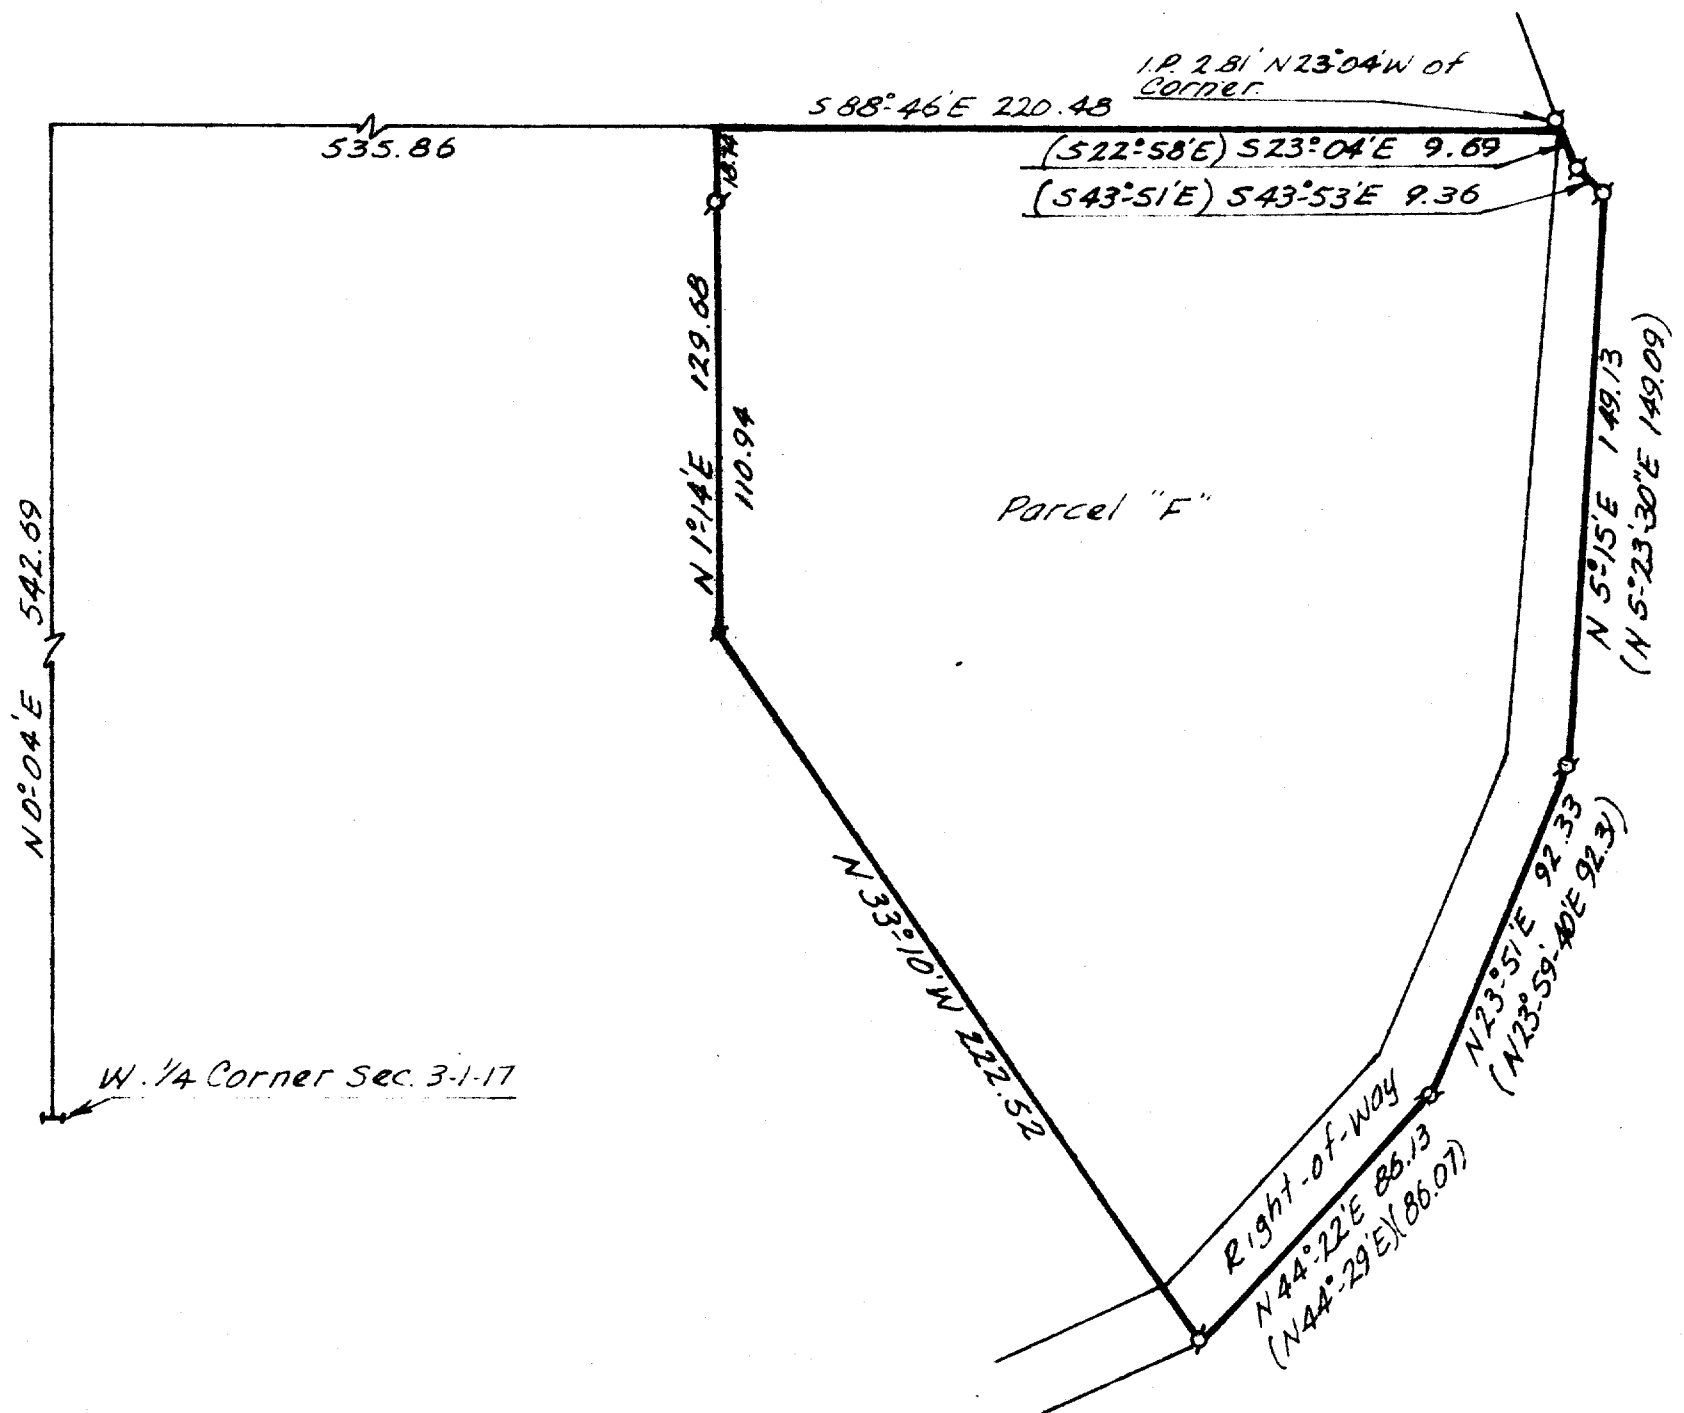

PLAT OF SURVEY OF

A parcel of land located in the West 1/4 of Section 3, T 1 N, R 17 E, Walworth County, Wisconsin and described as follows; to wit:
Commencing at the West 1/4 corner of said Section 3, thence N 0°04' E 542.69 feet; thence S 88°46' E 535.86 feet to the place of beginning; thence continue S 88°46' E 220.48 feet; thence S 23°04' E 9.69 feet; thence S 43°53' E 9.36 feet; thence S 5°15' W 149.13 feet; thence S 23°51' W 92.33 feet; thence S 44°22' W 86.13 feet; thence N 33°10' W 222.52 feet; thence N 1°14' E 129.68 feet to the place of beginning.
Containing 1.34 Acres.

N



Parcel BB-1C4
Bonnie Brae

LEGEND

- Ø - IRON PIPE FOUND
 - - IRON PIPE PLACED
 - - CONCRETE MONUMENT
 - x - SPIKE
 - () - RECORD DISTANCE OR BEARING
- SCALE - 1" = 50'

I, HAROLD H. KOLB, DO HEREBY CERTIFY THAT I HAVE SURVEYED THE PROPERTY HEREON DESCRIBED ACCORDING TO THE OFFICIAL RECORDS, AND THAT THE PLAT HEREON IS A CORRECT REPRESENTATION OF THE LOT LINES.

Harold H. Kolb

HAROLD H. KOLB
WISCONSIN REGISTERED LAND SURVEYOR, S-187
DATE SEPT. 26, 1969

BB-1C4

117-506