

HAROLD H. KOLB


REGISTERED PROFESSIONAL LAND SURVEYOR
LAKE GENEVA, WISCONSIN

LAKE SHORE DRIVE 50' WIDE

PLAT OF SURVEY OF

PART OF LOT 5, BLOCK 1, ROWENA PARK SUB-
DIVISION, T1N, R17E, WALWORTH COUNTY,
WISCONSIN.

NOTE: THE WESTERLY LINE OF SAID LOT 5
IS ASSUMED S 32° 23' 00" E AS
SHOWN ON CERTIFIED SURVEY NO. 99,
RECORDED IN VOLUME 1 OF
CERTIFIED SURVEY MAPS, PAGE 99,
WALWORTH COUNTY, WISCONSIN.

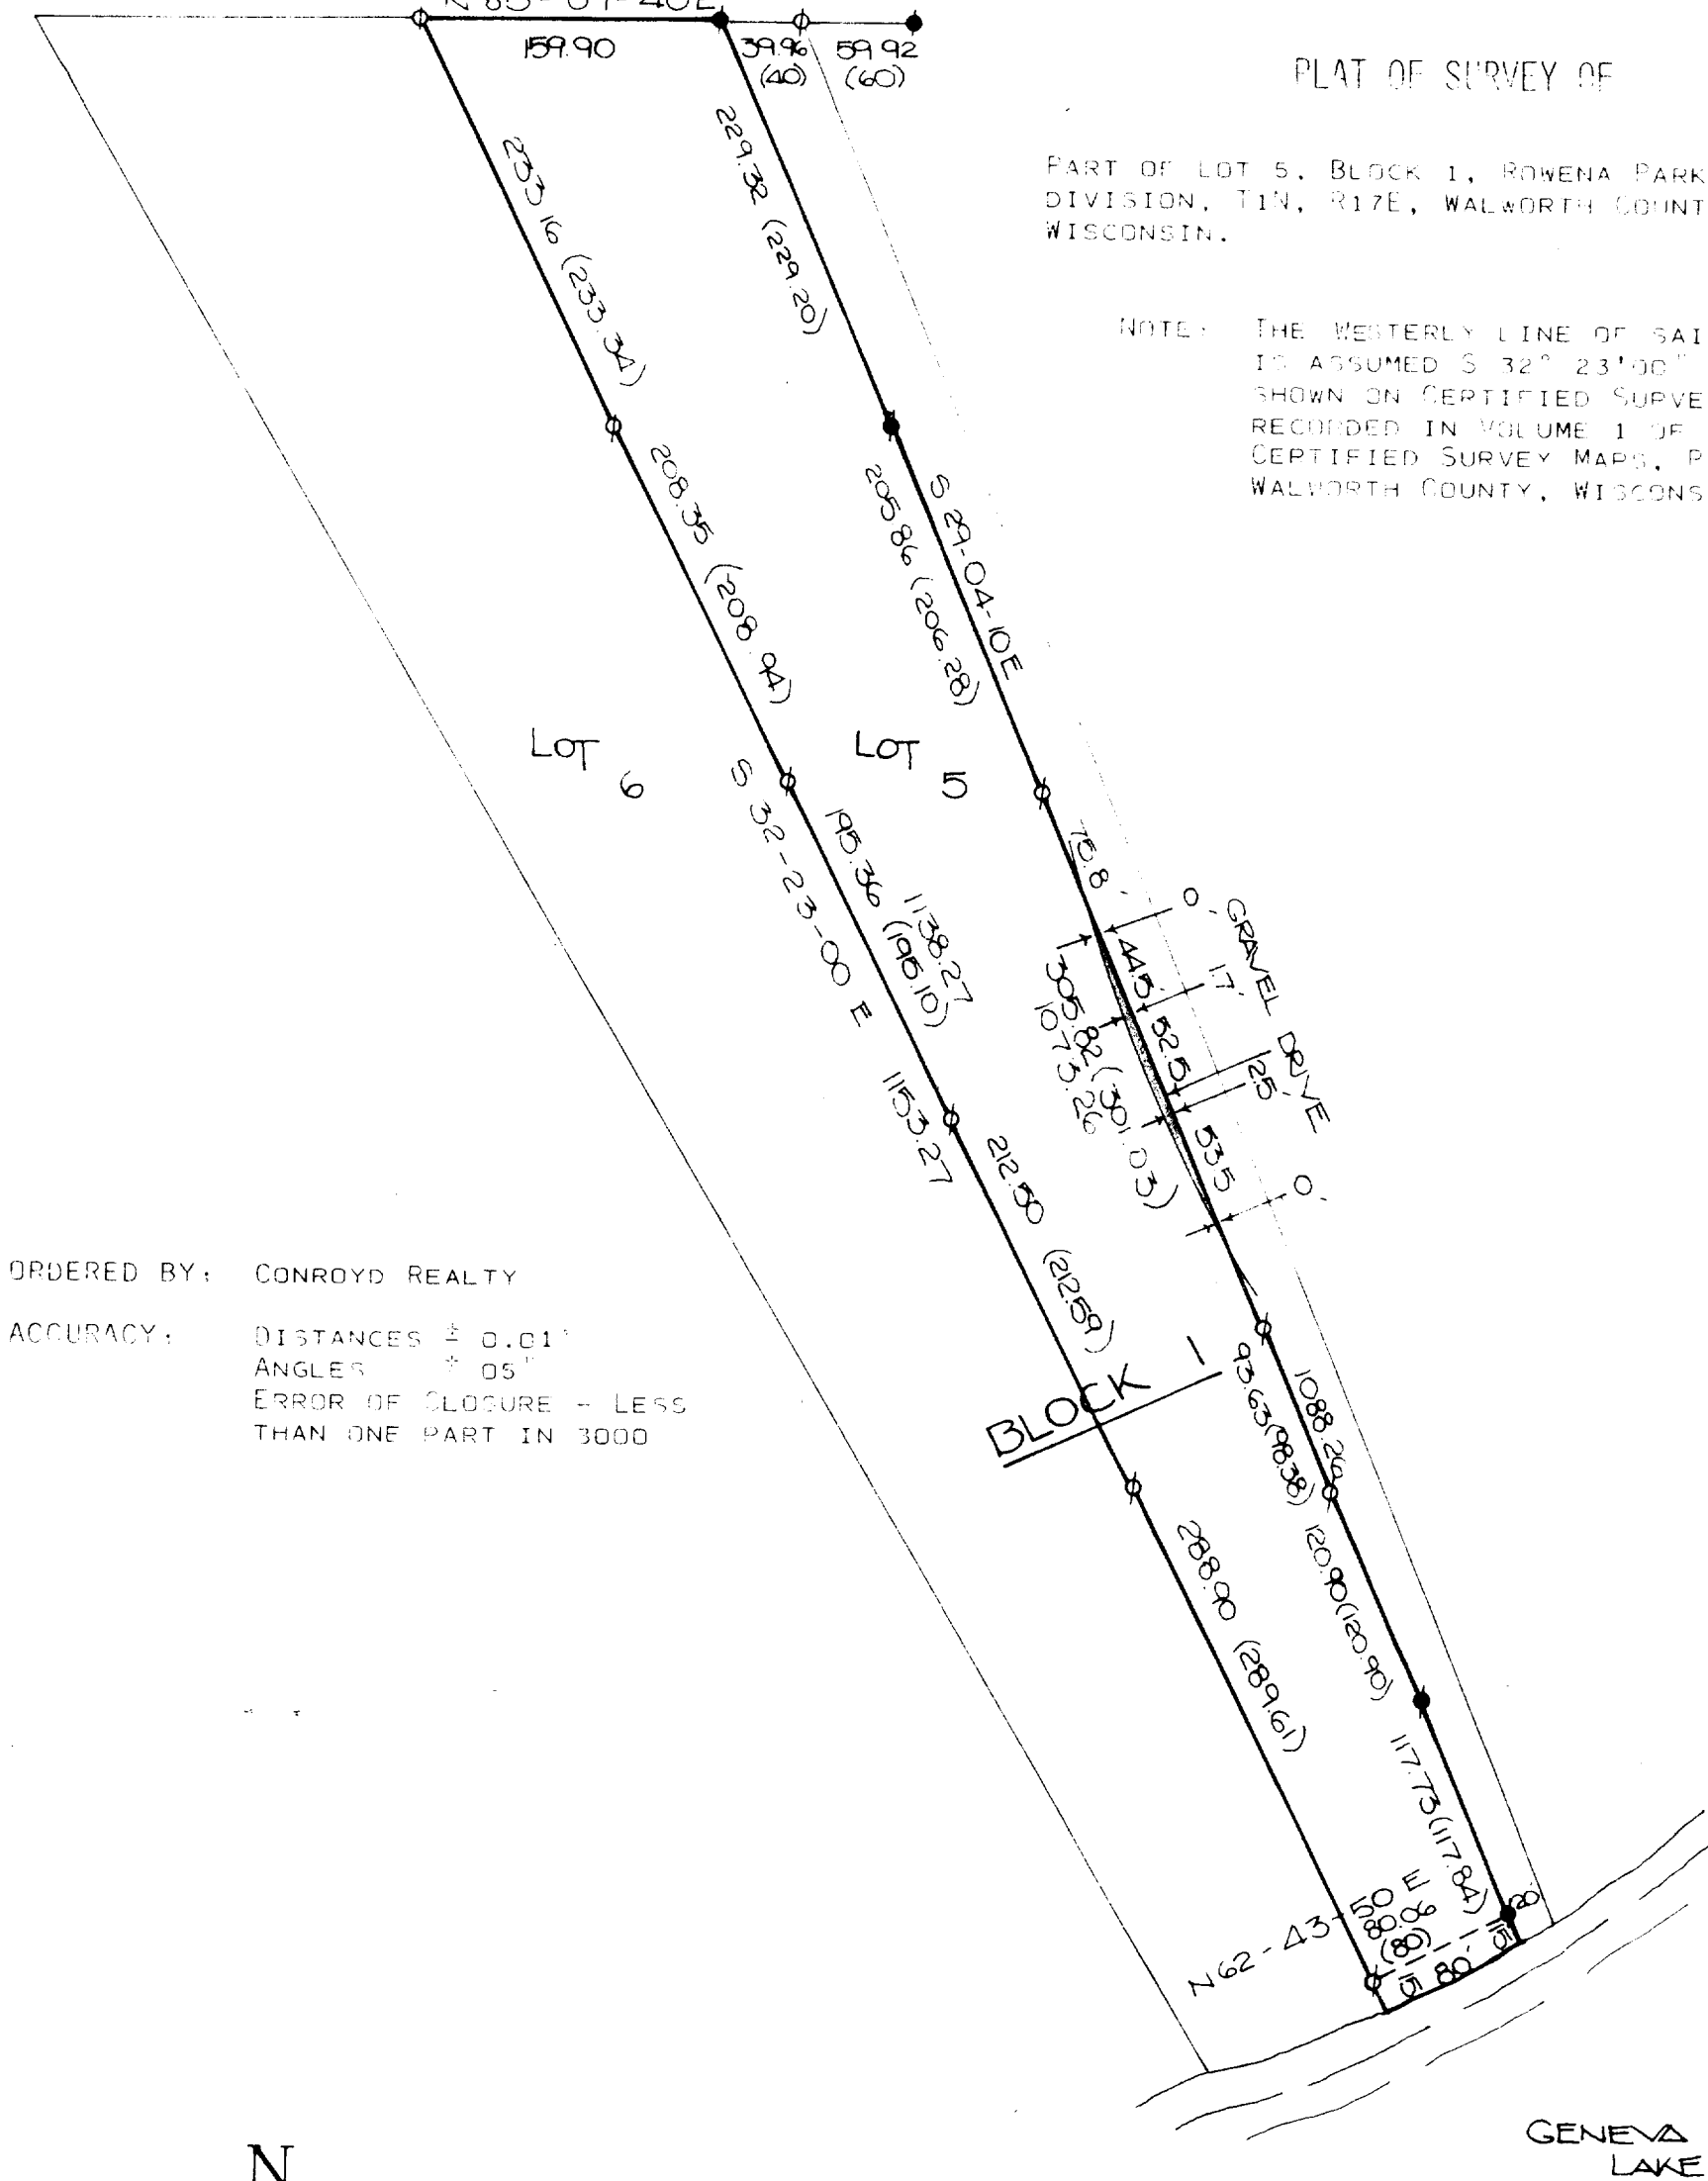

ORDERED BY: CONROYD REALTY

ACCURACY: DISTANCES $\pm 0.01'$
ANGLES $\pm 05''$
ERROR OF CLOSURE $\pm$ LESS
THAN ONE PART IN 3000

N

SCALE 1"=100'

LEGEND

- φ - IRON PIPE FOUND
- - IRON PIPE PLACED
- - CONCRETE MONUMENT
- x - SPIKE
- () - RECORDED AS



I, HAROLD H. KOLB, DO HEREBY CERTIFY THAT I HAVE
SURVEYED THE PROPERTY HEREON DESCRIBED ACCORDING
TO THE OFFICIAL RECORDS, AND THAT THE PLAT HEREON
IS A CORRECT REPRESENTATION OF THE LOT LINES.

HAROLD H. KOLB
WISCONSIN REGISTERED LAND SURVEYOR, S-187
DATE Aug 12, 1976

117-528