


GEORGE T. DUNHAM
SURVEYOR & LANDS
DELAVER, WISCONSIN

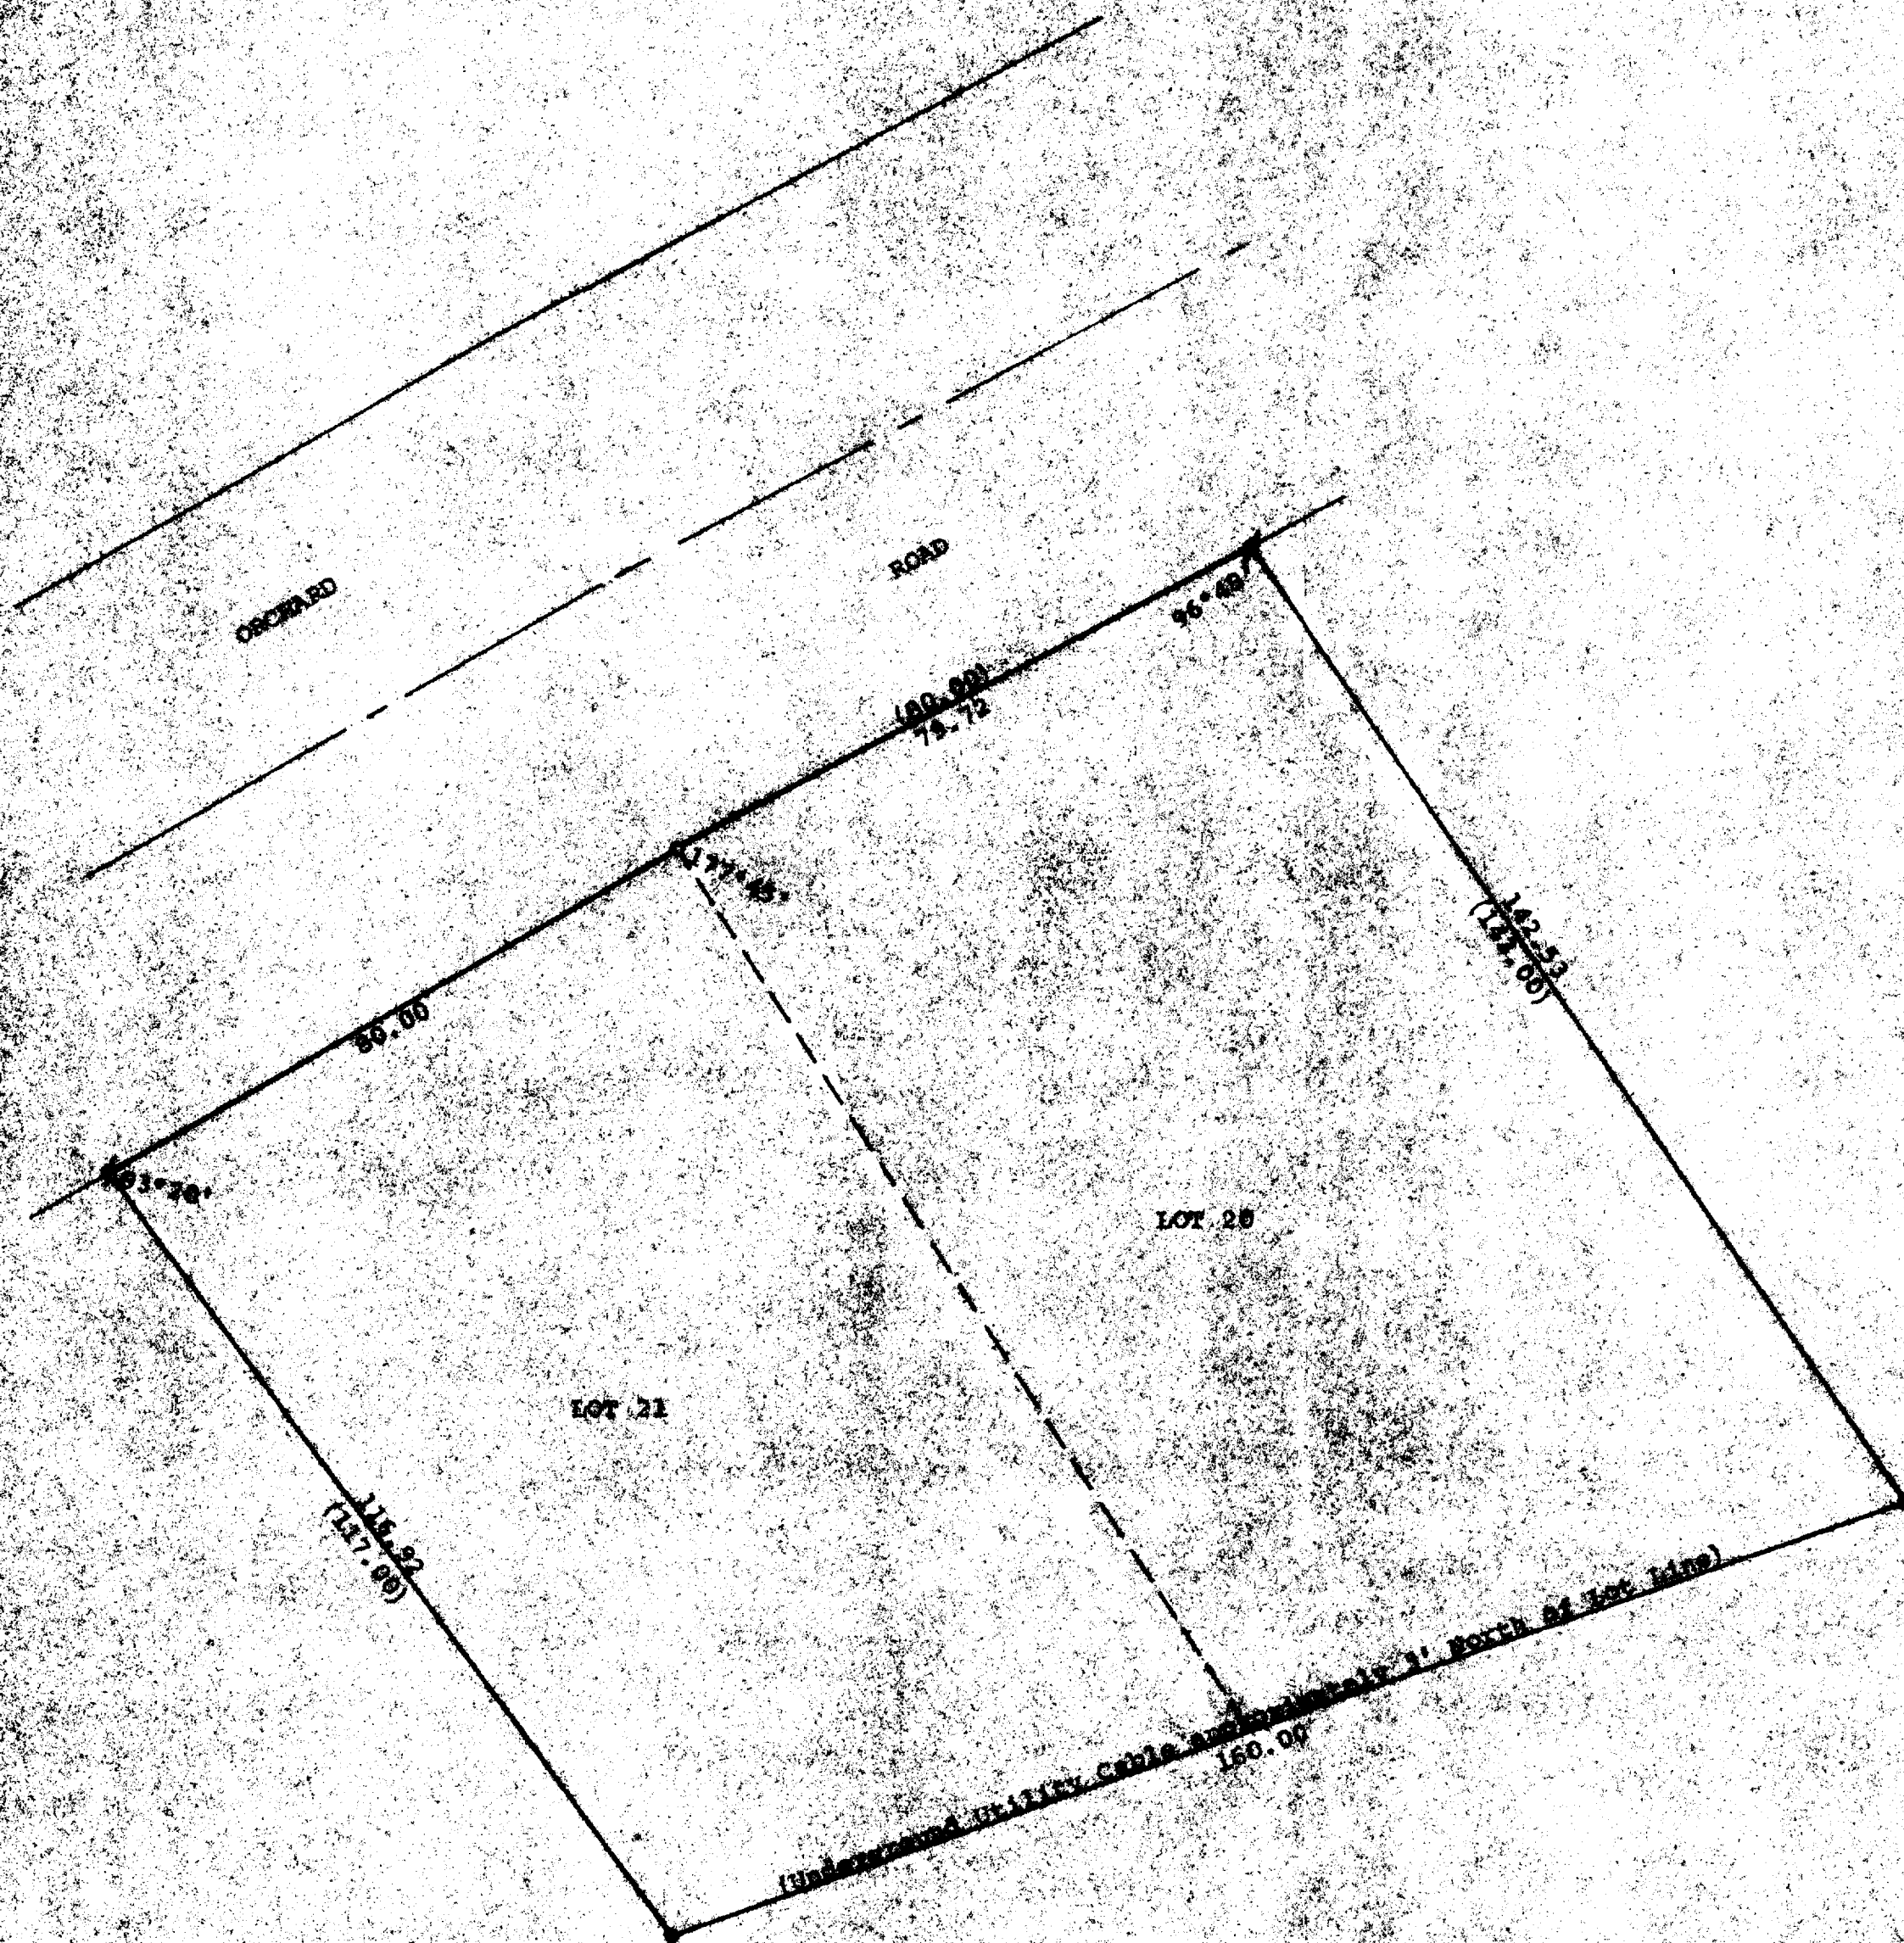

Scale - 1" = 20'
o = Iron Pipe Set
= Iron Pin Fence & Iron Pipe Set
(00.00) = Distance according to the
Recorded Plat

STATE OF WISCONSIN)
COUNTY OF WALWORTH)

I, George T. Dunham, Surveyor, certify that I have surveyed
the property described as follows:

Lots 21 and 22 in Block 18 of Wooddale Addition located in
Sections 9 and 10, T 1 N, R 12 E, Walworth County, Wisconsin,
and the above map is a true representation thereof and shows the size
and location of the property, its exterior boundaries, the location
and dimensions of all structures thereon, fences, apparent easements
and rights and visible encroachments, if any.

This survey is made for the exclusive use of the present owners of the
property, and also those who purchase, mortgage, or guarantee the
title thereto within one (1) year from date hereof, and as to them I
warrant the accuracy of said survey and map.

August 10, 1974

George T. Dunham
George T. Dunham, Surveyor

