


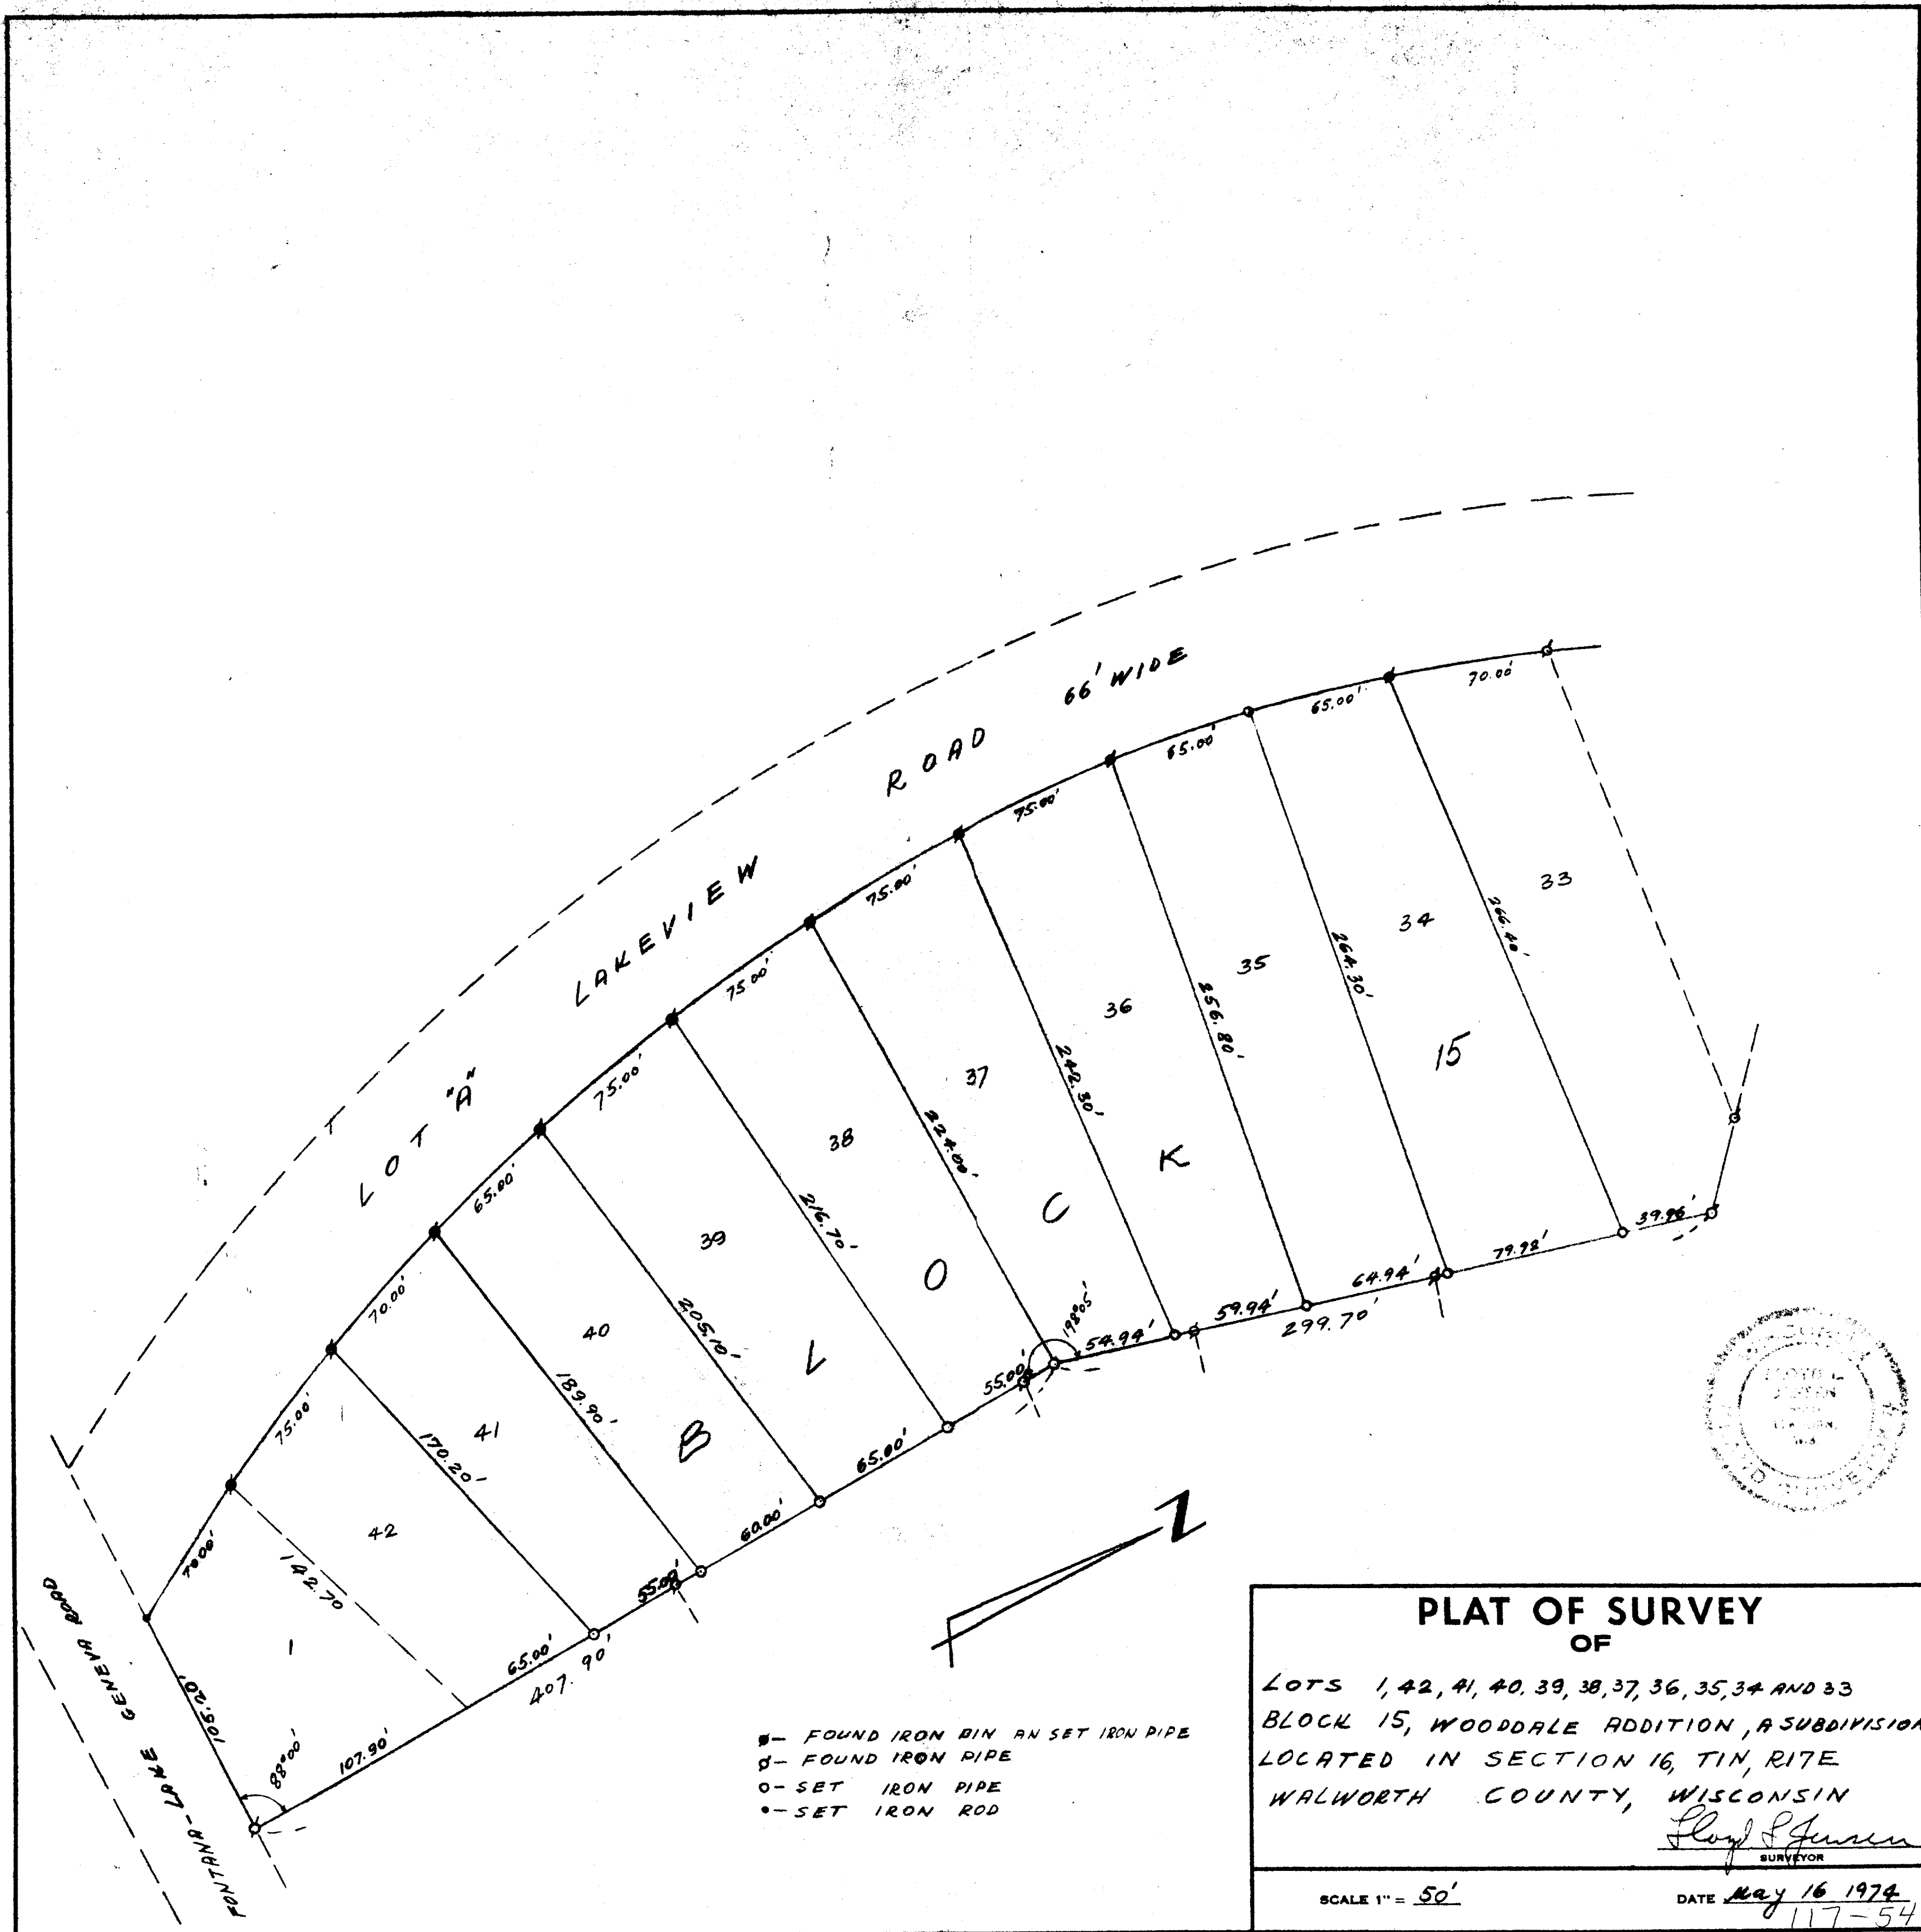

- - FOUND IRON BIN AND SET IRON PIPE
- - FOUND IRON PIPE
- - SET IRON PIPE
- - SET IRON ROD

PLAT OF SURVEY
OF
LOTS 1, 42, 41, 40, 39, 38, 37, 36, 35, 34 AND 33
BLOCK 15, WOODDALE ADDITION, A SUBDIVISION
LOCATED IN SECTION 16, T1N, R1E
WALWORTH COUNTY, WISCONSIN
Lloyd Jensen
SURVEYOR
SCALE 1" = 50'
DATE May 16 1974
117-545J