


DUNHAM SURVEYING, S.C.

SURVEYING & SUBDIVIDING
DELAVER, WISCONSIN 53115

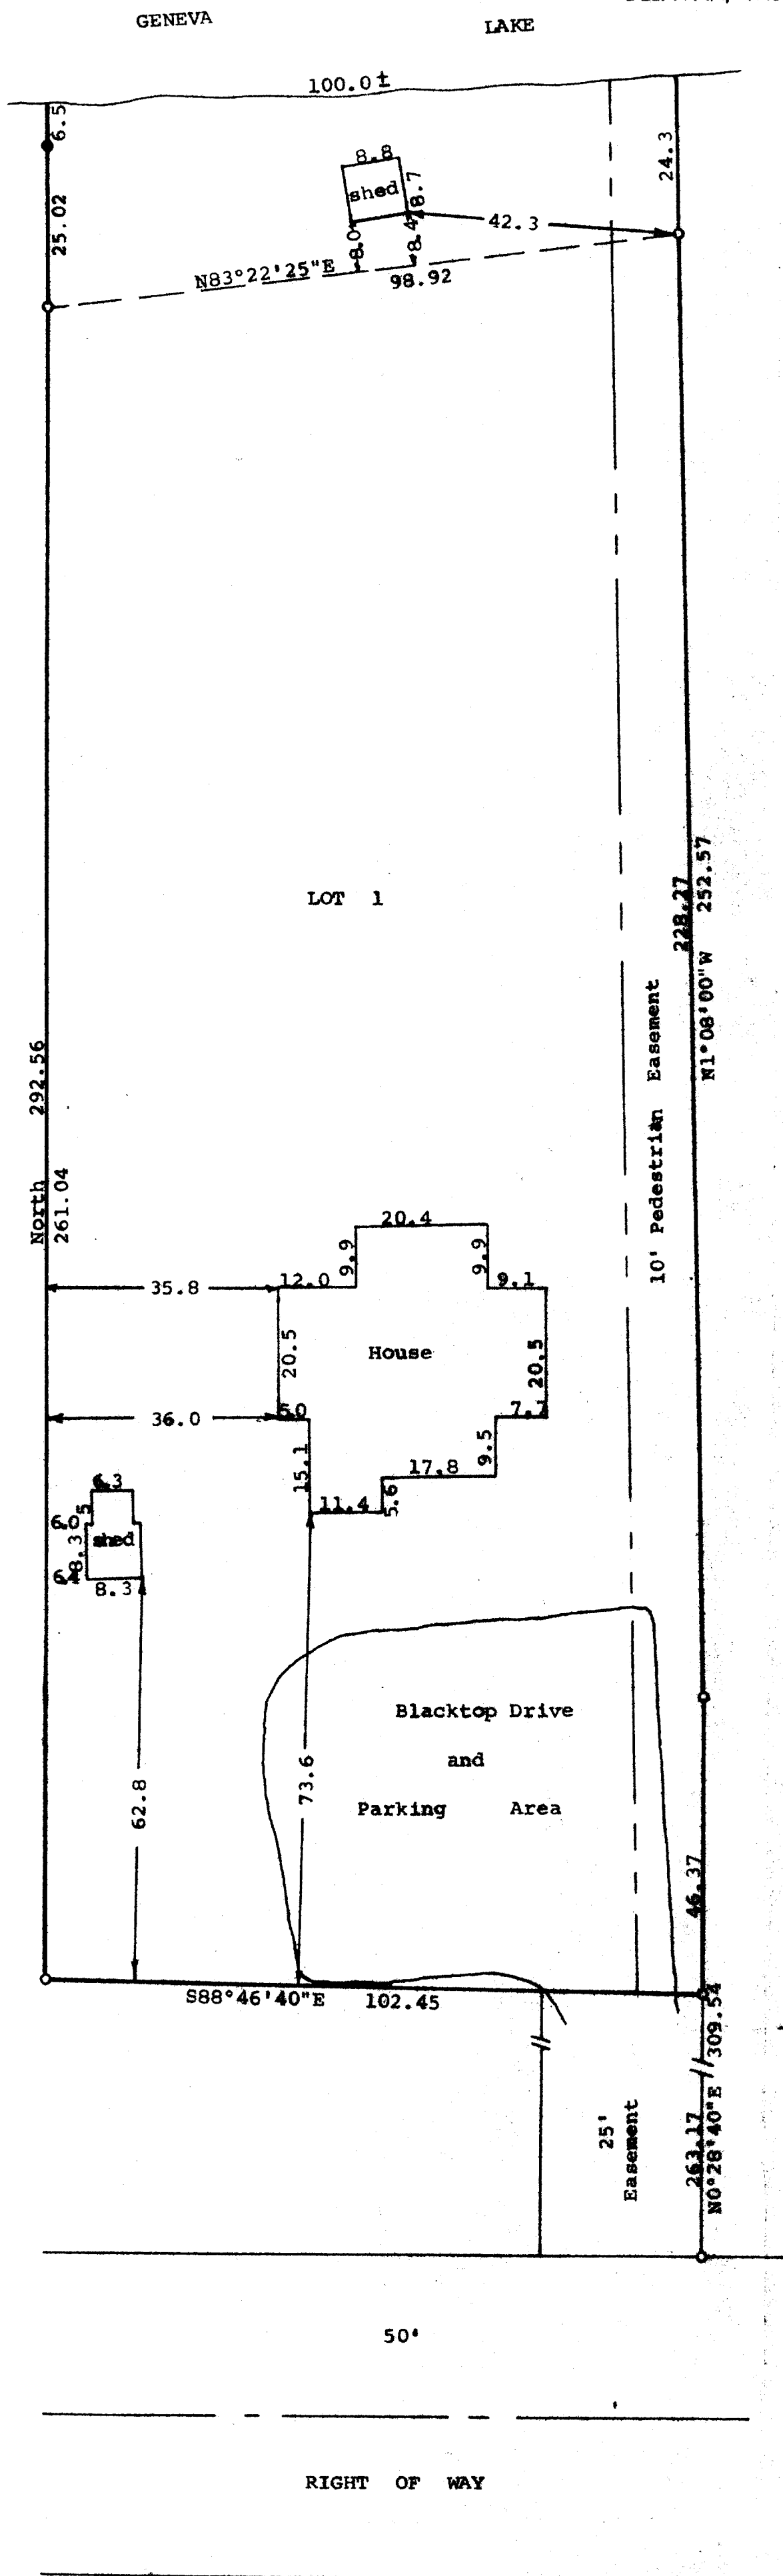

N

Scale - 1" = 20'

○ = Iron Pipe Found

● = Concrete Monument

Note: Bearings taken from Certified Survey Number 483.


STATE OF WISCONSIN)
COUNTY OF WALWORTH) SS

I, James M. Dunham, Surveyor, certify that I have surveyed the property described as follows, Lot 1 of Certified Survey No. 483 recorded in Volume 2 on page 304 of Certified Surveys at the Office of Register of Deeds, Walworth County, Wisconsin, said land being located in fractional Section 12, T1N, R17E, Walworth County, Wisconsin, and the above map is a true representation thereof and shows the size and location of the property, its exterior boundaries, the location and dimensions of all structures thereon, fences, apparent easements and roadways and visible encroachments, if any.

This survey is made for the exclusive use of the present owners of the property, and also those who purchase, mortgage, or guarantee the title thereto within one (1) year from date hereof; and as to them I warrant the accuracy of said survey and map.

April 22, 1977

James M. Dunham
James M. Dunham, Surveyor

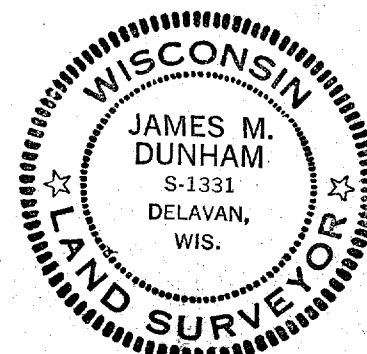

117-565