
KOLB LAND CONSULTING, INC.

LAND SURVEYING . SUBDIVIDING . LAND PLANNING

LAKE GENEVA, WISCONSIN 53147

0

WHITEWATER, WISCONSIN 53190

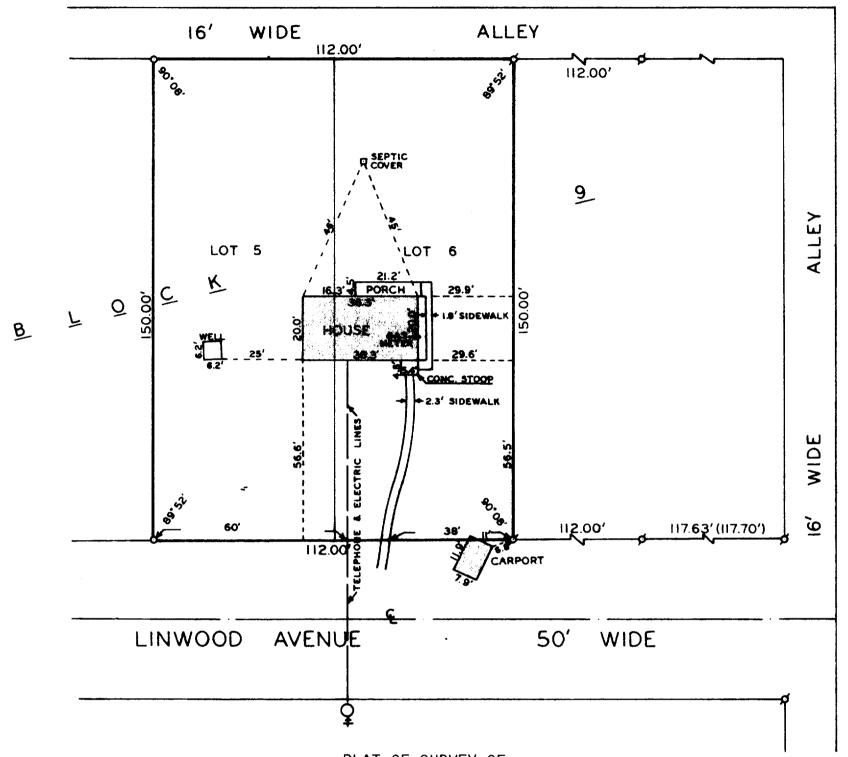

PLAT OF SURVEY OF

LOTS 5 AND 6, BLOCK 9, GENEVISTA, A SUBDIVISION LOCATED IN SECTION 10, TOWN 1 NORTH, RANGE 17 EAST, WALWORTH COUNTY, WISCONSIN.

ORDERED BY:

ROBERT JOHNSON, REALTOR 433 BROAD STREET LAKE GENEVA, WI 53147

FOR: E. SKARDA



SCALE : '1"=30'

LEGEND

- - IRON PIPE SET
- ø IRON PIPE FOUND

() - AS PLATTED



I HEREBY CERTIFY THAT I HAVE SURVEYED THE ABOVE DESCRIBED PROPERTY AND THAT THE ABOVE MAP IS A TRUE REPRESENTATION THEREOF AND SHOWS THE SIZE AND LOCATION OF THE PROPERTY, ITS EXTERIOR BOUNDARIES, THE LOCATION OF ALL PRINCIPAL BUILDINGS THEREON, BOUNDARY FENCES, APPARENT EASEMENTS, ROADWAYS AND VISIBLE ENCROACHMENTS, IF ANY.

THIS SURVEY IS MADE FOR THE USE OF THE PRESENT OWNERS OF THE PROPERTY, AND ALSO THOSE WHO PURCHASE, MORTGAGE OR GUARANTEE THE TITLE THERETO WITHIN ONE (1) YEAR FROM DATE HEREOF.

Hardel W. Holl

WISCONSIN REGISTERED LAND SURVEYOR, S-187
DATE APRIL 24, 1979

0